



MATCH LINE STA 18+590

MATCH LINE STA 18+750

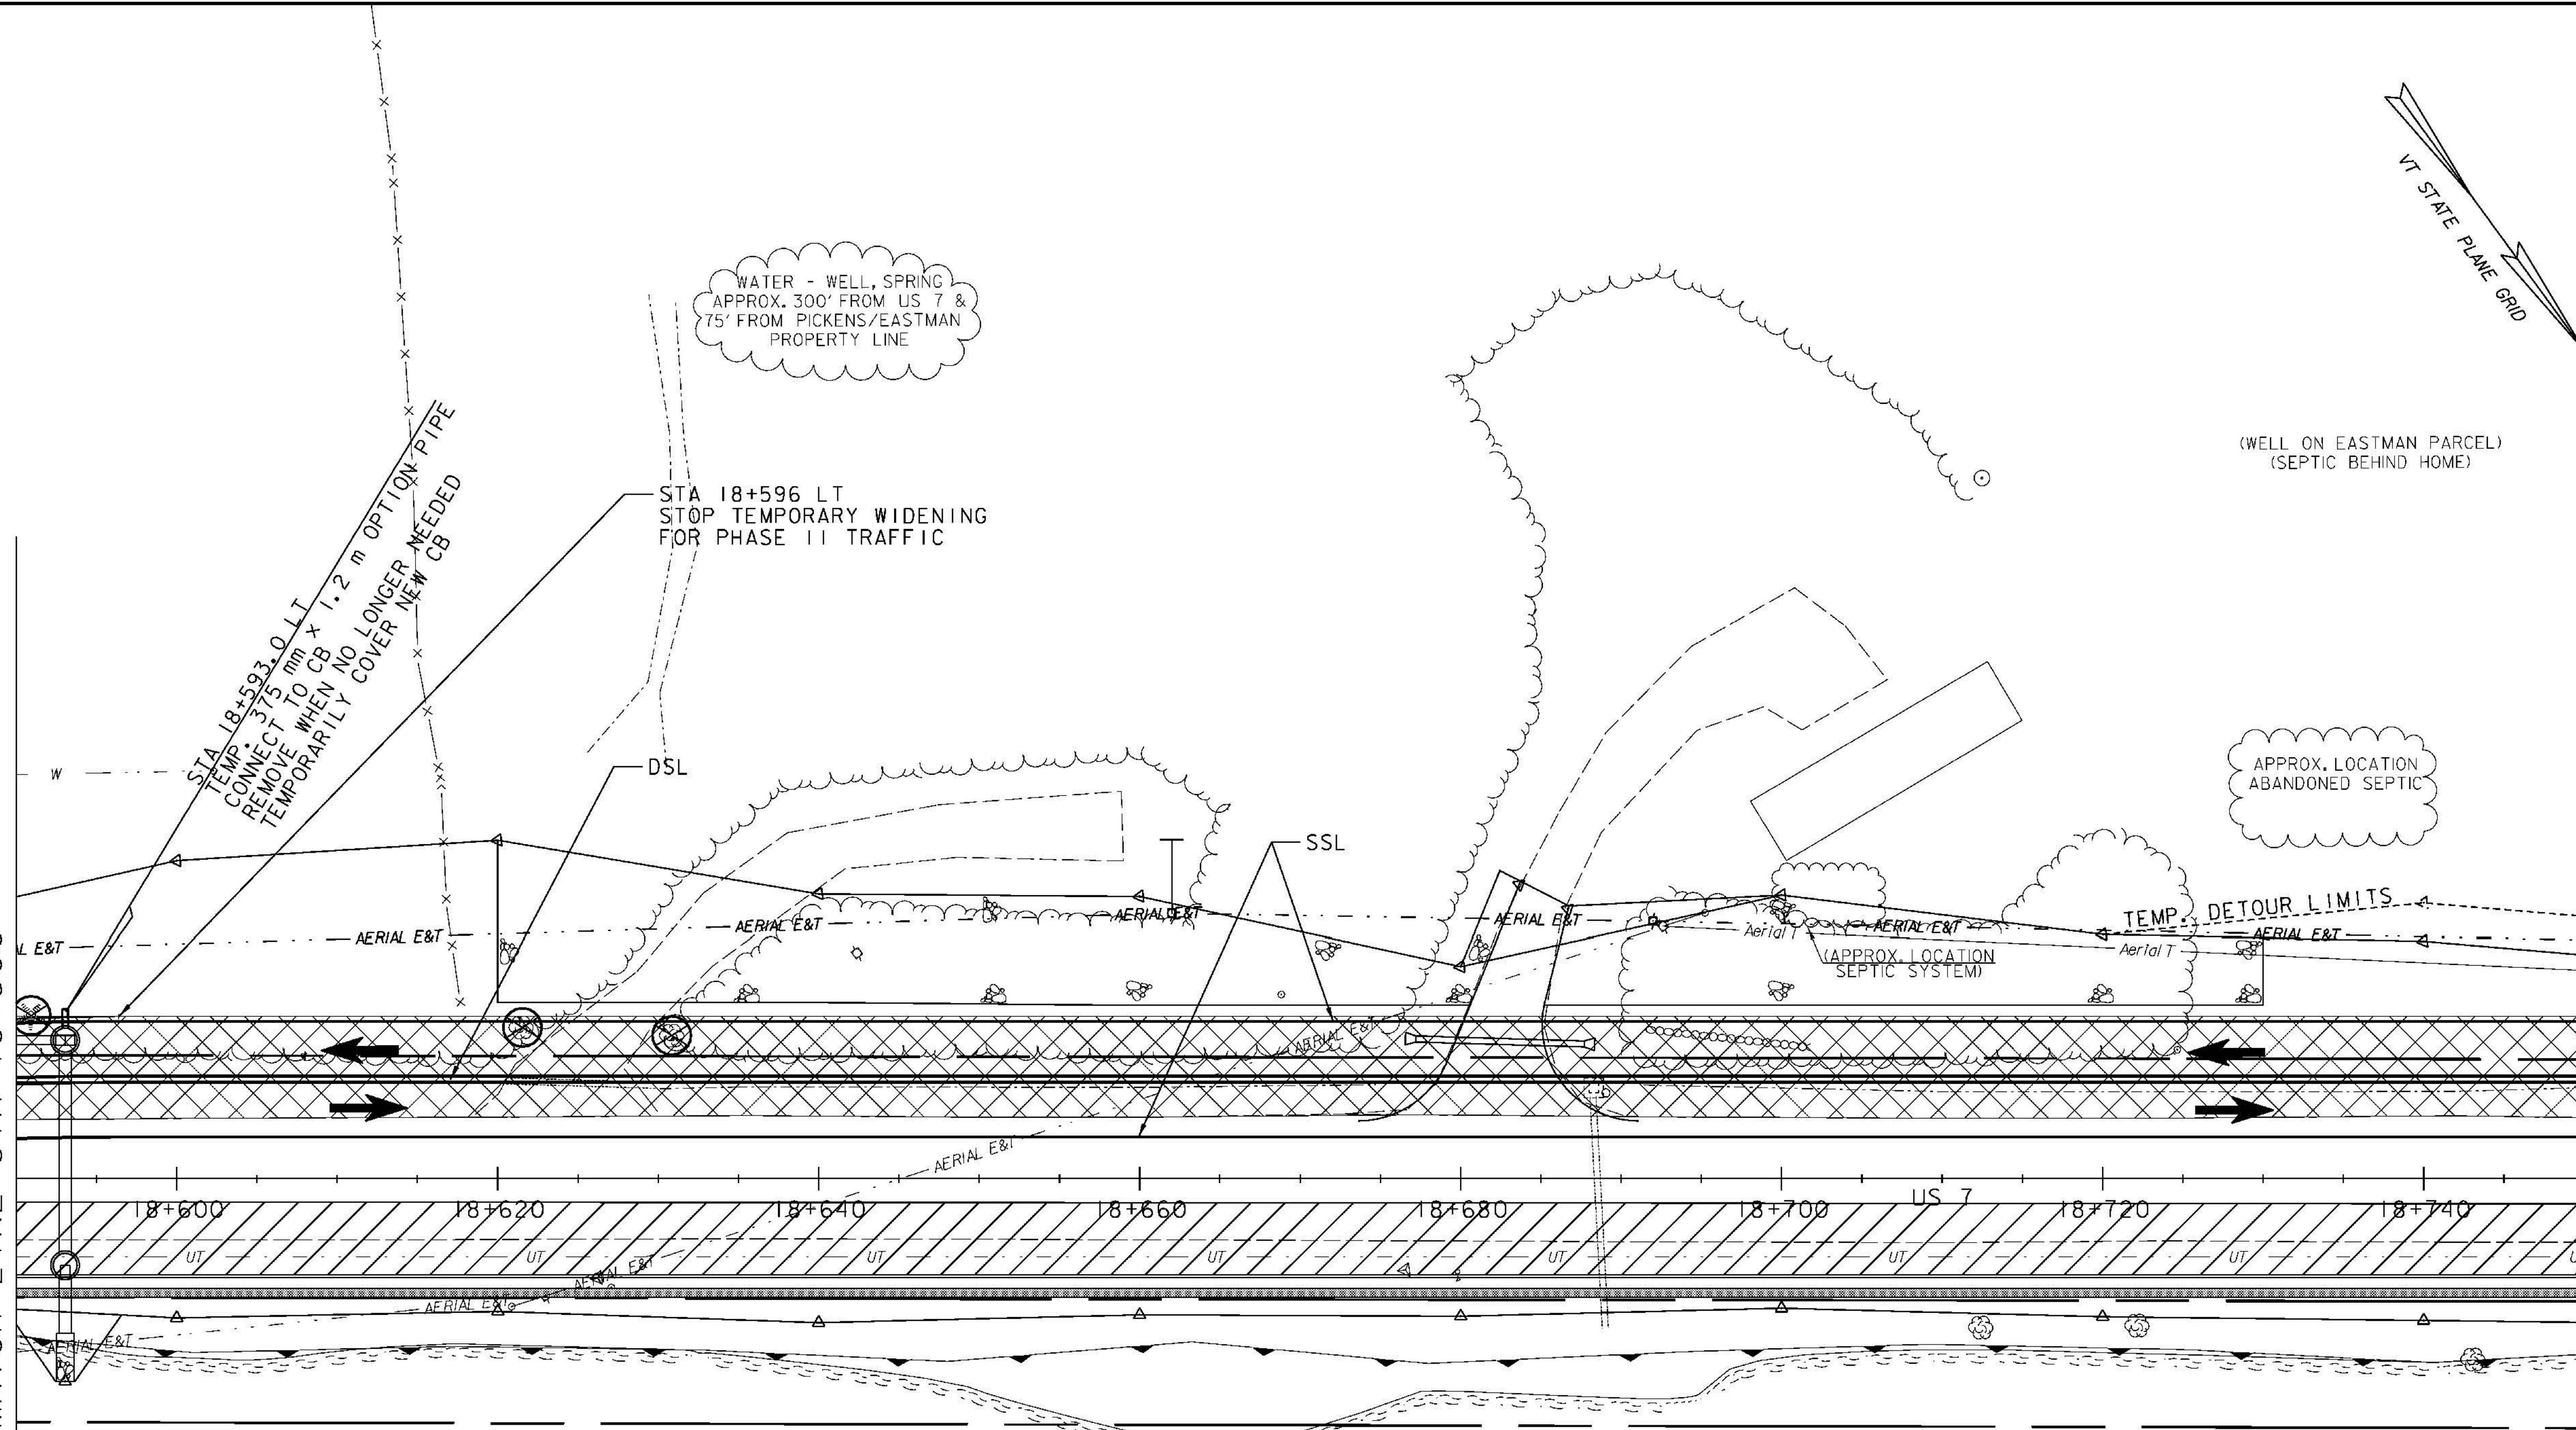

WETLAND #12  
CLASS 2  
PSSI/EMY

LEGEND	
	PHASE I CONSTRUCTION
	TEMPORARY WIDENING FOR PHASE I TRAFFIC
	TEMPORARY WIDENING FOR PHASE II TRAFFIC
	PHASE I TRAFFIC
SSL	SINGLE SOLID WHITE LINE 100mm WIDE (PAINT)
DSL	DOUBLE SOLID YELLOW LINE 100mm WIDE (PAINT)

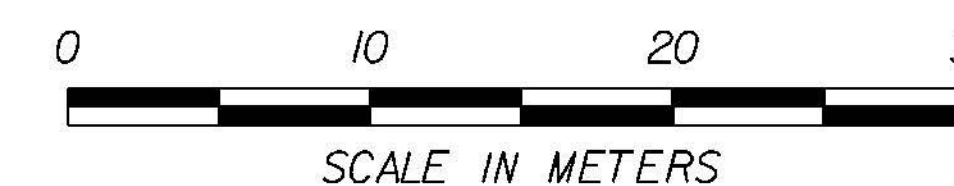

PHASE I  
TRAFFIC CONTROL PLAN 15

PROJECT NAME: BRANDON	PLOT DATE: 9/3/2009
PROJECT NUMBER: NH 019-3(495)	DRAWN BY: NLL
FILE NAME: zb008s5+tpl5.dgn	CHECKED BY: KLS
PROJECT LEADER: CRB	SHEET 296 OF 546
DESIGNED BY: PTS	
CLD 02-0149	