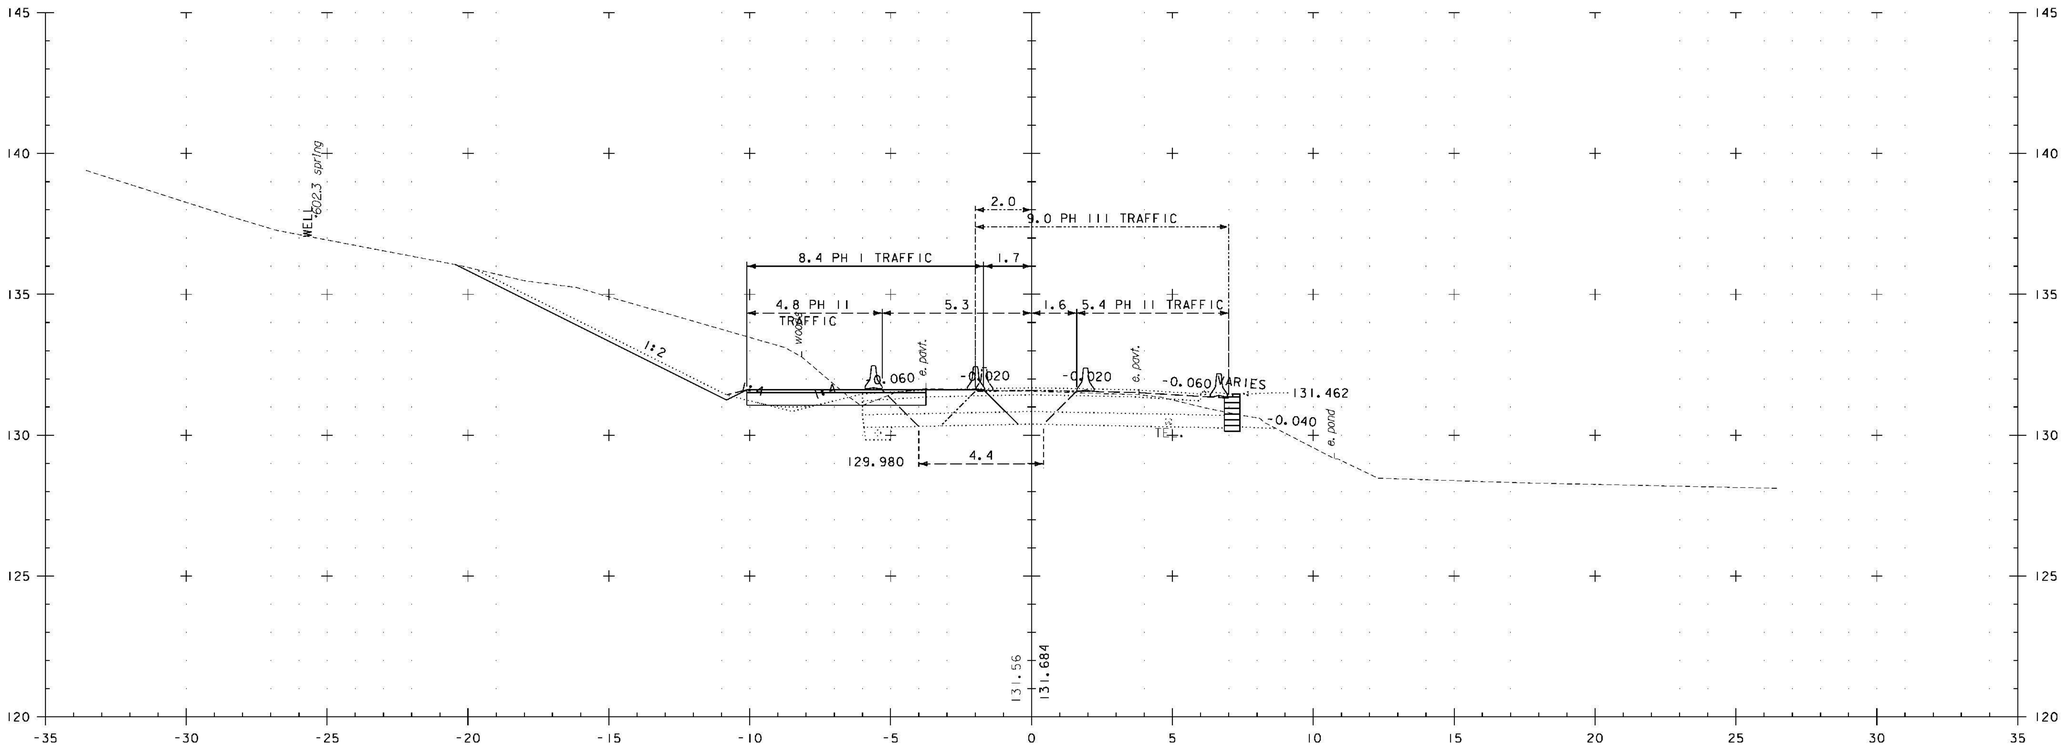

18+600.0

0 2 4 6 8 10
SCALE IN METERS

TRAFFIC CONTROL CROSS SECTIONS PHASE I, PHASE II AND PHASE III

PROJECT NAME: BRANDON
PROJECT NUMBER: NH 019-3(495)

FILE NAME: zb008s5-tcpxs077.dgn
PROJECT LEADER: CRB
DESIGNED BY: PTS
CLD 02-0149

PLOT DATE: 9/3/2009
DRAWN BY: NLL
CHECKED BY: KLS
SHEET 363 OF 546