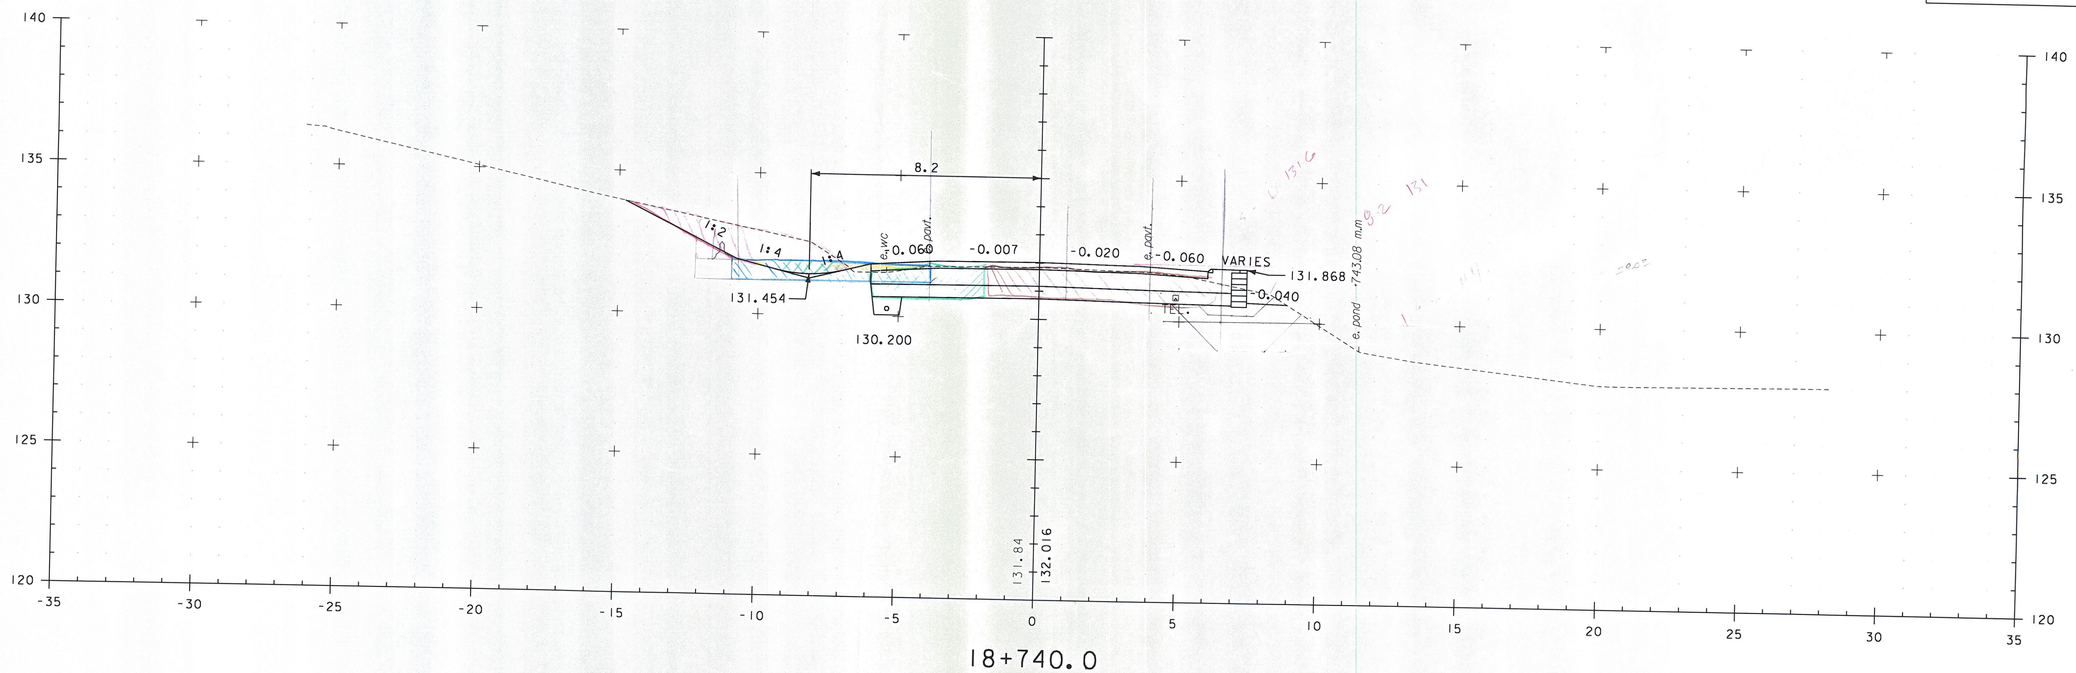

18+740.0

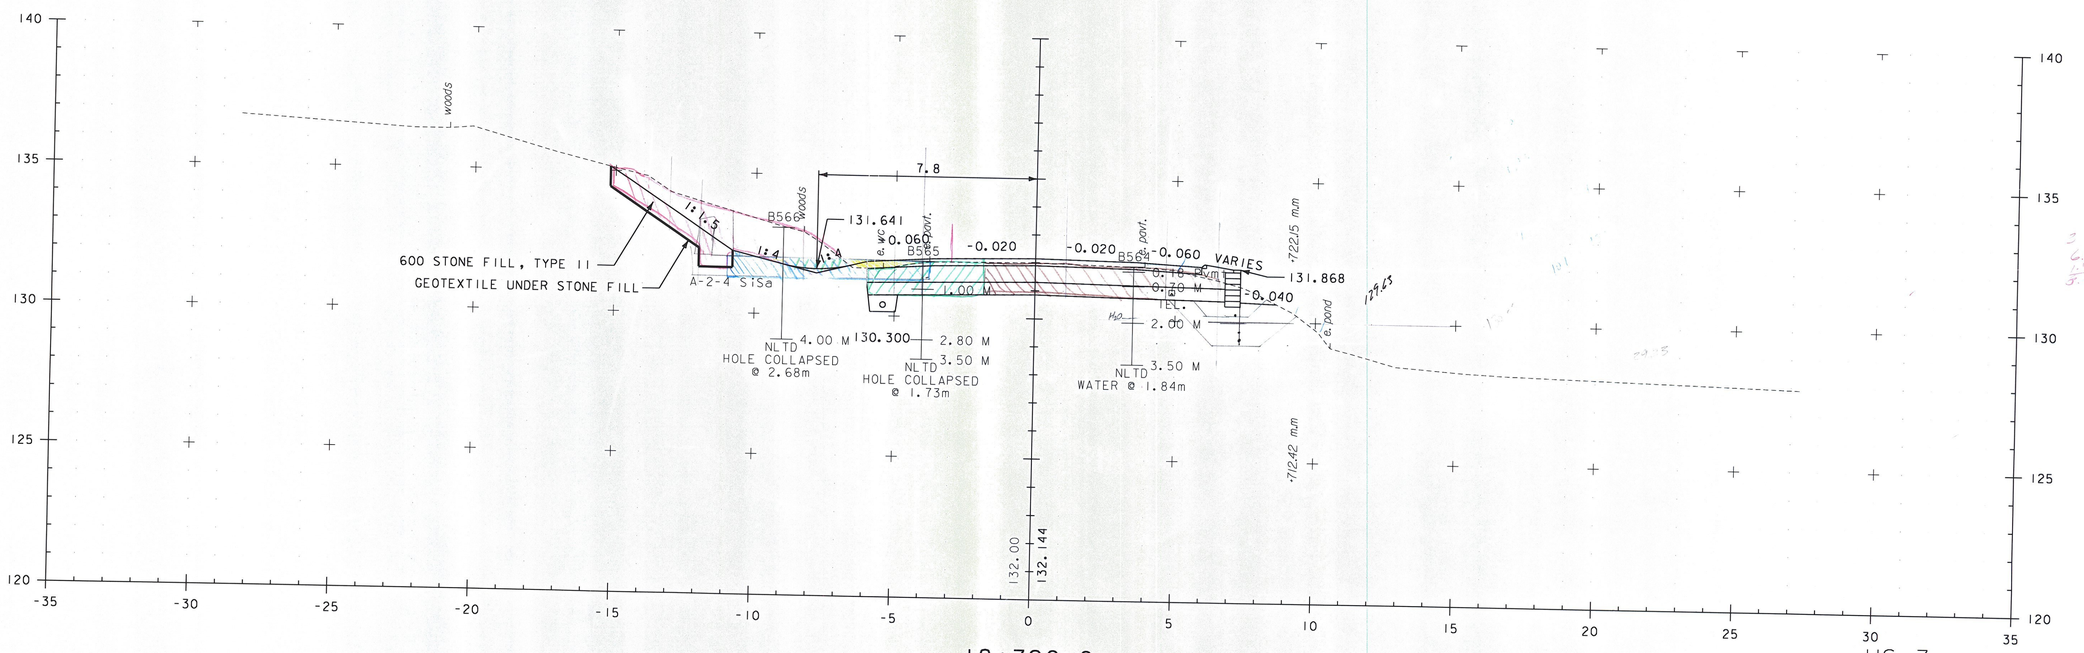

18+720.0

US 7

0 2 4 6 8 10
SCALE IN METERS

PROJECT NAME: BRANDON	
PROJECT NUMBER: NH 019-3(495)	
FILE NAME: zb008s5-xs083.dgn	PLOT DATE: 9/3/2009
PROJECT LEADER: CRB	DRAWN BY: NLL
DESIGNED BY: PTS	CHECKED BY: DAM
CLD 02-0149	SHEET 464 OF 546