



20+620.0  
DRIVE RT

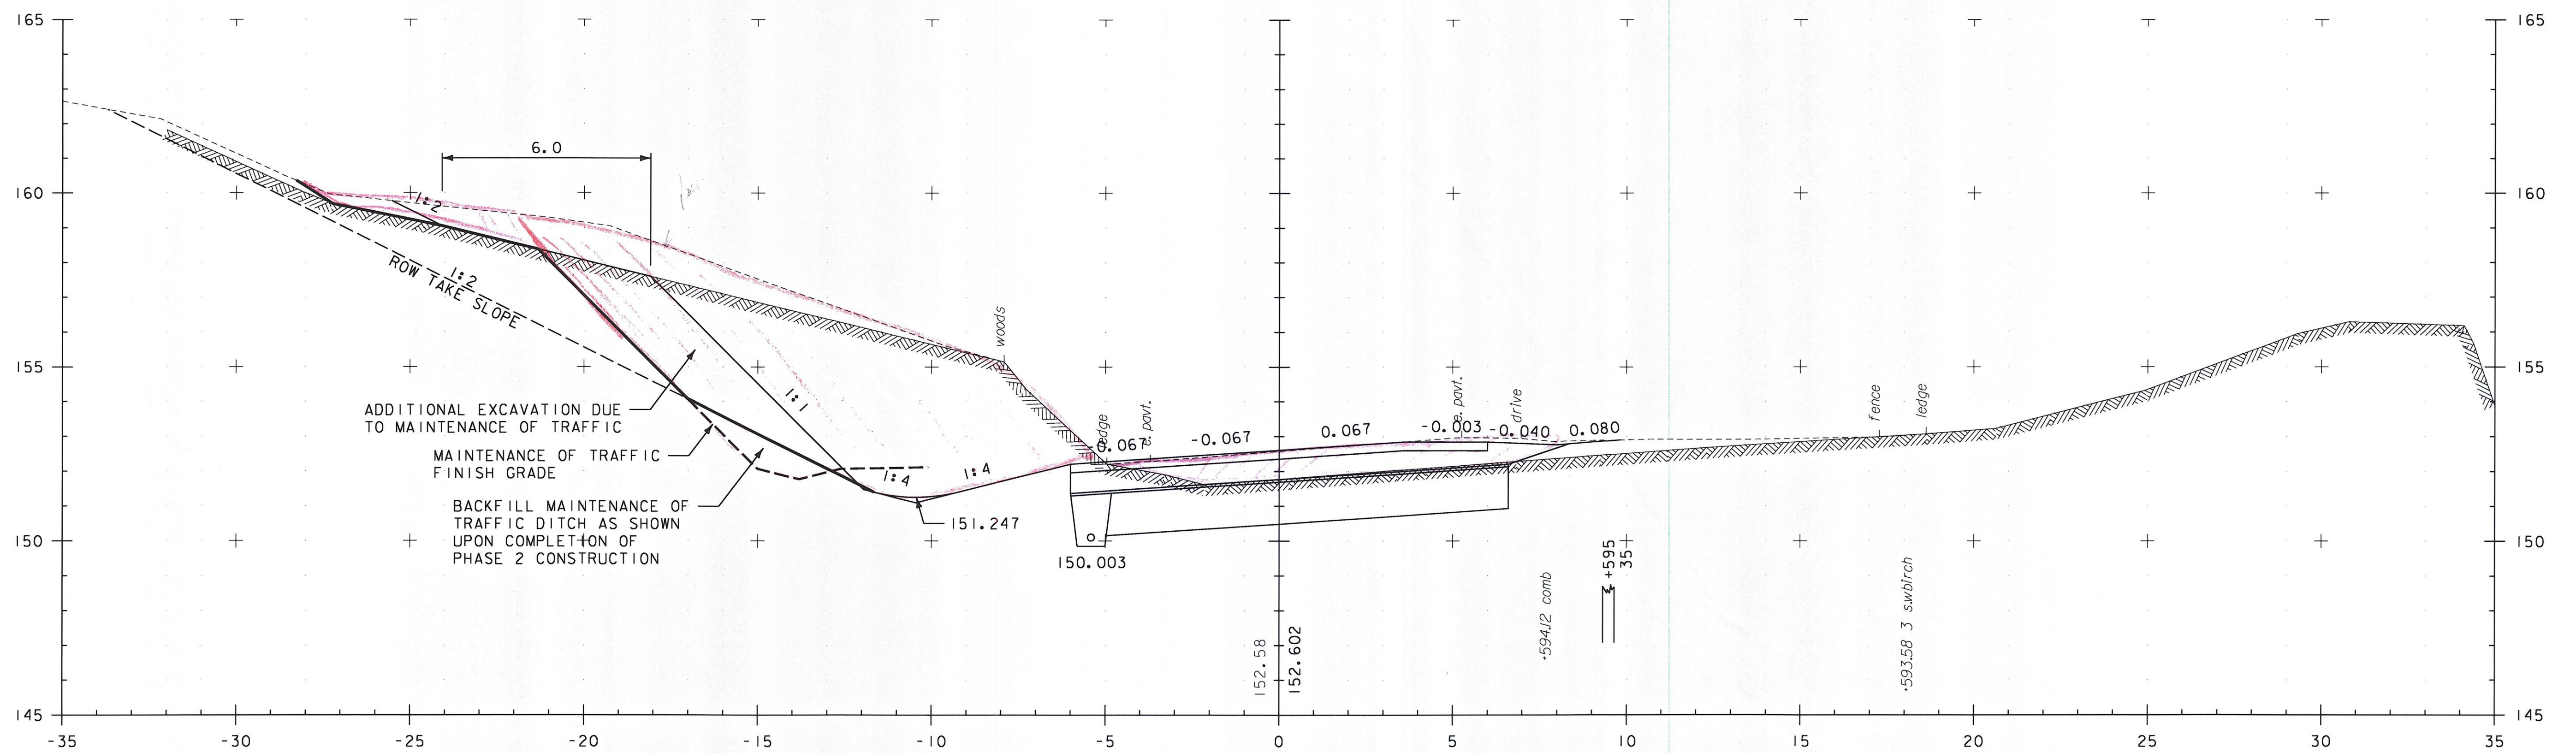

20+600.0

US 7

ADDITIONAL EXCAVATION DUE TO MAINTENANCE OF TRAFFIC  
 MAINTENANCE OF TRAFFIC FINISH GRADE  
 BACKFILL MAINTENANCE OF TRAFFIC DITCH AS SHOWN UPON COMPLETION OF PHASE 2 CONSTRUCTION

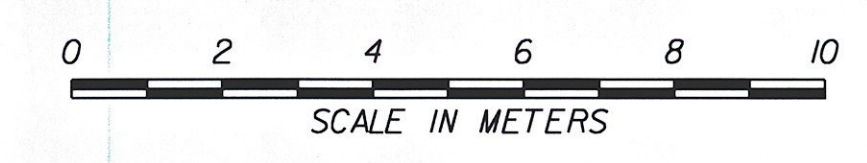

PROJECT NAME: BRANDON	PLOT DATE: 9/3/2009
PROJECT NUMBER: NH 019-3(495)	DRAWN BY: NLL
FILE NAME: zb008s5-xs264.dgn	CHECKED BY: DAM
PROJECT LEADER: CRB	SHEET 535 OF 546
DESIGNED BY: PTS	
CLD 02-0149	