STONE FILL, TYPE I (IN DITCHES)
GEOTEXTILE UNDER STONE FILL
STA 17+800 - 17+830 LT

TEMPORARY STONE CHECK DAM, TYPE I
STA 17+870 - 17+950 LT

INLET PROTECTION DEVICE, TYPE I
STA 17+815 LT
STA 17+900 RT
STA 17+939 RT

TEMPORARY EROSION MATTING (IN DITCHES)
STA 17+870 - 17+950 LT
STA 17+910 - 17+938 RT

GEOTEXTILE FOR SILT FENCE
STA 17+797 - 17+814 RT
STA 17+825 - 17+830 RT
STA 17+836 - 17+861 RT
STA 17+927 - 17+928 RT

PROJECT DEMARCATION FENCE
STA 17+790 - 17+950 LT
STA 17+840 - 17+865 RT
STA 17+872 - 17+902 RT
STA 17+909 - 17+940 RT
STA 17+946 - 17+950 RT

BARRIER FENCE
STA 17+790 - 17+805 RT
STA 17+820 - 17+840 RT

VT STATE PLANE GRID N

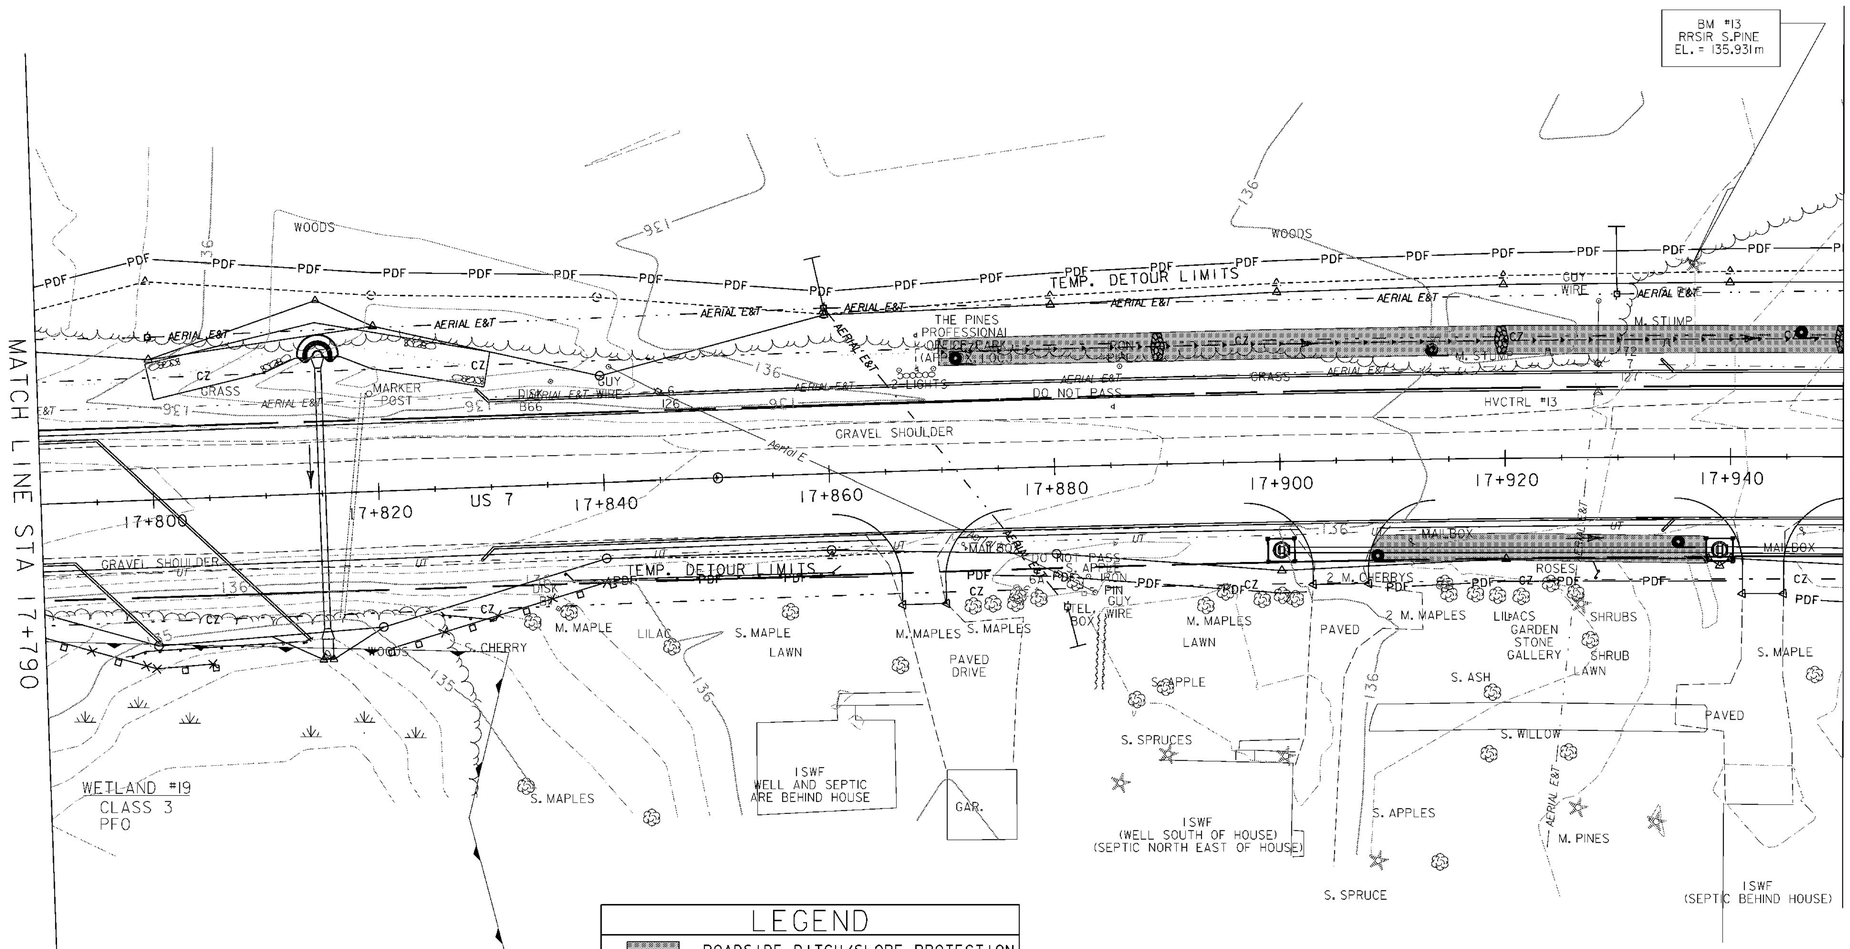

LEGEND

- ROADSIDE DITCH/SLOPE PROTECTION
- DETOUR SLOPE LIMITS
- PERMANENT SLOPE LIMITS
- SILT FENCE
- INLET PROTECTION DEVICE, TYPEI
- PIPE INLET PROTECTION
- EROSION MATTING
- CHECK DAM - TEMPORARY
- BARRIER FENCE
- PDF — PROJECT DEMARCATION FENCE
- FILTER CURTAIN

NOTES:

1. SILT FENCE LOCATIONS SHOWN ON THIS DRAWING ARE APPROXIMATE. THE CONTRACTOR IS RESPONSIBLE FOR INSTALLING THE SILT FENCE IN ACCORDANCE WITH THE GUIDELINES SET FORTH IN THE VERMONT GENERAL PERMIT FOR STORMWATER RUNOFF FROM CONSTRUCTION SITES. THE RESIDENT ENGINEER AND ON SITE COORDINATOR SHALL APPROVE ALL SILT FENCE LOCATIONS PRIOR TO PLACEMENT.
2. FOR EROSION PREVENTION AND SEDIMENT CONTROL PLAN GENERAL NOTES, SEE SHEETS 147 - 148, AND DETAILS, SEE SHEETS 177 - 180.

0 10 20 30
SCALE IN METERS

EROSION CONTROL PLAN 10

PROJECT NAME: BRANDON
PROJECT NUMBER: NH 019-3(495)

FILE NAME: zb008s5-ec10.dgn
PROJECT LEADER: CRB
DESIGNED BY: NLL
CLD 02-0149

PLOT DATE: 9/3/2009
DRAWN BY: NLL
CHECKED BY: PTS
SHEET 158 OF 546