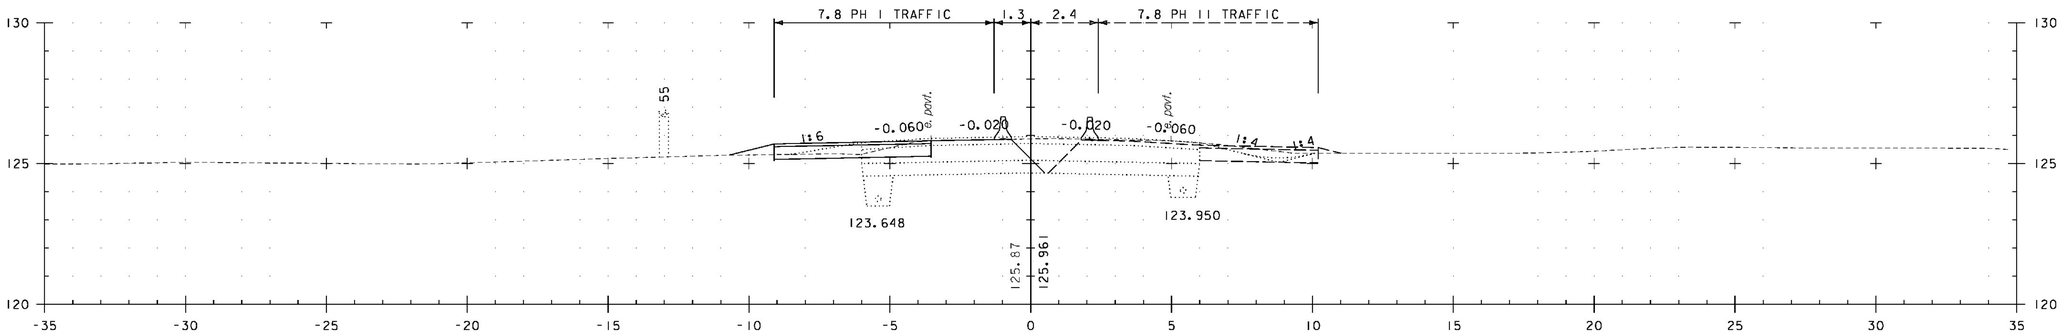

19+400.0

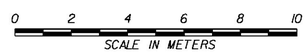

TRAFFIC CONTROL CROSS SECTIONS PHASE I AND PHASE II

PROJECT NAME: BRANDON	
PROJECT NUMBER: NH 019-3(495)	
FILE NAME: zb008s5-tcpxs208.dgn	PLOT DATE: 9/3/2009
PROJECT LEADER: CRB	DRAWN BY: NLL
DESIGNED BY: PTS	CHECKED BY: KLS
CLD 02-0149	SHEET 369 OF 546