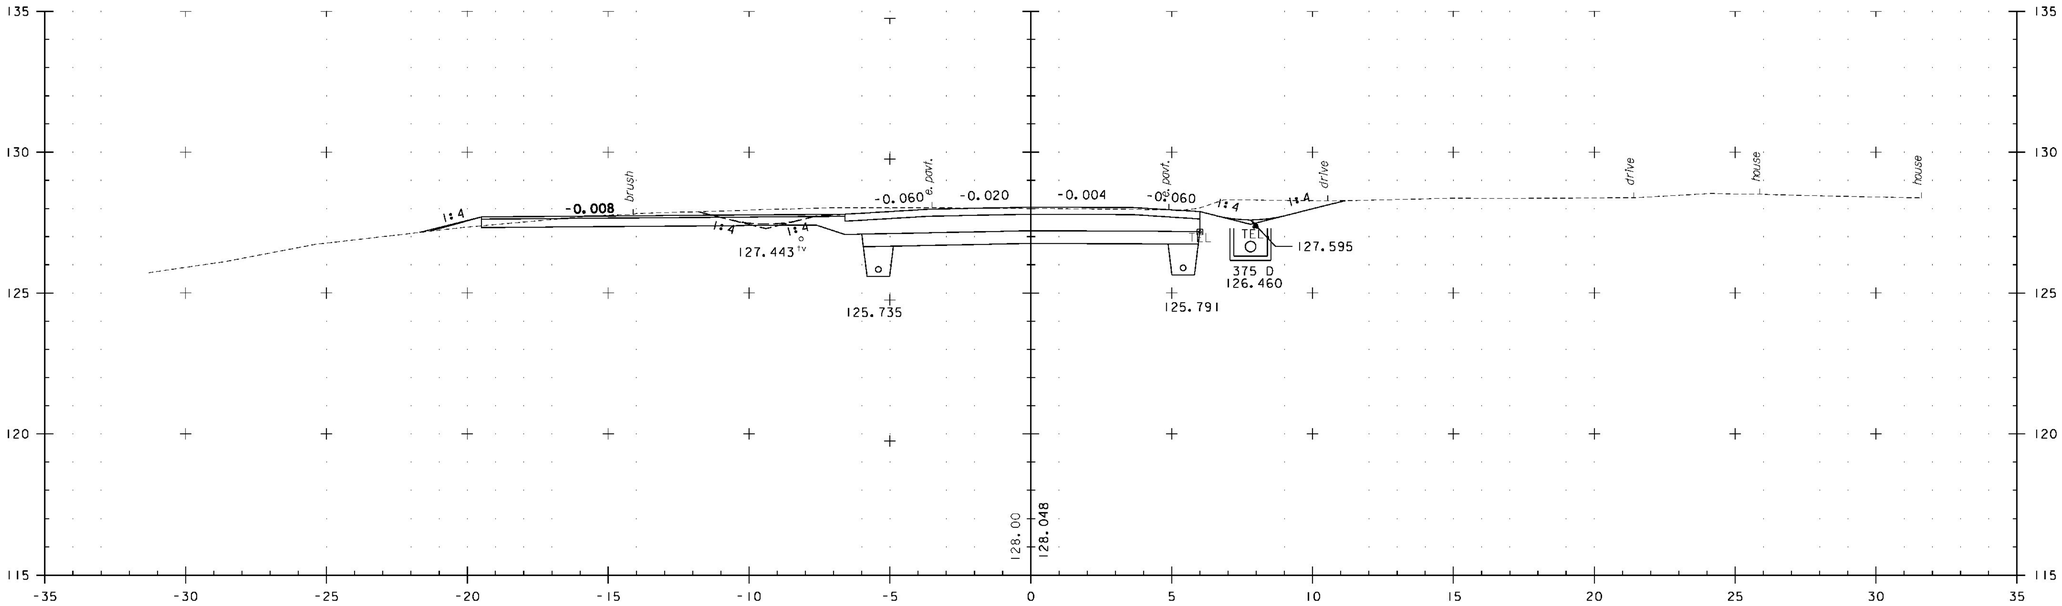


17+100.0

US 7

| | |
|---|---|
| PROJECT NAME: BRANDON | |
| PROJECT NUMBER: NH 019-3(495) | |
| FILE NAME: zb008s5-xs026.dgn | PLOT DATE: 9/3/2009 |
| PROJECT LEADER: CRB | DRAWN BY: NLL |
| DESIGNED BY: PTS | CHECKED BY: DAM |
| CLD 02-0149 | SHEET 407 OF 546 |

0 2 4 6 8 10
SCALE IN METERS