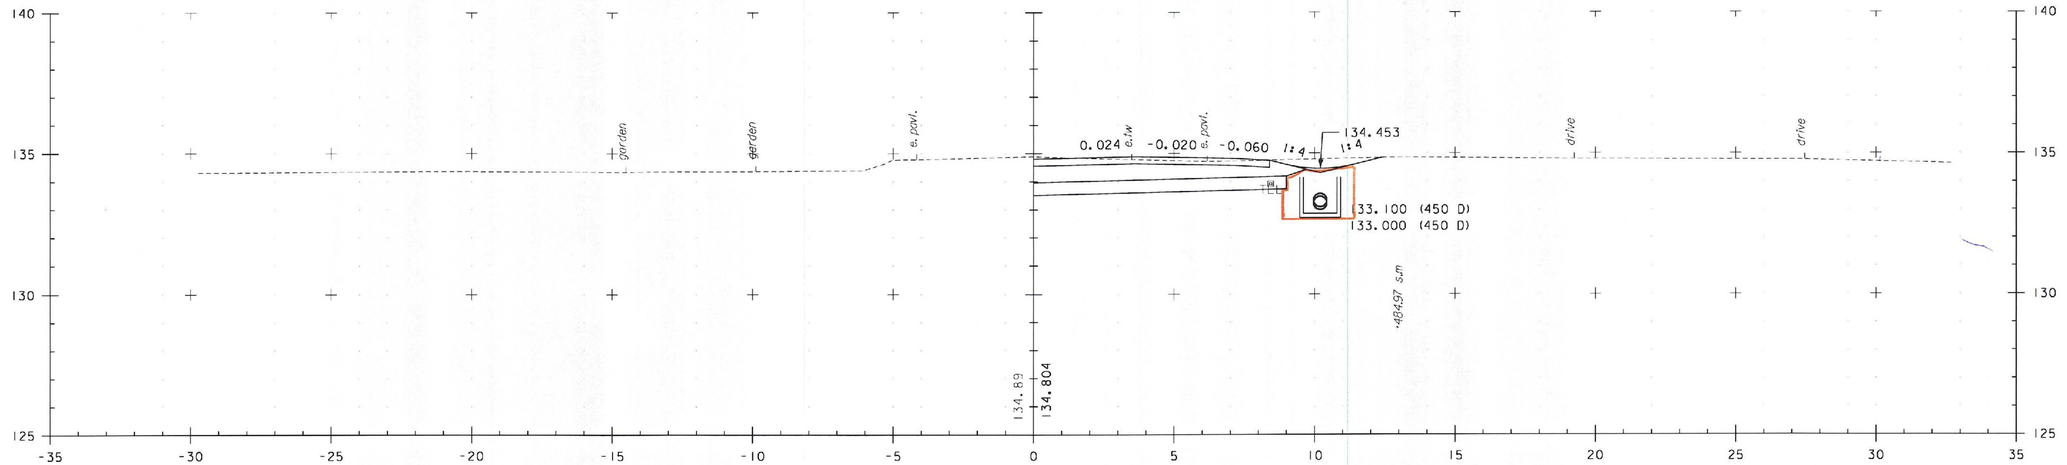

17+485.0

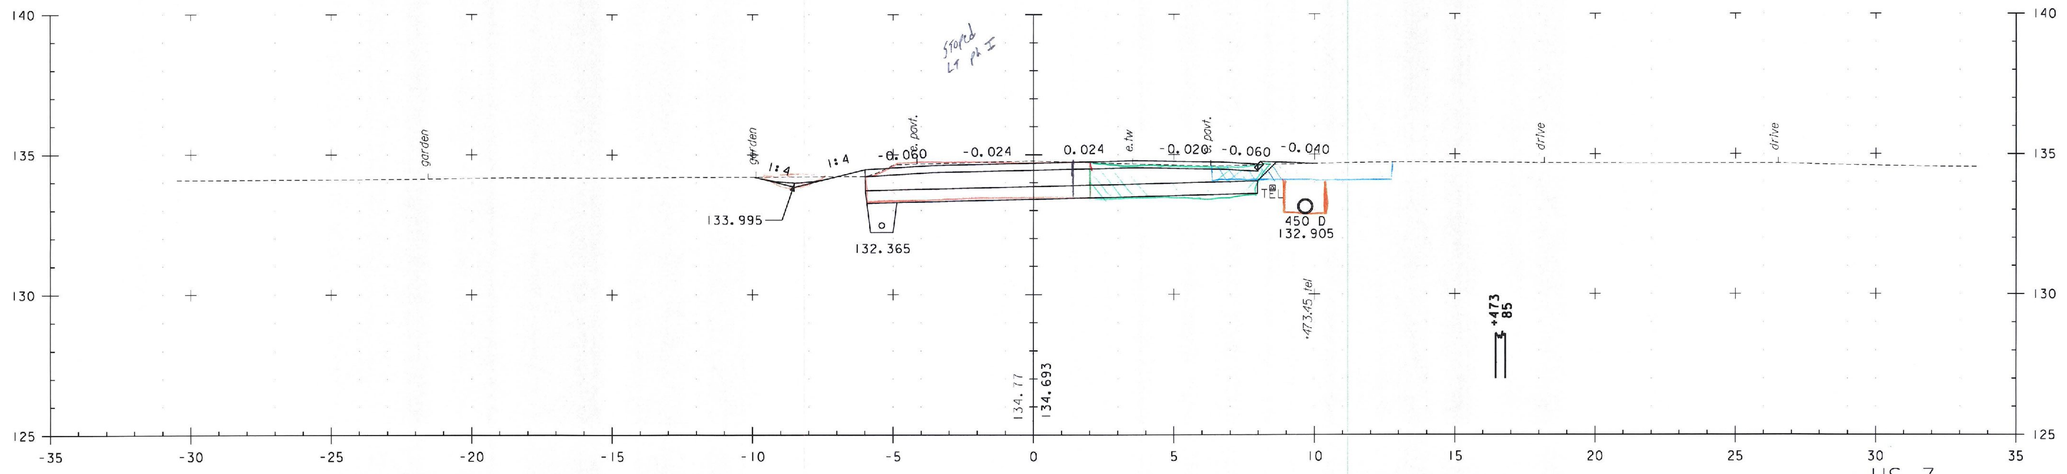

17+480.0

US 7

PROJECT NAME:	BRANDON
PROJECT NUMBER:	NH 019-3(495)

FILE NAME: zb008s5-xs039.dgn	PLOT DATE: 9/3/2009
PROJECT LEADER: CRB	DRAWN BY: NLL
DESIGNED BY: PTS	CHECKED BY: DAM
CLD 02-0149	SHEET 420 OF 546

0 2 4 6 8 10
SCALE IN METERS