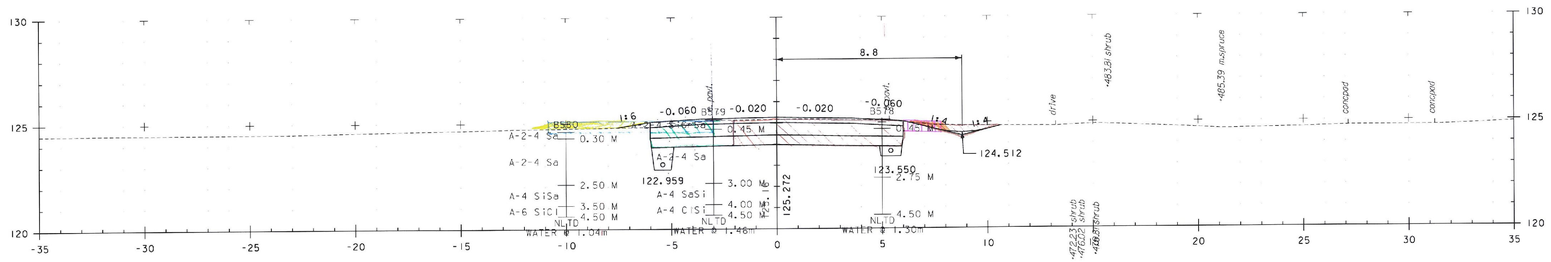

19+480.0

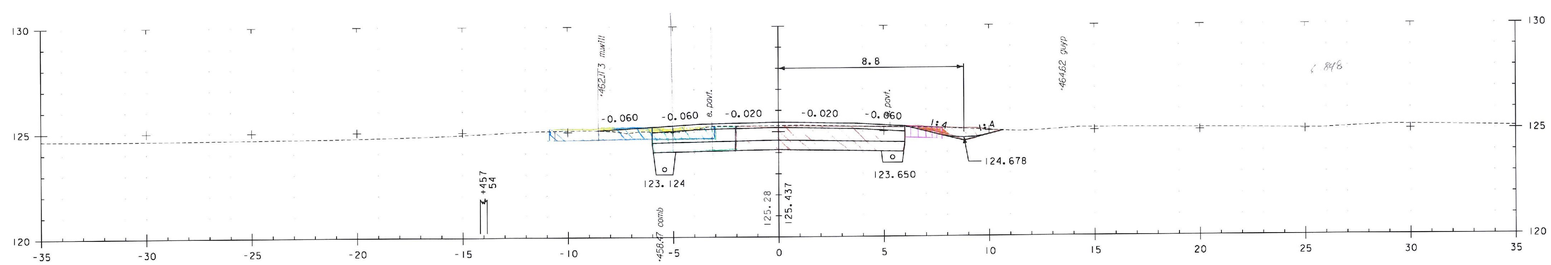

19+460.0

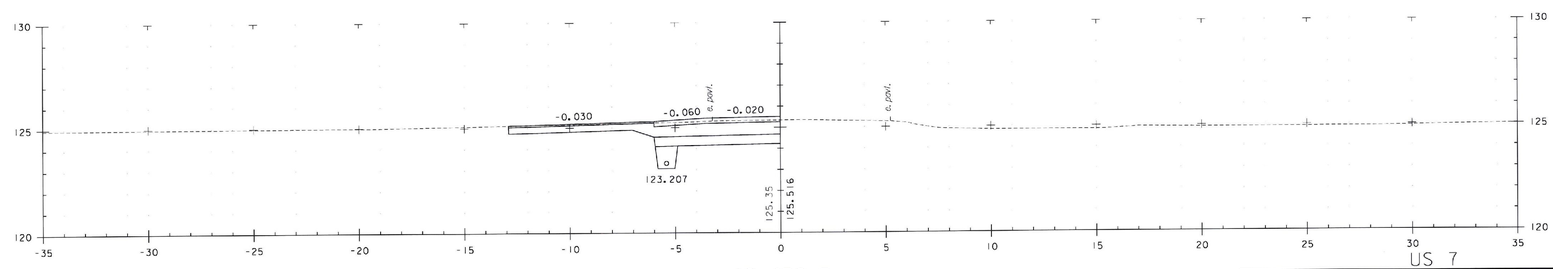

19+450.5
DRIVE LT

US 7

0 2 4 6 8 10
SCALE IN METERS

PROJECT NAME: BRANDON
PROJECT NUMBER: NH 019-3(495)

FILE NAME: zb008s5-xs209.dgn
PROJECT LEADER: CRB
DESIGNED BY: PTS
CLD 02-0149

PLOT DATE: 9/3/2009
DRAWN BY: NLL
CHECKED BY: DAM
SHEET 480 OF 546