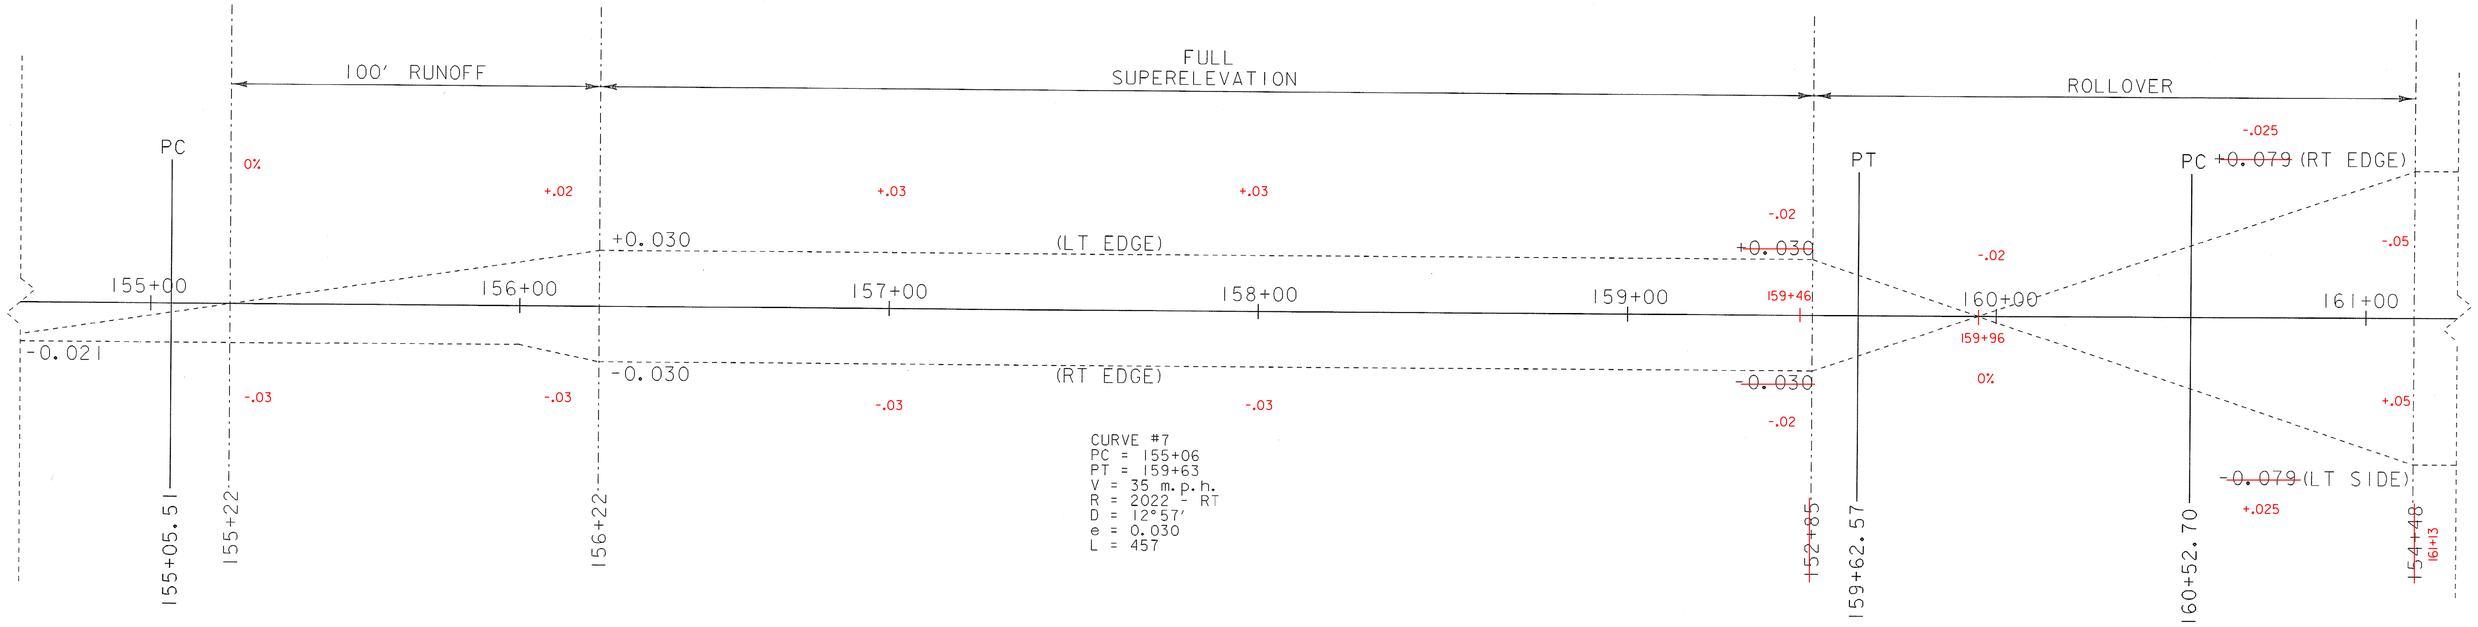

CURVE #7
PC = 155+06
PT = 159+63
V = 35 m.p.h.
R = 2022' - RT
D = 12°57'
e = 0.030
L = 457

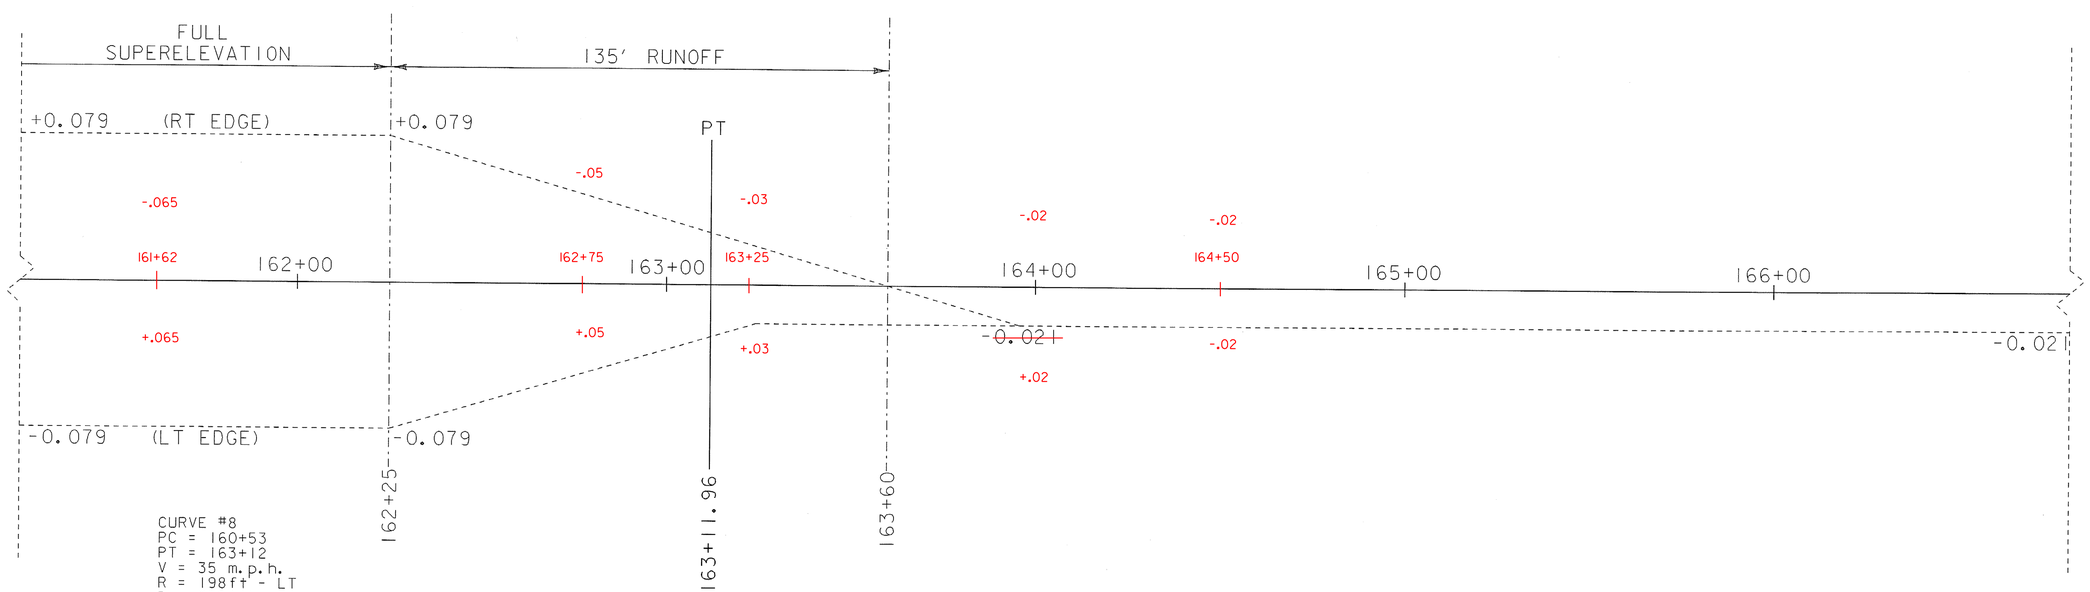

CURVE #8
PC = 160+53
PT = 163+12
V = 35 m.p.h.
R = 198ft - LT
D = 75°11'
e = 0.079
L = 259

0 20 40
SCALE IN FEET

PROJECT NAME: SPRINGFIELD	
PROJECT NUMBER: STP 0136(1)	
FILE NAME: Bank.dgn	PLOT DATE: 30-DEC-2008
PROJECT LEADER: K. UPMAL	DRAWN BY: B. KIPP
DESIGNED BY: B. KIPP	CHECKED BY: N. PAPPAS
BANKING DIAGRAM 3	SHEET 50 OF 68