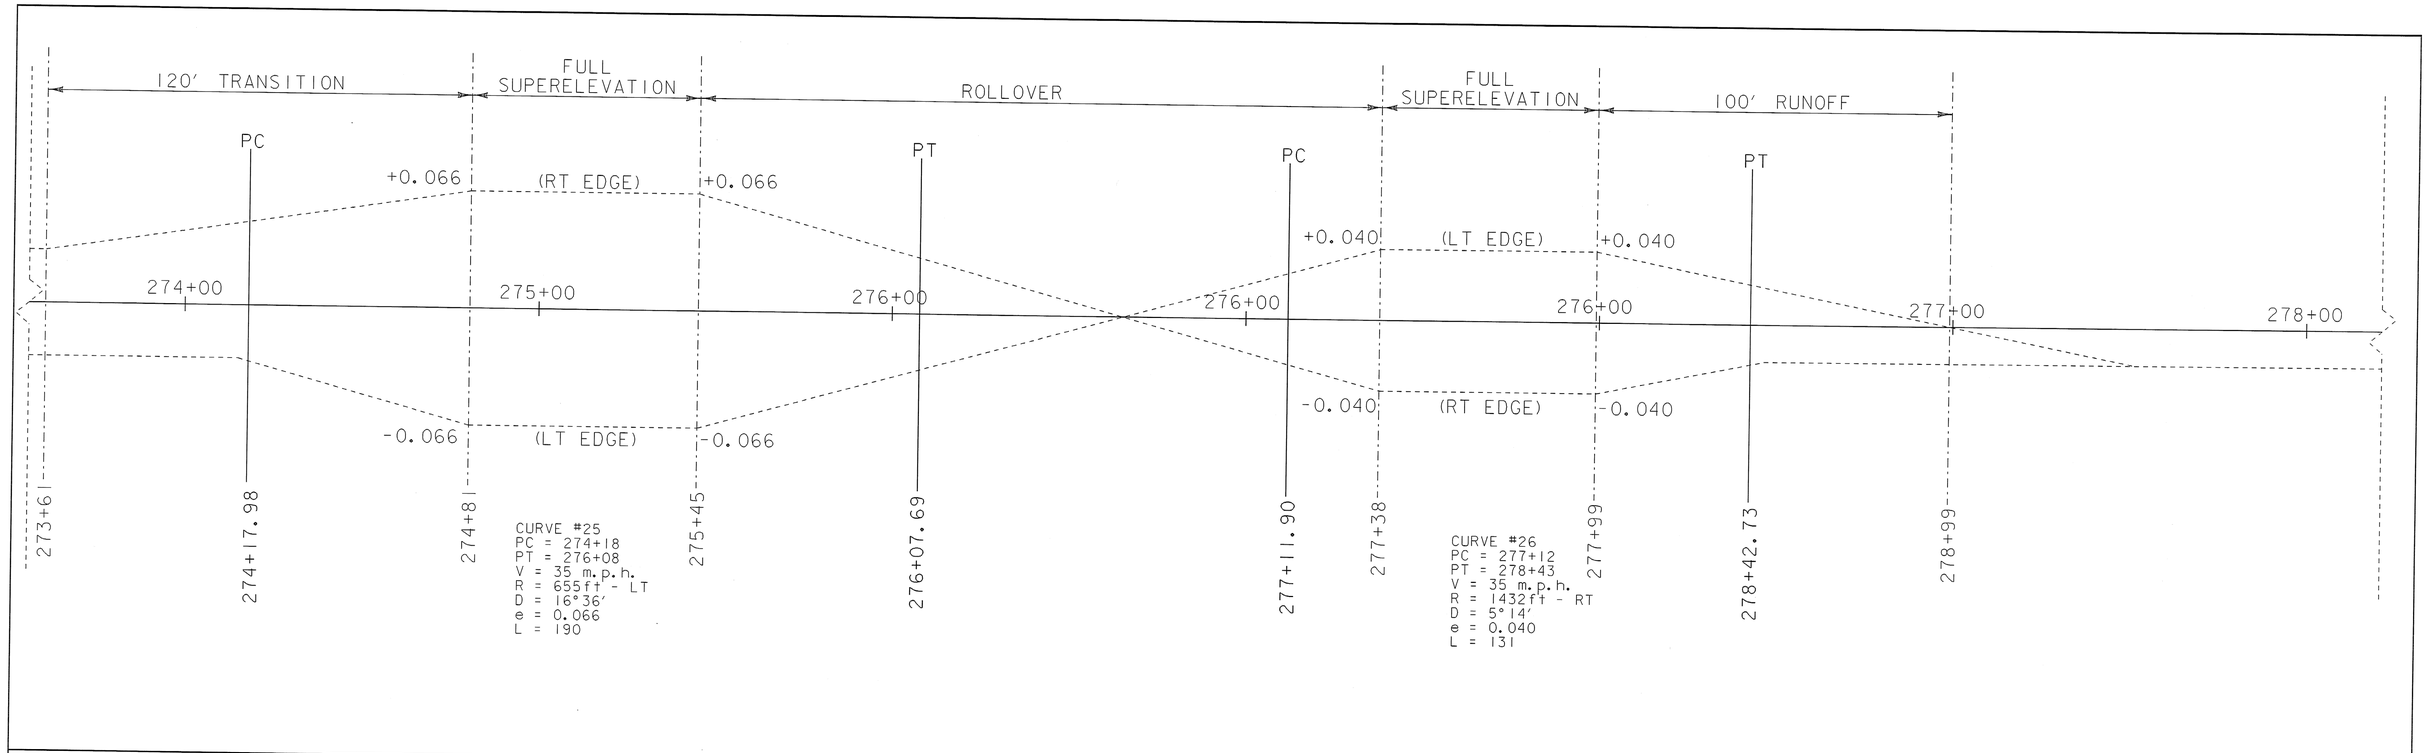

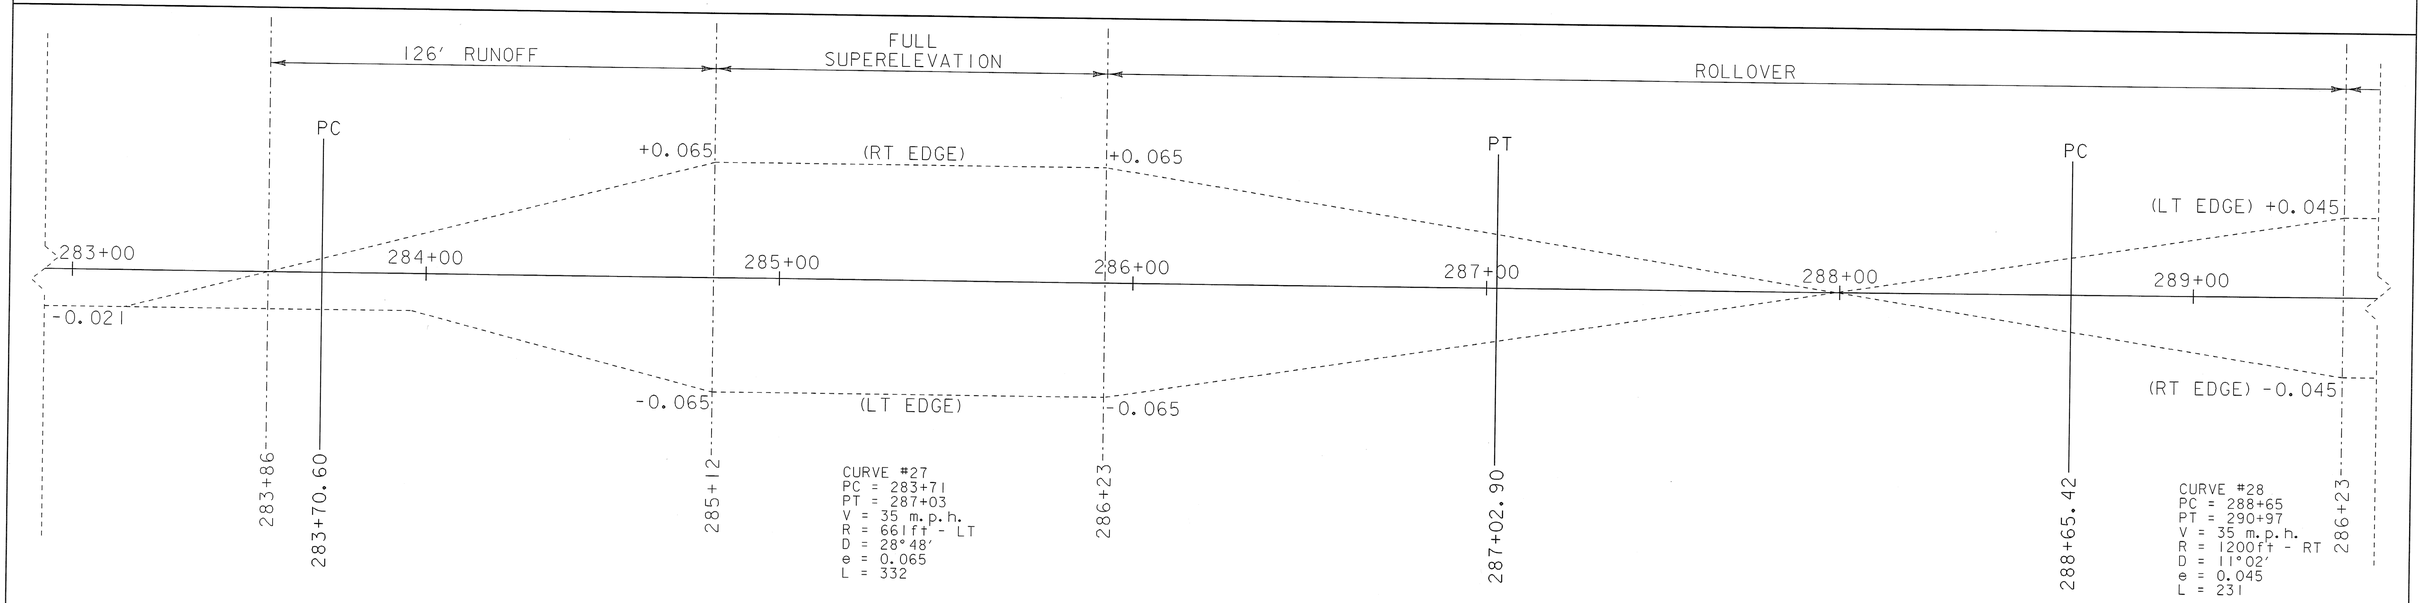

0 20 40
SCALE IN FEET

PROJECT NAME: SPRINGFIELD	
PROJECT NUMBER: STP 0136(1)	
FILE NAME: Bank.dgn	PLOT DATE: 30-DEC-2008
PROJECT LEADER: K. UPMAL	DRAWN BY: B. KIPP
DESIGNED BY: B. KIPP	CHECKED BY: N. PAPPAS
BANKING DIAGRAM II	SHEET 58 OF 68