


ABUTMENT #2
PLAN VIEW
SCALE 1:50

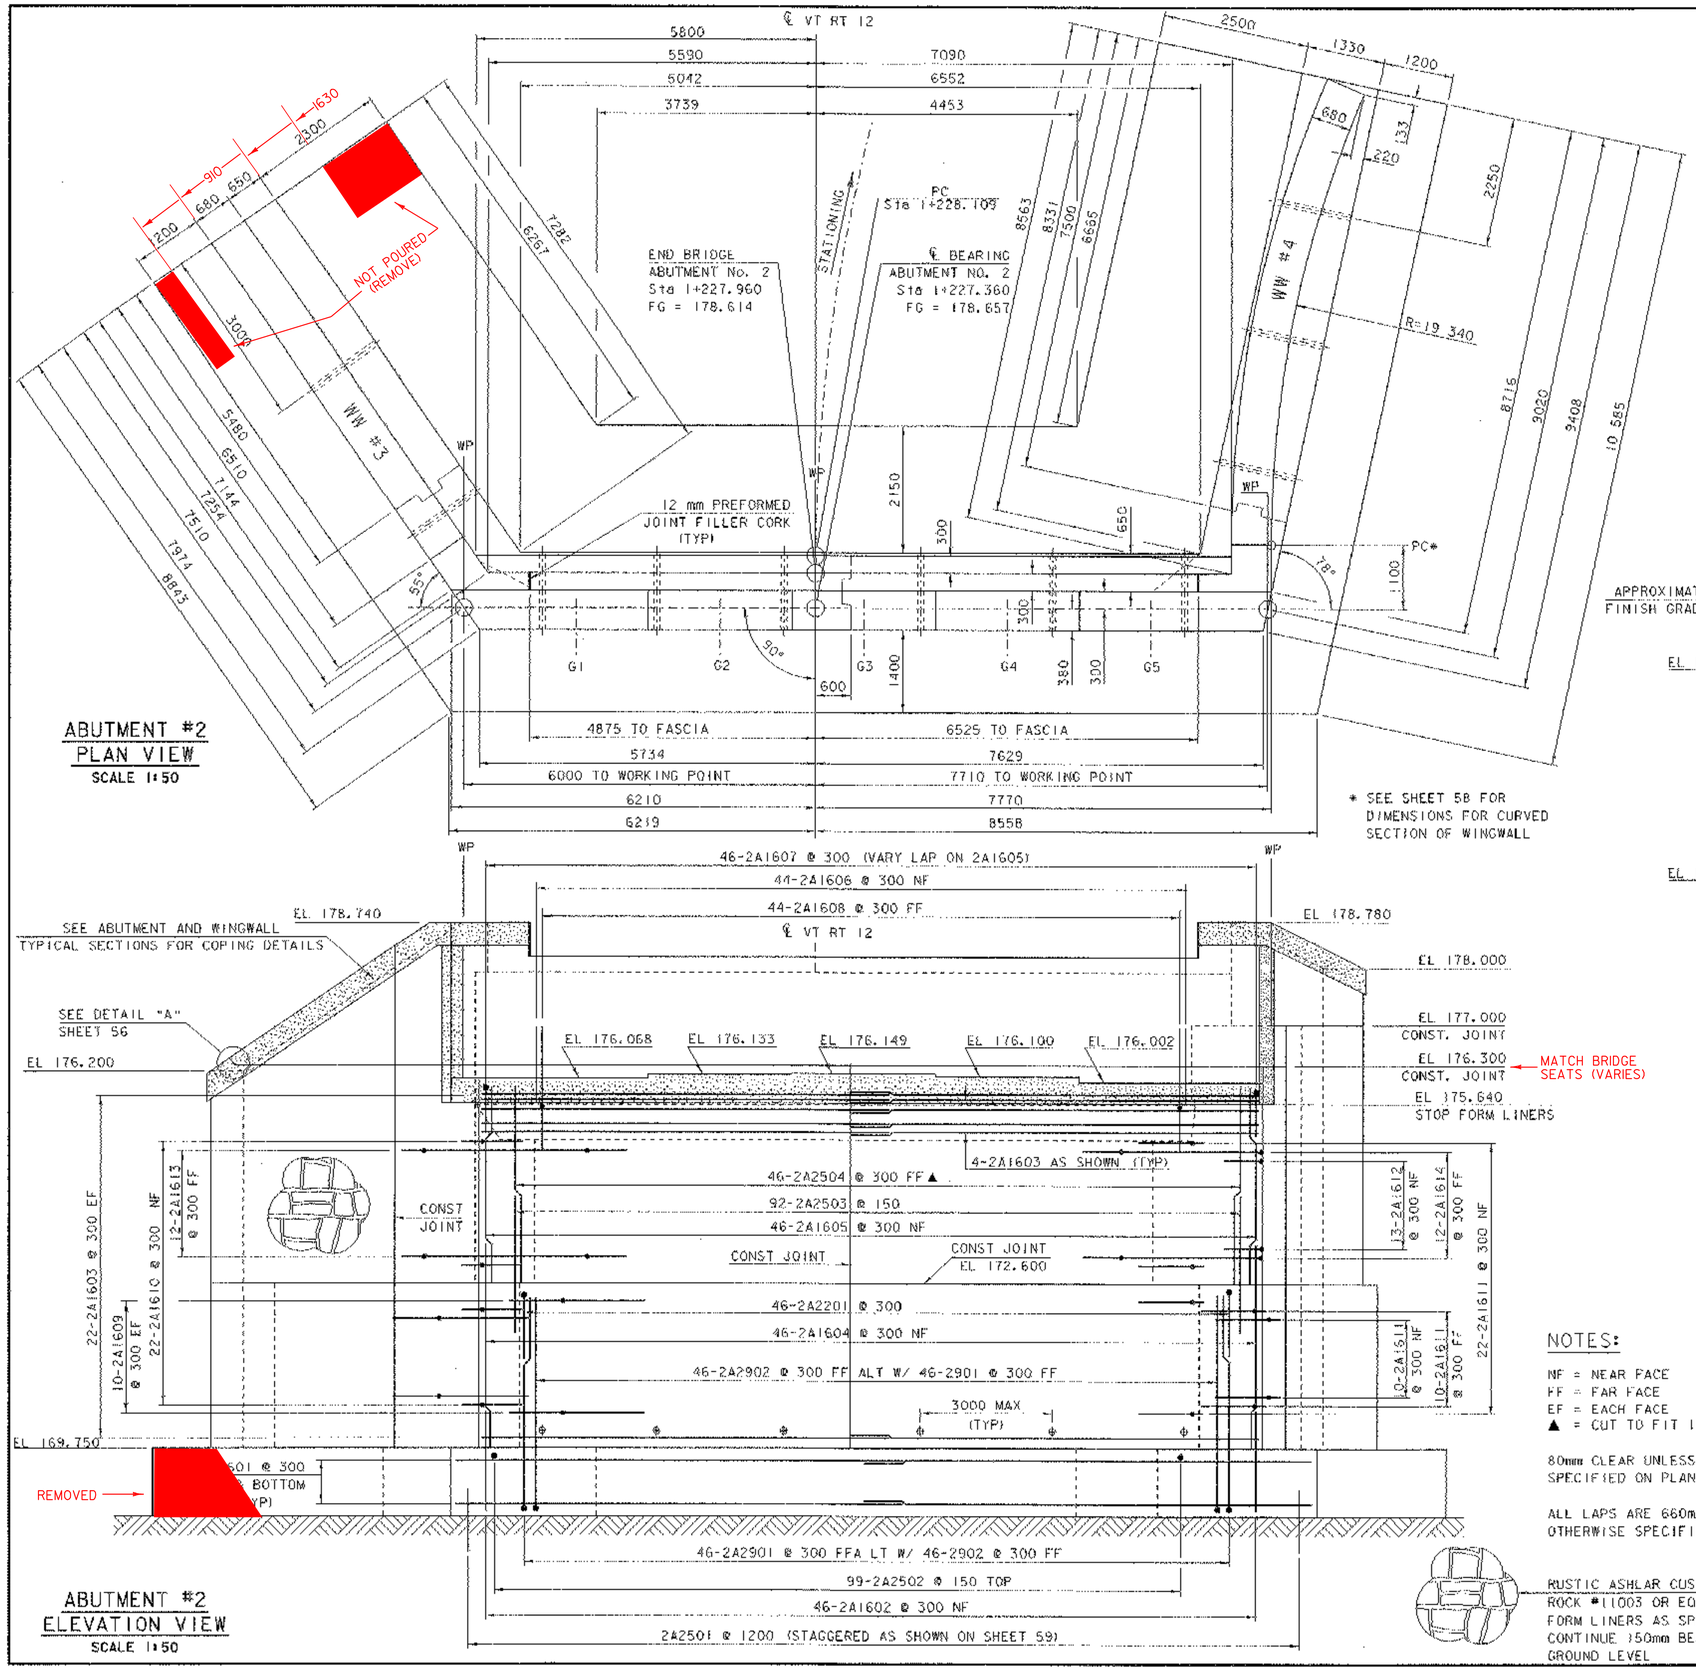


ABUTMENT #2
ELEVATION VIEW
SCALE 1:50




* CLEAR COVER INCLUDES 30 mm FOR MAXIMUM FORM LINER RELIEF

** STOP FORM LINERS AND CONSTRUCT COPING (NOT SHOWN IN PLAN VIEW)

ABUTMENT #2
TYPICAL SECTION
SCALE 1:40

NOTES:

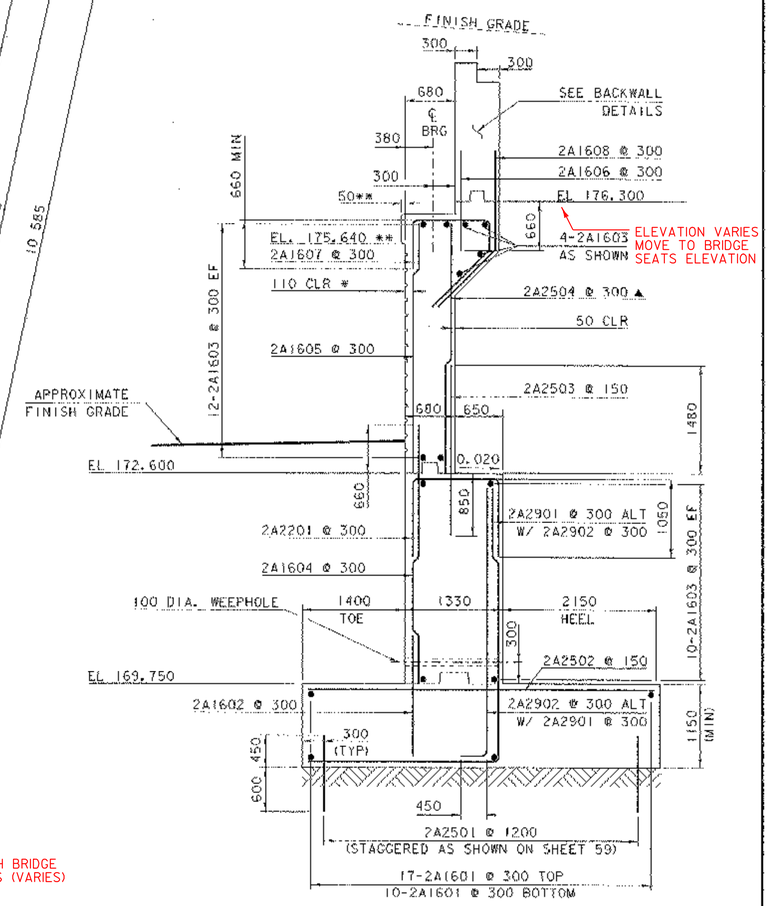NF = NEAR FACE
FF = FAR FACE
EF = EACH FACE
▲ = CUT TO FIT IN FIELD

80mm CLEAR UNLESS OTHERWISE SPECIFIED ON PLANS

ALL LAPS ARE 660mm UNLESS OTHERWISE SPECIFIED ON PLANS

RUSTIC ASHLAR CUSTOM ROCK #11003 OR EQUIVALENT FORM LINERS AS SPECIFIED CONTINUE 150mm BELOW GROUND LEVEL

SCALE = 1:40

SCALE = 1:50

| PROJECT: BETHEL | PROJECT NO.: BRF0241(33)C/2 |
|---|---|
| DESIGN FILE NAME: 02c180/structures/s02c180abut2.dgn | |
| IPARM FILE NAME: s02c180abut2.i | PLOT DATE: 15-APR-2005 |
| DESIGNED BY: M.GAGULIC | DRAWN BY: E.L.RUSTAY |
| SQUAD LEADER: C.P.WILLIAMS | CHECKED BY: M.GAGULIC |
| ABUTMENT #2 DETAILS | SHEET: 55 OF 130 |