Metric

PIPE INVERT 177.07

(OMITTED)

GRAN. BORROW = 0 SM

COMMON EXC. = 5.06 SM

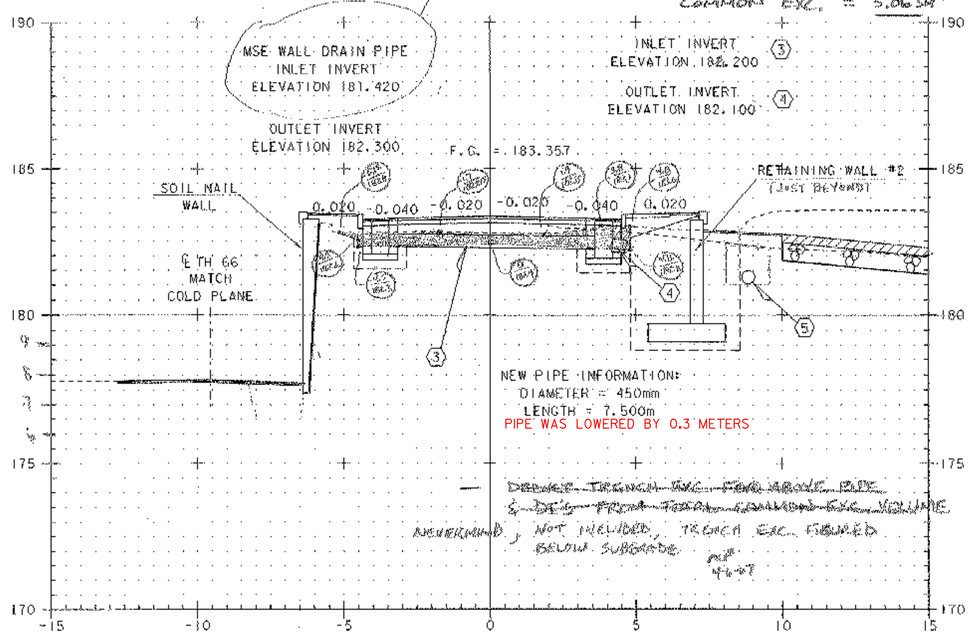

1+160

COMMON EXC. STOP @ 1+166

COMMON EXC. = 5.06 SM

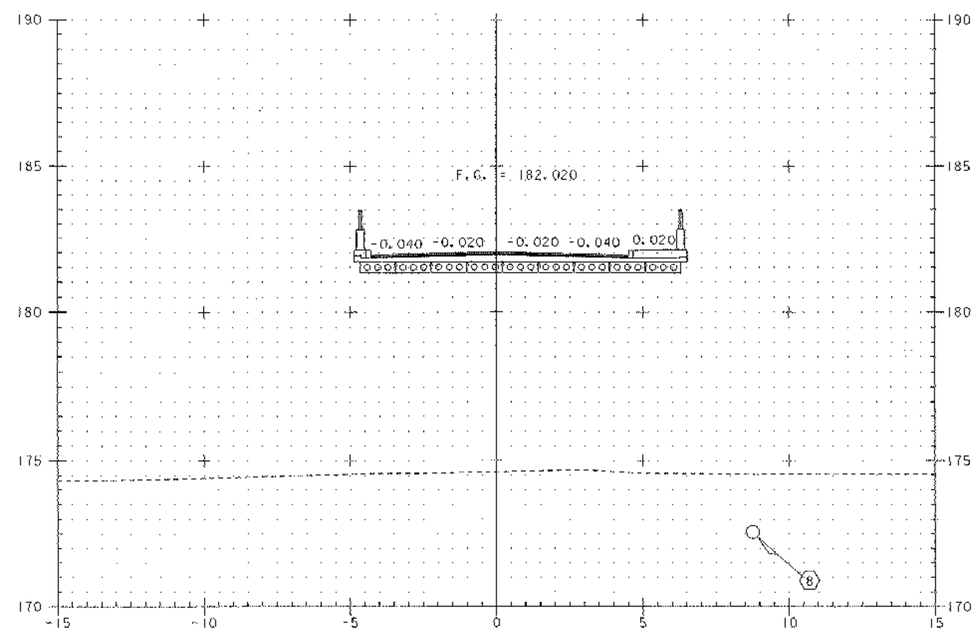

1+180

BEGIN BRIDGE 1+172.000

GRAN. BORROW = 1.35 SM

COMMON EXC. = 4.01 SM

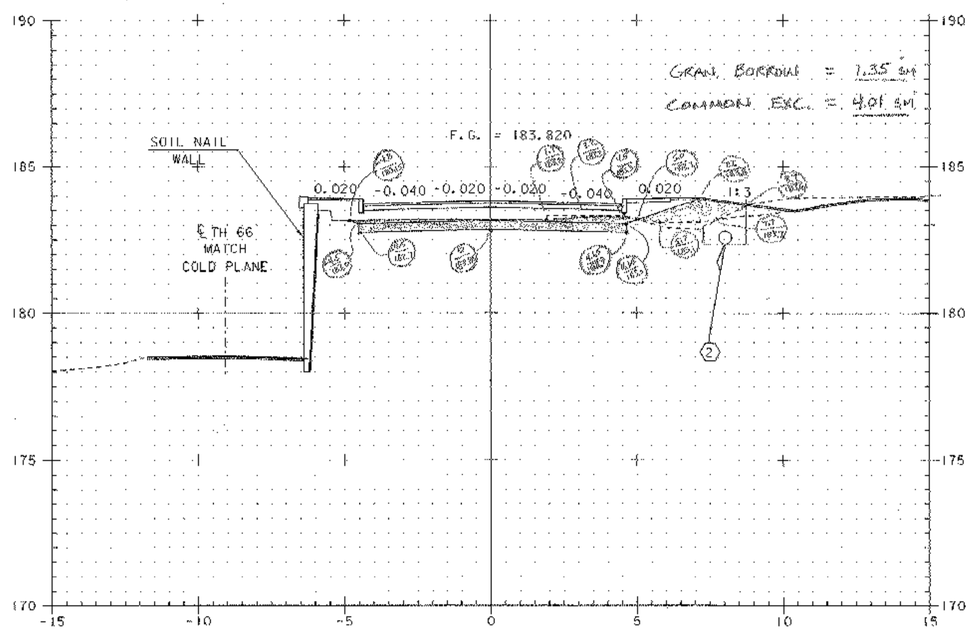

1+150

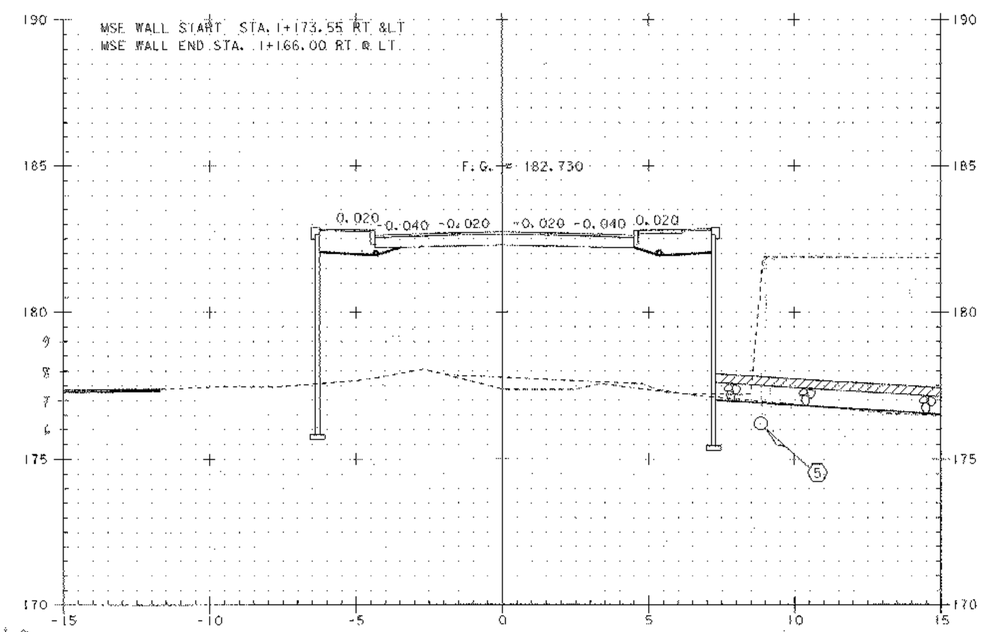

1+170

ACP JAP
4-9-07 10/07/07

0 2 4 6 8 10
SCALE 1 : 100

PROJECT: BETHEL	PROJECT NO. : BRF0241 (33) C/2
DESIGN FILE NAME: 02c180/Structures/s02c180xsec.dgn IPARM FILE NAME: sc180m14.i	PLOT DATE: 14-APR-2005
MAINLINE CROSS SECTIONS	
STA 1+150 Thru STA 1+180	SHEET: 87 OF 130