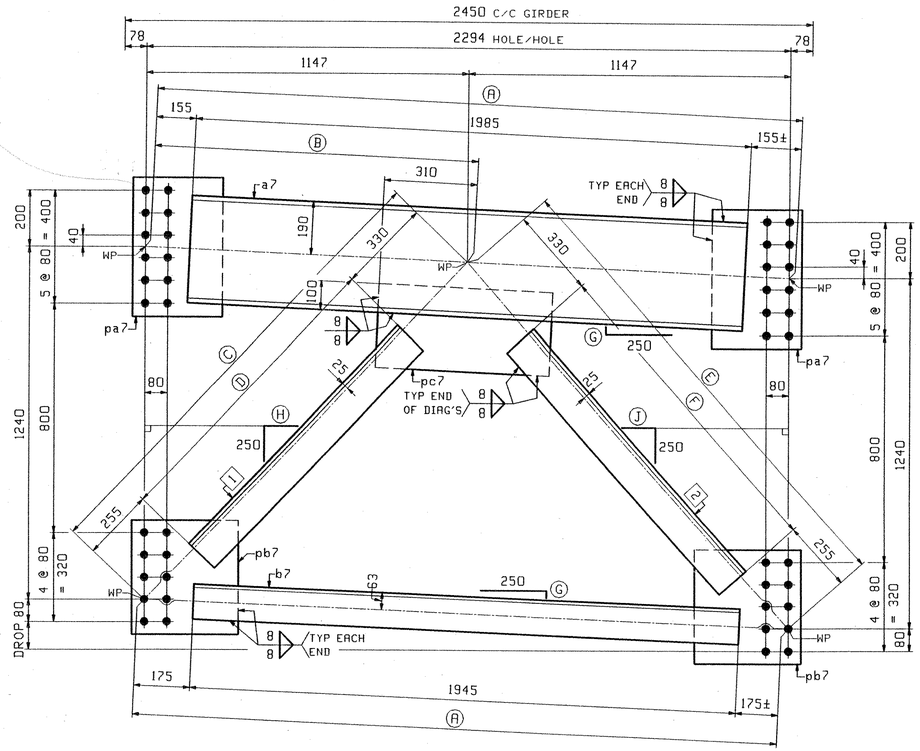

END CROSSFRAMES ~ MARK

	MARK	QTY	DROP	Ⓐ	Ⓑ	Ⓒ	Ⓓ	Ⓔ	Ⓕ	Ⓖ	Ⓗ	Ⓙ	1	2	
	7CF1	1	98	2296	1148	1654	1069	1725	1140	11	241	222	c7	d7	ABUT 2 LINES 4-5
PAINTED→	7CF2	1	64	2295	1147	1666	1081	1713	1128	7	237	225	f7	g7	PIER LINES 1-2
	7CF3	1	49	2295	1147	1671	1086	1707	1122	5	236	227	k7	m7	ABUT 2 LINES 3-4
PAINTED→	7CF4	1	16	2294	1147	1683	1098	1695	1110	2	233	230	n7	p7	PIER LINES 2-3

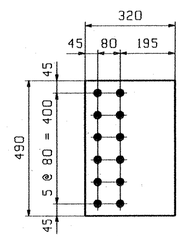

DETAIL - pa7
16 REQ'D

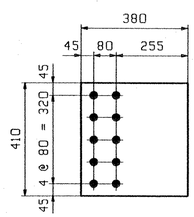

DETAIL - pb7
16 REQ'D

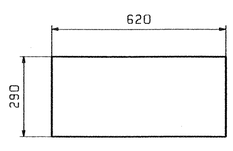

DETAIL - pc7
8 REQ'D

ABM INFO PAGE	ABM INFO LINE	SHIP MARK	QTY	MARK	MATERIAL	LENGTH m	LENGTH mm	REMARKS	WT	PROCUREMENT NOTES
		7CF1	1		END CROSSFRAMES				288 kg 634 lbs	
2	R		1	a7	C 380x50	1	985			
2	S		1	b7	L 127x127x12.7	1	945			
2	T		1	c7	L 127x127x12.7	1	069			
2	T		1	d7	L 127x127x12.7	1	140			
2	U		2	pa7	PL 14x320	0	490			
2	V		2	pb7	PL 14x380	0	410			
2	W		1	pc7	PL 14x290	0	620			
		7CF2	1		END CROSSFRAMES			PAINTED	288 kg 634 lbs	
2	R		1	a7	C 380x50	1	985			
2	S		1	b7	L 127x127x12.7	1	945			
2	T		1	f7	L 127x127x12.7	1	081			
2	T		1	g7	L 127x127x12.7	1	128			
2	U		2	pa7	PL 14x320	0	490			
2	V		2	pb7	PL 14x380	0	410			
2	W		1	pc7	PL 14x290	0	620			
		7CF3	1		END CROSSFRAMES				288 kg 634 lbs	
2	R		1	a7	C 380x50	1	985			
2	S		1	b7	L 127x127x12.7	1	945			
2	T		1	k7	L 127x127x12.7	1	086			
2	T		1	m7	L 127x127x12.7	1	122			
2	U		2	pa7	PL 14x320	0	490			
2	V		2	pb7	PL 14x380	0	410			
2	W		1	pc7	PL 14x290	0	620			
		7CF4	1		END CROSSFRAMES			PAINTED	288 kg 634 lbs	
2	R		1	a7	C 380x50	1	985			
2	S		1	b7	L 127x127x12.7	1	945			
2	T		1	n7	L 127x127x12.7	1	098			
2	T		1	p7	L 127x127x12.7	1	110			
2	U		2	pa7	PL 14x320	0	490			
2	V		2	pb7	PL 14x380	0	410			
2	W		1	pc7	PL 14x290	0	620			

BILL OF MATERIAL

JOB NO.

DRAWING NO. 7

REV.

REV.	REMARKS	DATE	DWN	CHK	APP	Q.A.
	OUT FOR APPROVAL	7-5-05				
	OUT FOR APPROVAL					
	ISSUED TO SHOP					
	FIELD & OFFICE					

NO.	DIA.	LGT	TYPE	WASHER

MATERIAL: M270M GR 345W

ELECTRODES:

HOLES: 15/16ø 24mm

SHOP BOLTS: NONE

SURFACE PREP. & PAINT:

SEE DRAWING GN1

DESCRIPTION: END CROSSFRAMES

JOB: VT ROUTE 12 BRIDGE OVER WHITE RIVER
BRIDGE NO: 31 (SPAN #2)
TOWN OF BETHEL, VERMONT
COUNTY OF WINDSOR
CONTRACTOR: KUBRICKY CONST CORP.

PROJ NO. BRF0241(33) C/2

CUSTOMER: VERMONT AOT

DRAWN BY	DATE
JTB	05/
CHKD BY	
TJB	06/ 2
APPROV BY	
SUPERVISOR	W. J. G
Q.A.	

RECEIVED
CK'D BY KMT OK'D BY HJS
JUL 14 2005
RESUBMIT APPROVED As Noted
BY GPW DATE 7/28/05

TENSOR 2563

CASCO BAY STEEL STRUCTURES, INC.
75 SPRING HILL ROAD SACO, MAINE 04072
PHONE (207) 282-7360 FAX. (207) 282-1179

JOB NO. 270 14455

DRG. NO 7

REV. △

JTB Mon May 30 15:51:13 EDT 2005 /users/jobs/270/7 ; Rev0