Metric

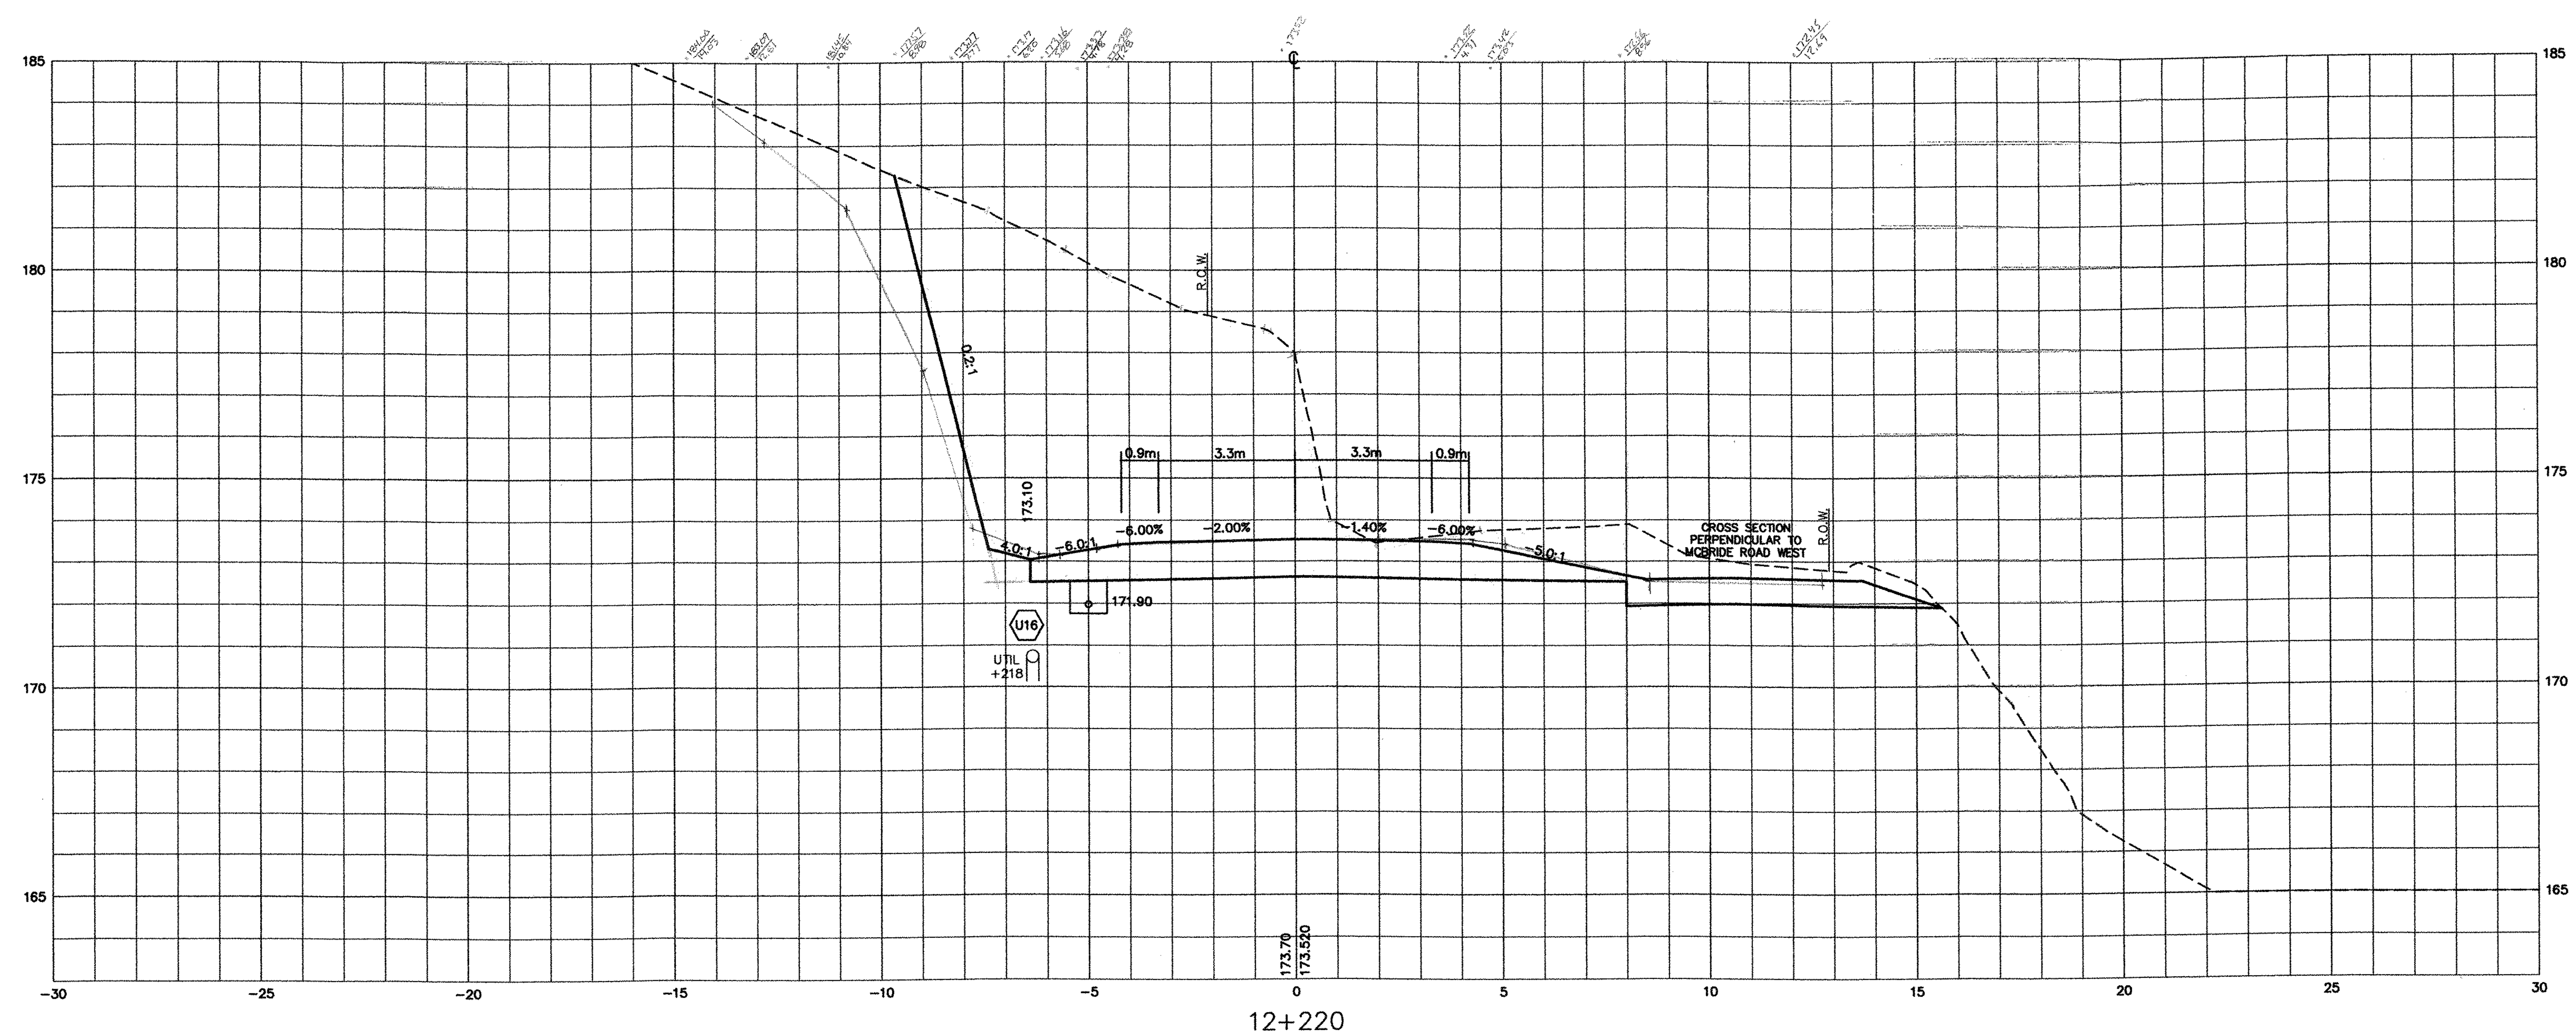

ROUTE 121 CROSS SECTIONS

PROJECT: GRAFTON–ROCKINGHAM, ROUTE 121	PROJECT NO. : STP 0126(4)S
DESIGN FILE NAME: IPARM FILE NAME: SURVEYED BY: SQUAD LEADER:	PLOT DATE: 12/08/03 SURVEY DATE: DRAWN BY: SHEET: 85 OF 116

DATUM	
VERTICAL	NGVD 1929
HORIZONTAL	NAD 1927

V: /1261/CADD/PLANS/SECTIONS–FINAL–ROUTE121–C2C.DWG

THE LOUIS BERGER GROUP, INC.