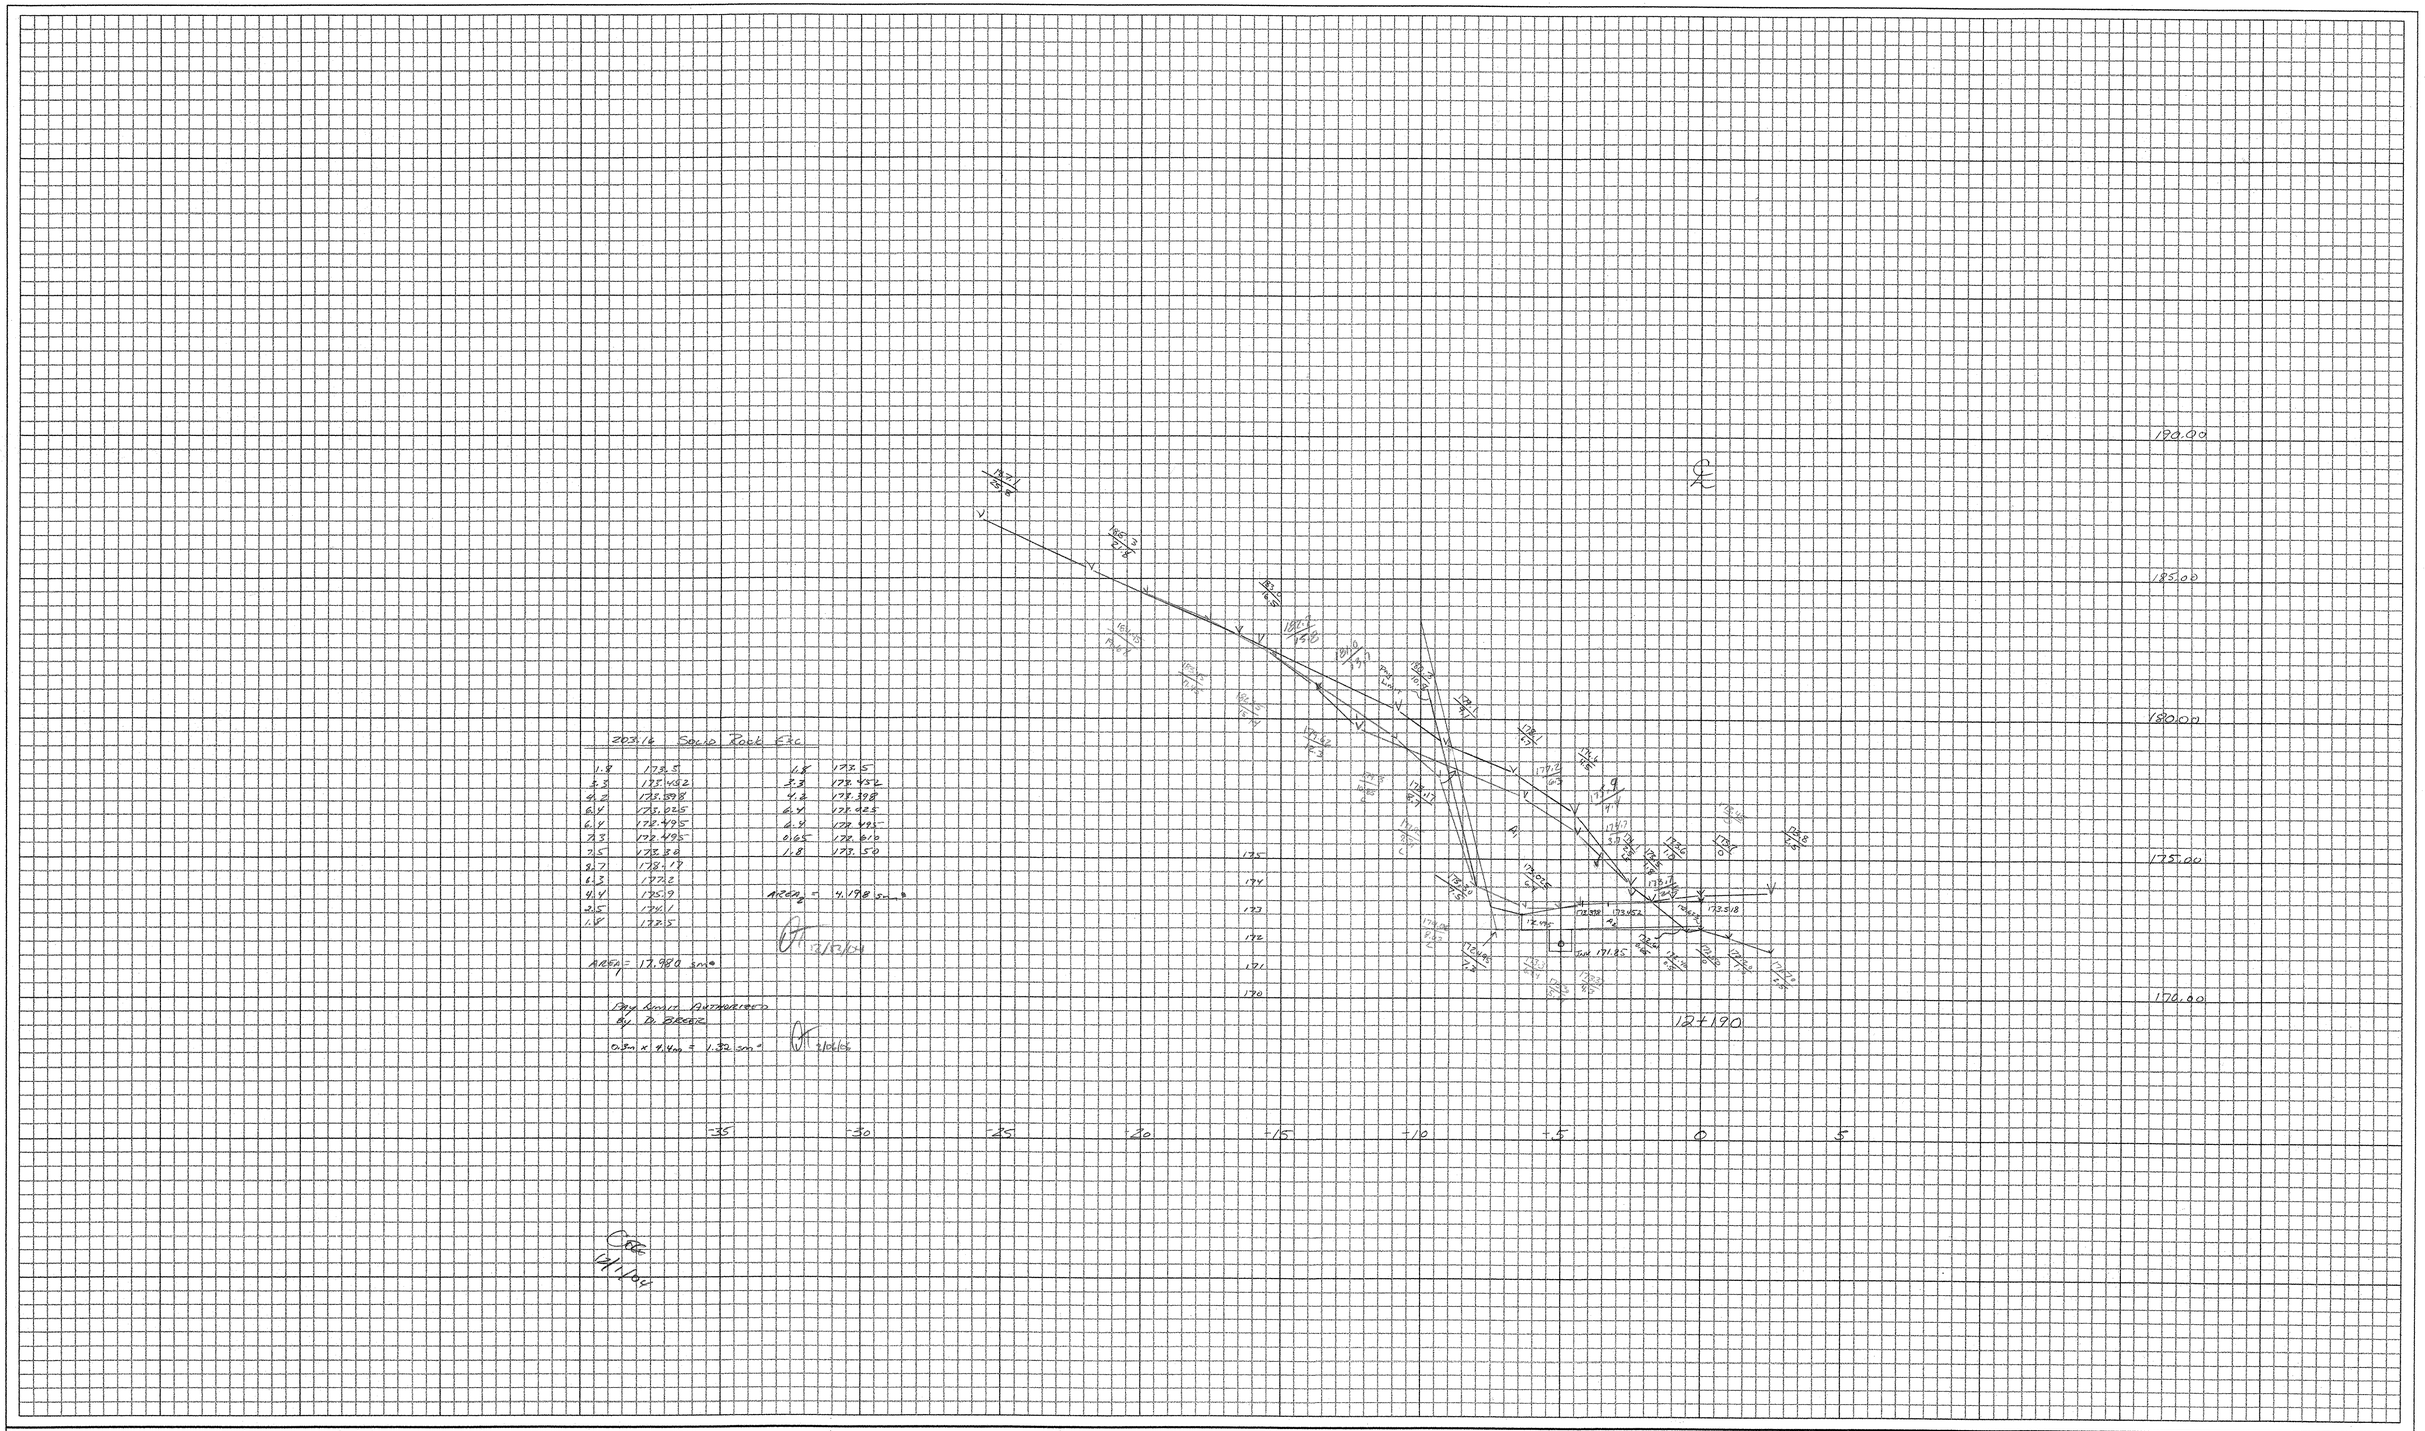
190.00
185.00
180.00
175.00
170.00
175
174
173
172
171
170
-35
-30
-25
-20
-15
-10
-5
0
5
124190
173.518
173.452
173.398
173.495
173.610
173.50
