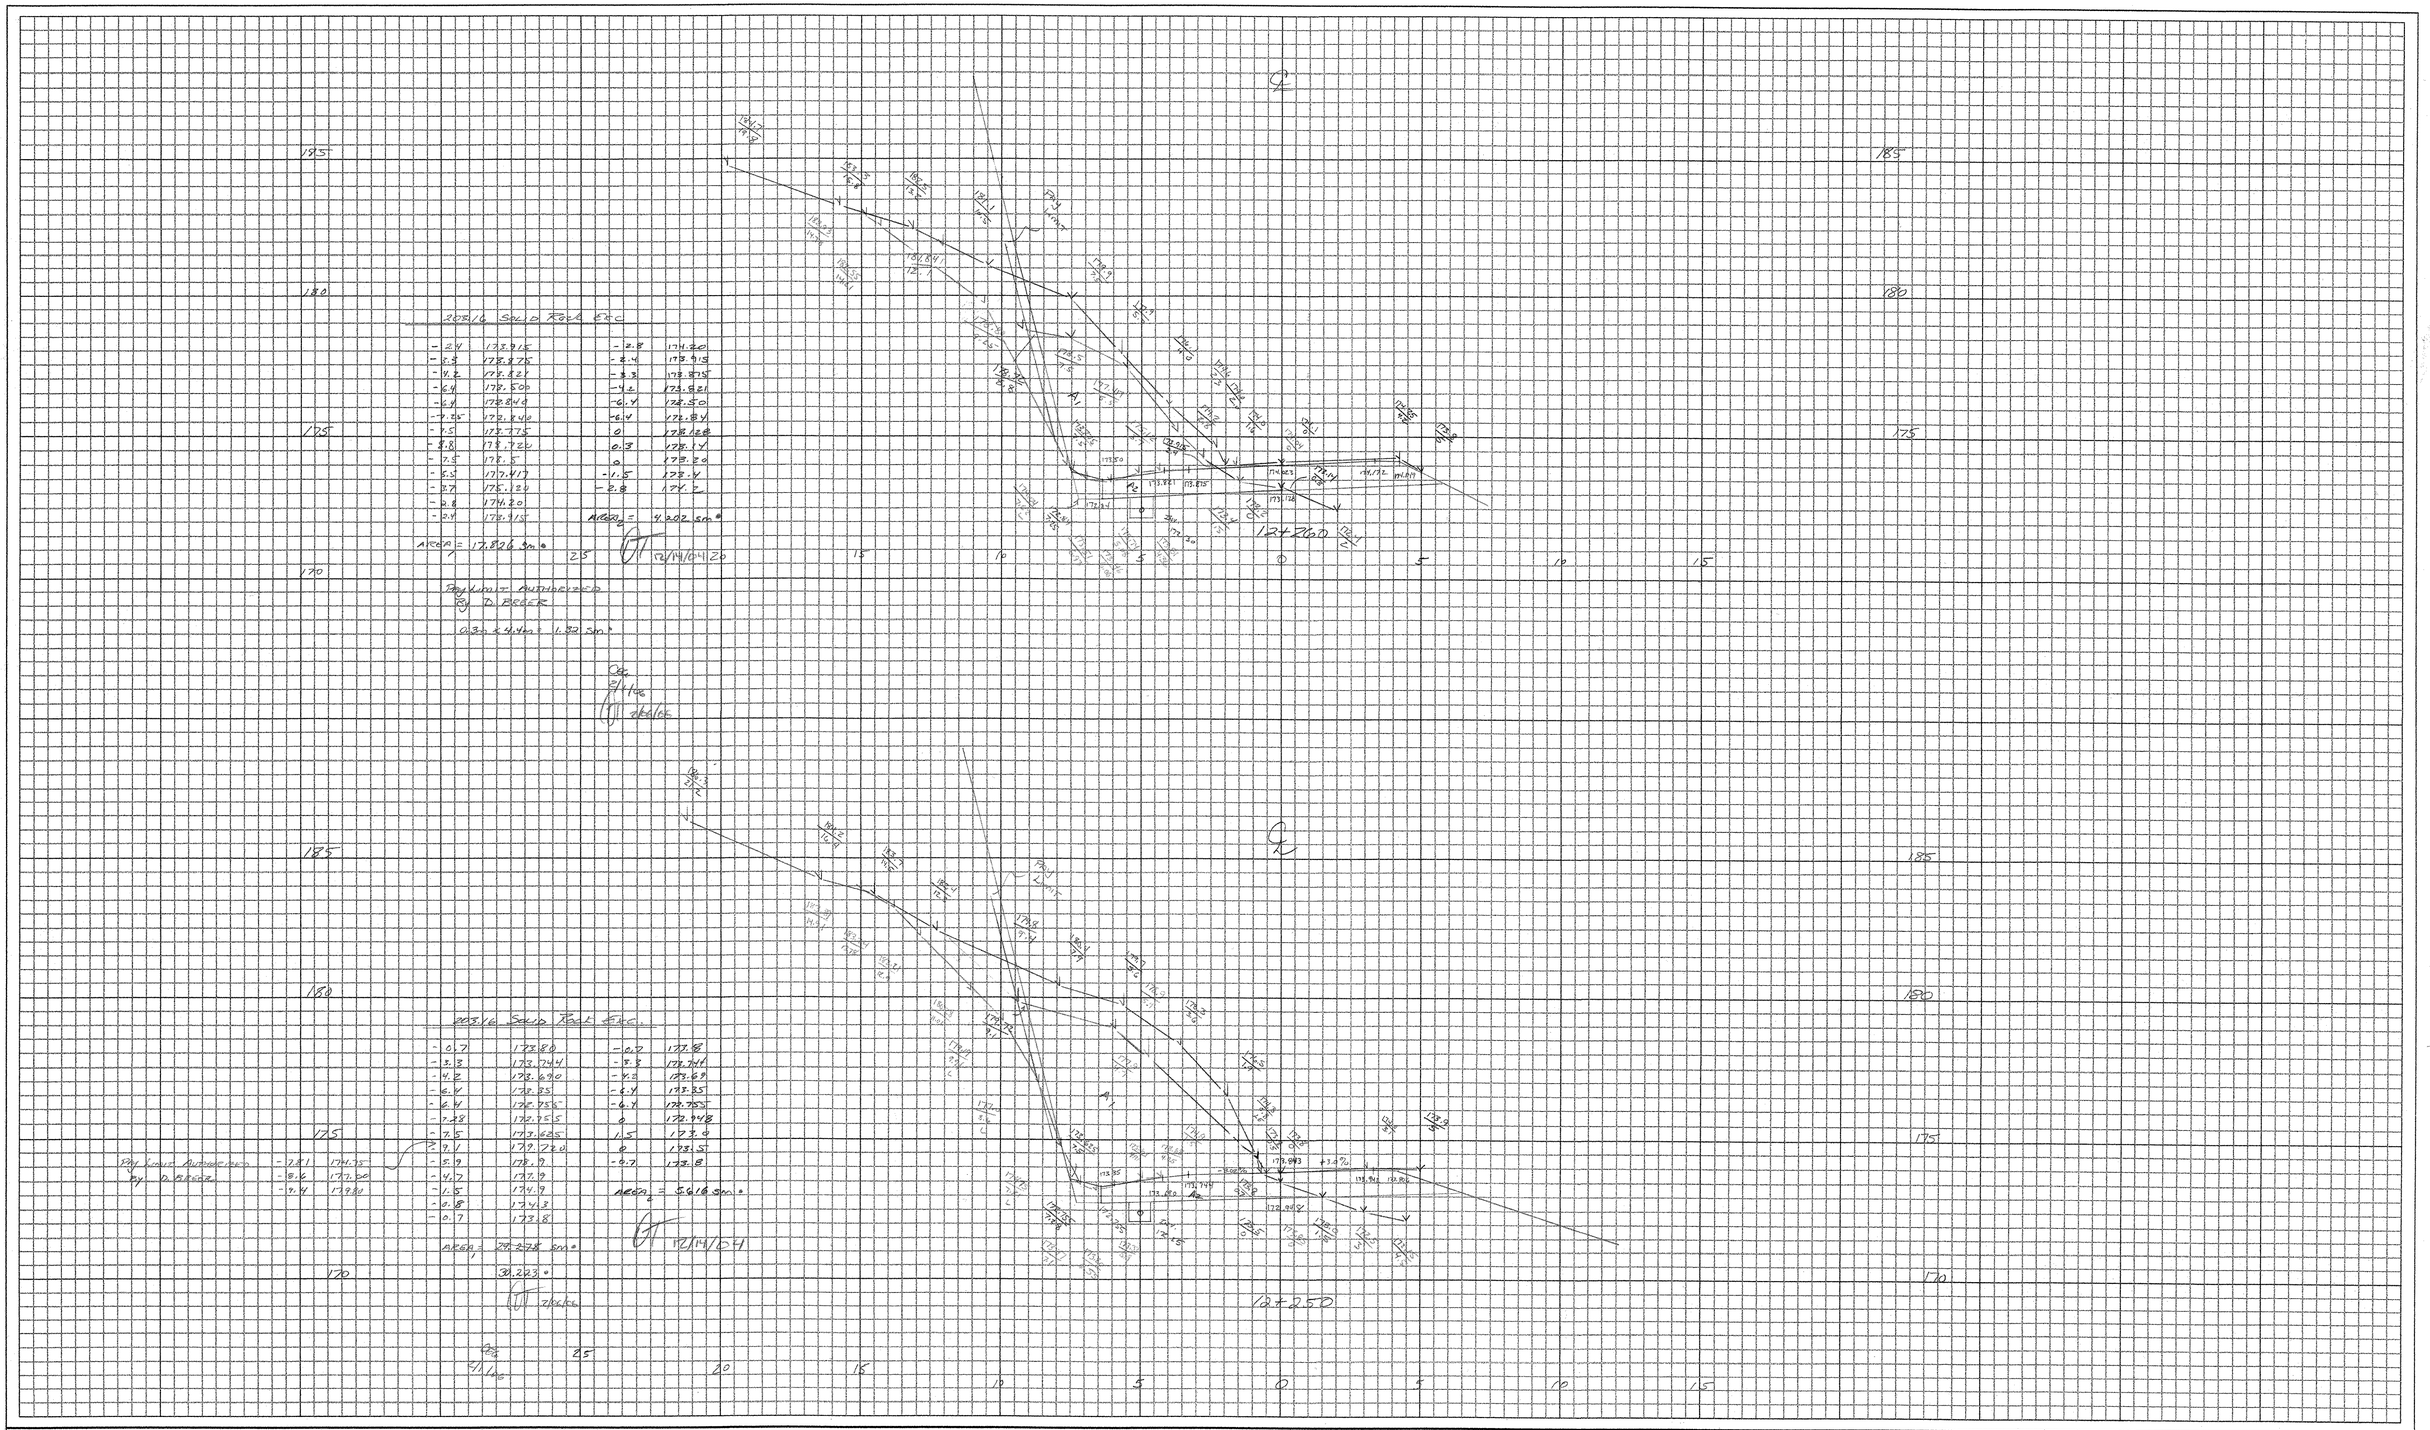

208.16 Solid Rock Exc			
-2.4	173.915	-2.8	174.20
-3.3	173.875	-2.4	173.915
-4.2	173.821	-3.3	173.875
-6.4	173.500	-4.2	173.821
-6.4	173.848	-6.4	173.50
-7.25	173.848	-6.4	173.84
-7.5	173.775	0	173.128
-8.8	173.726	0.3	173.14
-7.5	173.5	0	173.20
-5.5	173.417	-1.5	173.4
-3.7	173.124	-2.8	173.2
-2.8	174.20		
-2.4	173.915	$AREA_2$ =	4.202 sm²

$AREA_1$ = 17.826 sm²

12/14/04

203.16 Solid Rock Exc			
-0.7	173.80	-0.7	173.8
-3.3	173.744	-3.3	173.744
-4.2	173.690	-4.5	173.69
-6.4	173.35	-6.4	173.35
-6.4	173.755	-6.4	173.755
-7.25	173.755	0	173.948
-7.5	173.625	1.5	173.0
-9.1	173.720	0	173.5
-5.9	173.9	-0.7	173.8
-4.7	173.9		
-1.5	174.9	$AREA_2$ =	5.618 sm²
-0.8	174.3		
-0.7	173.8		

$AREA_1$ = 22.278 sm²

30.223 m

12/14/04

Pay Limit Authorized By D. Breen		
-7.81	174.75	
-8.6	177.00	
-7.4	179.80	

MaDOT Metric

CROSS SECTION SHEET

12/1/04

PROJECT NAME: GRAFTON – ROCKINGHAM	
PROJECT NUMBER: STP 0126 (4) S CONTRACT #2	
FILE NAME: LEDGE	PLOT DATE: 07-JUN-2000 13:
PROJECT LEADER:	DRAWN BY: O. GREENWOOD
DESIGNED BY:	CHECKED BY: D. TYLER
const: g:/common/cadd/m-xsection.dgn	SHEET 8 OF 9

158 LEDGE +S