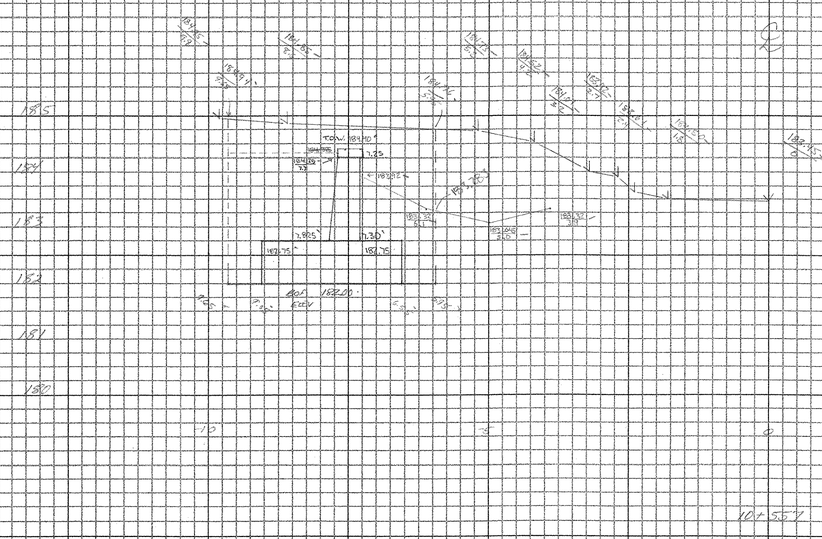
185
184
183
182
181
180
-10
0
10+55
TOP 184.10
184.85
184.75
183.30
183.32
183.37
183.37
183.37