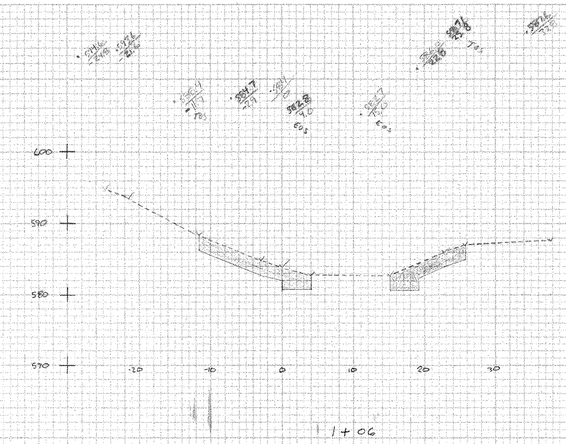

: STONE FILL (TYPE)

LT X	LT Y	RT X	RT Y
-11.7	588.4	15	582.7
-29	584.7	22.8	586
6	584.6	25.8	587.1
4.0	582.8	25.8	585.1
4.0	580.8	22.8	584.0
6	580.8	19.0	584.1 582.4
6	582	19.0	580.7
-29	582.7	15	580.7
-11.7	584.4	15	582.7
-11.7	588.4		

AREA: 33.8 ft² AREA: 27.4 ft²
25.0 ft²

: UNCLASSIFIED CHANNEL EXC

LT AREA: 33.8 ft² RT 27.4 ft² 25.0

GEOTEXTILE UNDER STONE FILL
21 ft + 18 ft = 39 ft

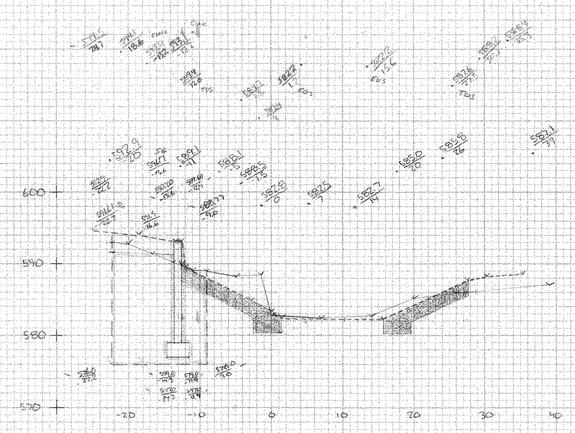

GEOTEXTILE UNDER STONE FILL
21 ft x 19 ft = 40 ft

308.30: COFFERDAM EXC, EARTH

LT X	LT Y	RT X	RT Y
-22.2	576.0		
-22.2	592.4 591.61		
-16.6	591.5		
-13.6	590.2		
-11.0	589.1		
-9.0	588.77		
-5.0	576.0		
-22.2	576.0		

AREA: 136.43 ft²
193.02

0 ft²

204.30: GRAN. BKFL. FOR STRUCT

LT X	LT Y	RT X	RT Y
-22.2	576.0		
-22.2	591.61		
-16.6	591.0		
-13.6	591.17		
-13.6	591.0		
-11.3	591.0		
-11.3	577.0		
-11.4	577.0		
-11.1	591.0		
-12.4	591.0		
-12.4	587.7		
-9.0	587.4 585.9		
-9.0	576		
-22.2	576		

AREA: 151.0 ft²
167.6

0 ft²

: UNCLASSIFIED CHANNEL EXC

LT X	LT Y	RT X	RT Y
-9.0	585.9	15.6	582.2
-9.0	588.77	7	582.5
-5	588.1	14	582.7
-4.5	586.5	20	585
0	582.0	26	585.8
1.2	582.75	27.5	586.6
1.2	580.3	27.5	585.6
-2.8	580.3	19.6	582.7
-2.8	582.7	17.6	580.2
-9.6	585.9	15.6	580.2
		15.6	582.2

AREA: 46.7 AREA: 30.7

: STONE FILL (TYPE

LT X	LT Y	RT X	RT Y
1.2	582.2	15.6	580.2
1.2	580.3	15.6	582.2
-2.8	580.3	27.5	582.6
-2.8	582.7	27.5	585.6
-12.4	582.7	17.6	582.2
-12.4	585.9	17.6	580.2
-2.8	584.7	15.6	580.2
0	583.4		
1.2	582		

AREA: 50.3
32.7

AREA: 26.7

12/15/05

FINAL SURVEY
SURVEYED
PLOTTED
TEMPLATE
AREAS
NOTE BOOK
PVI
INDEX CHECKED
BY
DATE
ORIGINAL SURVEY
SURVEYED
PLOTTED
TEMPLATE
AREAS
NOTE BOOK
PVI
INDEX CHECKED
BY
DATE