STATE OF VERMONT
AGENCY OF TRANSPORTATION

TRAFFIC SIGN SUMMARY SHEET

MILEMARKER, STATION, OR SIGN NUMBER	SIGN LEGEND	SIGN DIMENSIONS EA	WIDTH (in)	HEIGHT (in)	NEW & SALVAGED SIGNS "A"	"B"	SALV SIGN	SALV TIS	EXIST POST RETAIN	SALVAGE	NO. OF POSTS	FLANGED CHANNEL lb/ft 1.12	2.0	3.0	SQUARE STEEL (in) lb/ft 1.75	2.0	2.5	ANCHOR	SLEEVE	TUBULAR ALUMINUM Ø (in) lb/ft 3.0	4.0	4.0 MOD	TUBULAR STEEL Ø (in) FOUND-ATION	lb/ft 3.0	3.5	4.0	5.0	W-SHAPE STEEL FTG. SIZE 24"	30"	WEIGHT	POST SIZE	SIGNS REQUIRED	REMARKS	SIGN DETAIL DETAIL ON SHEET NUMBER	STD. SHEET NUMBER
												NEW SIGN POSTS																							
														OPTION ITEMS																					
10+43 LT	STOP / US ROUTE 5 / BRIDGE STREET	1 1 1	30 24 24	30 9 5	6.25 1.50 1.50						1			X																			SIGN ID 'R1-1' WITH TWO (2) 'D3-1' STREET NAME SIGNS MOUNTED ABOVE ON THE SAME POST. 'US ROUTE 5' SIGN TO BE MOUNTED PERPENDICULAR TO VT 25A. 'BRIDGE ST.' SIGN TO BE MOUNTED PARALLEL TO VT. 25A.		E-123 E-143
10+81 RT	R R	1	---	---	7.1 ---		~~X~~				1			X																			SIGN ID 'W10-1' ~~SALVAGED~~ SIGN TO BE MOUNTED ON NEW POST NEW		
11+54 LT	DO NOT STOP ON TRACKS	1	24	30	5.00						1			X																			SIGN ID 'R8-8'		E-146
12+35 RT	SHARE THE ROAD	1 1	30 24	30 30	6.25 5.00						1			X																			SIGN IDS 'W11-1' AND 'W16-1'		E-153b
12+87 LT	R R / WALK BICYCLE ON SIDEWALK	1	--- ---	--- ---	7.1 --- ---		~~X~~ X				1			X																			~~SIGN ID 'W10-1' AND~~ 'WALK BICYCLE ON SIDEWALK' SIGN ~~BOTH~~ SALVAGED SIGNS TO BE MOUNTED BACK TO BACK ON NEW POST. (RR X-ING SIGN-NEW)		

TOTALS	SF	SF	EA.	SF		FT	FT	FT	FT	FT	FT	EA	LB	LB	LB		LB	LB	LB	LB				
	25.50		3			68																		

FINAL POST LENGTHS ARE TO BE DETERMINED IN THE FIELD. POST SIZES ARE COMPUTED BASED ON INFORMATION FURNISHED ON THE STANDARD SHEETS AND THE ROADWAY, TRAFFIC & SAFETY SECTION'S "SIGN POST DESIGN GUIDELINE."

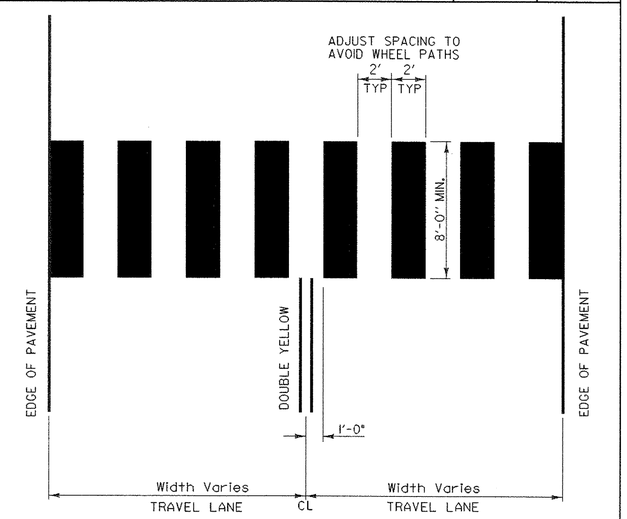

BLOCK PATTERN CROSSWALK DETAIL

PROJECT NAME: FAIRLEE
PROJECT NUMBER: ST 040-1(2)

FILE NAME: /str5/98b118/sb118traf.dgn PLOT DATE: 07-MAY-2008
PROJECT LEADER: J. Kaplan DRAWN BY: G. Shangraw
DESIGNED BY: G. Shangraw CHECKED BY: J. Kaplan
sb118sss.1 SHEET 14 OF 28