646.414 DURABLE 150 mm WHITE LINE

STA. E2+070.000 - STA. E2+320.000 SOLID RT (EDGE LINE)

646.415 DURABLE 150 mm YELLOW LINE

STA. E2+070.000 - STA. E2+320.000 SOLID LT (EDGE LINE)

Metric

VT STATE PLANE GRID

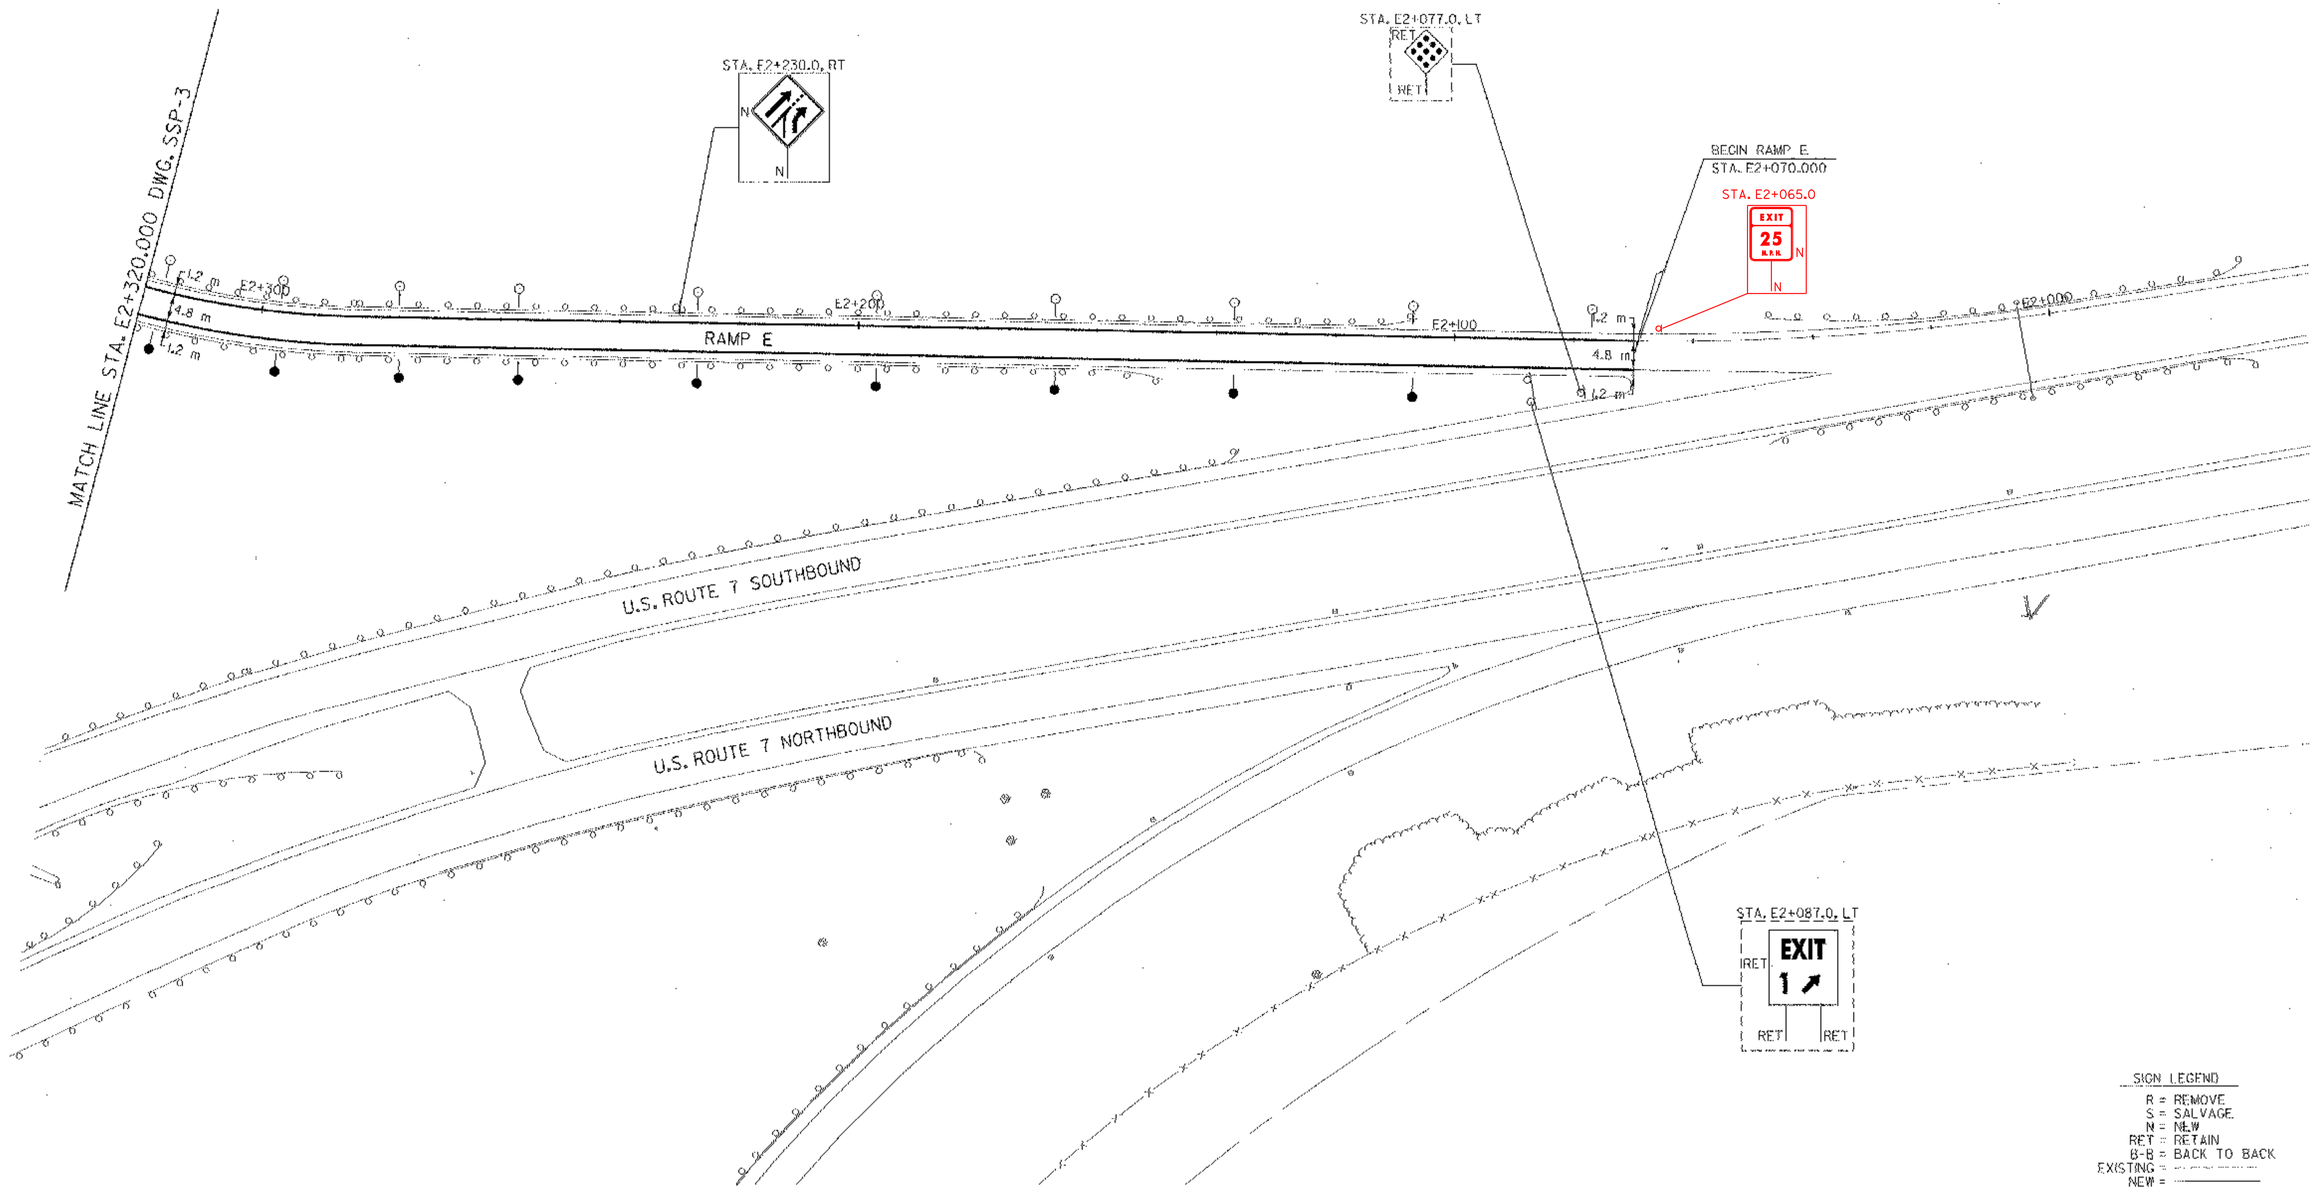

SIGN LEGEND

R = REMOVE
S = SALVAGE
N = NEW
RET = RETAIN
B-B = BACK TO BACK
EXISTING = ———
NEW = ———

676.10 DELINEATORS W/STEEL POSTS

TYPE I, WHITE	TYPE I, AMBER
STA. E2+077.0 RT	STA. E2+107.0 LT
STA. E2+107.0 RT	STA. E2+137.0 LT
STA. E2+137.0 RT	STA. E2+167.0 LT
STA. E2+167.0 RT	STA. E2+197.0 LT
STA. E2+197.0 RT	STA. E2+227.0 LT
STA. E2+227.0 RT	STA. E2+257.0 LT
STA. E2+257.0 RT	STA. E2+277.0 LT
STA. E2+277.0 RT	STA. E2+297.0 LT
STA. E2+297.0 RT	STA. E2+317.0 LT
STA. E2+317.0 RT	

DATUM

VERTICAL NAVD 88

HORIZONTAL NAD 83 (1992)

LEGEND

- TYPE I, WHITE
- TYPE I, AMBER
- TYPE II, WHITE

10 0 10 m

1: 500

@ FULL SIZE

SIGNING AND STRIPING PLAN

SURVEYED BY C.R.A. & V.S.E. DATE 12/93

DESIGNED BY D.W.E. DATE 2/04

DRAWN BY C.A.K. DATE 2/04

CHECKED BY D.E.C. DATE 2/04

DESIGN FILE NO. SSP04.DGN

PROJ. NAME BENNINGTON - HOOSICK D.P.I. 0146(1) C/6

PROJ. NO. P.I.N. 1306.60

DWG NO. SSP-4 SHEET 44 OF 83

FILE NAME =u:\5116\vaot\contract6\ssp04.dgn
DATE/TIME =2/16/2004
USER =2225