EMBANKMENT PLANTING (SEE LANDSCAPE DETAIL & TYPICAL SHEETS)

STA 285+50 TO 286+25 RT (3 BPO-TR, 3 FA-TR, 3 QR-TR, 6 PT-TR, 27 CS, 27 SP, & 33 CA)

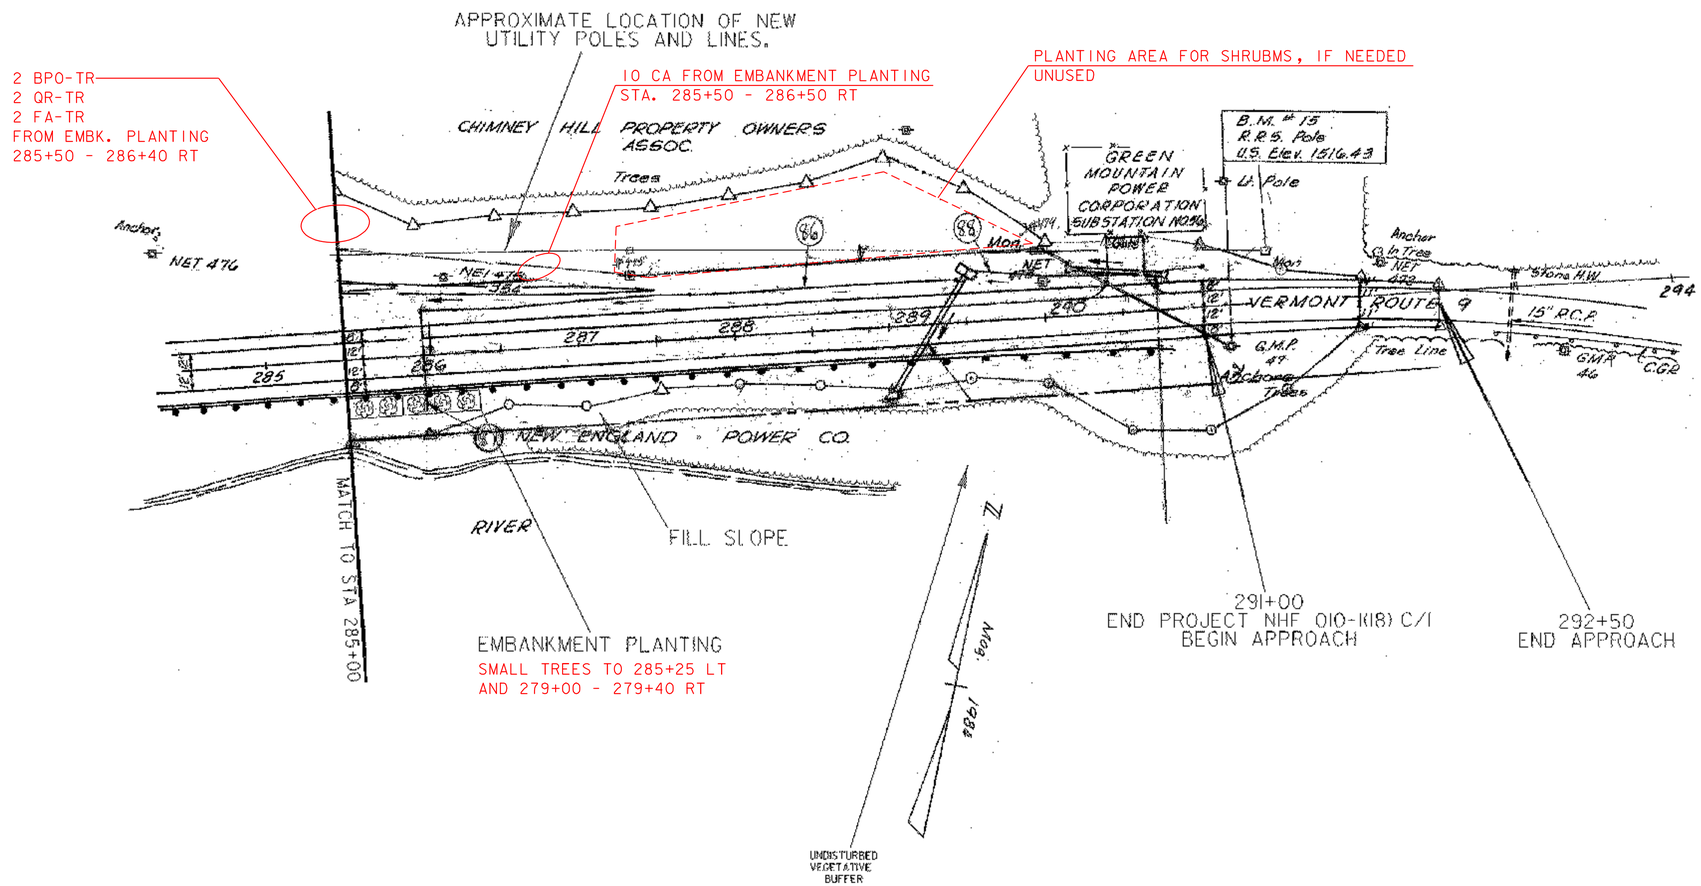

LEGEND

- TYPICAL SHRUB BED
- GROUND COVER & VINES
- EMBANKMENT PLANTING
- PLANTING POCKET
- PLANTING BED OVER GEO-GRID
- PROPOSED DECIDUOUS TREE (SMALL)
- PROPOSED DECIDUOUS TREE
- PROPOSED EVERGREEN TREE
- EDGE OF TREE LINE

*NOTE:
1. EXTRA TOPSOIL SHALL BE USED AT THE DISCRETION OF THE ENGINEER.

0 50 100
SCALE IN FEET

FOR LANDSCAPE ONLY

SHEET NAME: PLAN VIEW SHEET	
PROJECT NAME: SEARSBURG-WILMINGTON	
PROJECT NUMBER: NHF 010-1(18) C-1	
PROJECT LEADER: J. BROWN	DRAWN BY: SQUAD B
DESIGNED BY: J. BROWN	CHECKED BY: SQUAD B
FILE NAME: 78d096/design/landnul.dgn	PLOT DATE: 21-JAN-2004
PARM FILE NAME: land15.I	SHEET 21 OF 30