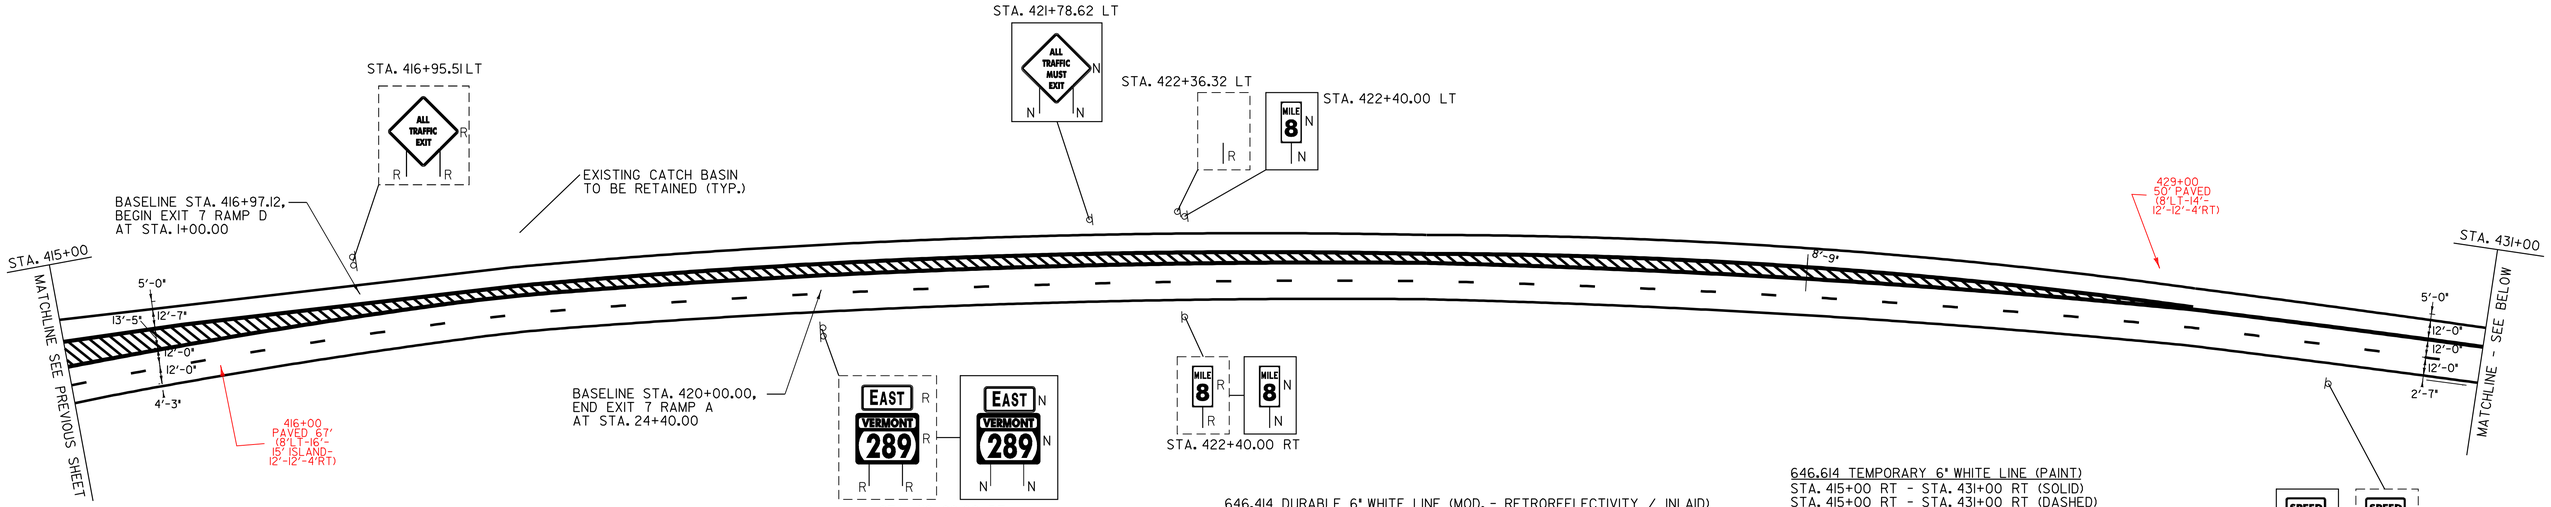

646.414 DURABLE 6" WHITE LINE (MOD. - RETROREFLECTIVITY / INLAID)
STA. 415+00 RT - STA. 431+00 RT (SOLID)
STA. 415+00 RT - STA. 431+00 RT (DASHED)
STA. 1+00 RT - STA. 2+99 RT EXIT 7 RAMP D (SOLID)
STA. 416+93 LT - STA. 431+00 LT (SOLID)

646.415 DURABLE 6" YELLOW LINE (MOD. - RETROREFLECTIVITY / INLAID)
STA. 415+00 - STA. 431+00 (DOUBLE SOLID CENTERLINE)
STA. 1+00 LT - STA. 2+99 LT EXIT 7 RAMP D (DOUBLE SOLID)
STA. 416+93 LT - STA. 429+07 LT (DOUBLE SOLID)

646.45 DURABLE 12" YELLOW LINE (MOD. - RETROREFLECTIVITY / INLAID)
STA. 415+00 - STA. 429+07 (HATCHED)

646.614 TEMPORARY 6" WHITE LINE (PAINT)
STA. 415+00 RT - STA. 431+00 RT (SOLID)
STA. 415+00 RT - STA. 431+00 RT (DASHED)
STA. 1+00 RT - STA. 2+99 RT EXIT 7 RAMP D (SOLID)
STA. 416+93 LT - STA. 431+00 LT (SOLID)

646.615 TEMPORARY 6" YELLOW LINE (PAINT)
STA. 415+00 - STA. 431+00 (DOUBLE SOLID CENTERLINE)
STA. 1+00 LT - STA. 2+99 LT EXIT 7 RAMP D (DOUBLE SOLID)
STA. 416+93 LT - STA. 429+07 LT (DOUBLE SOLID)

646.65 TEMPORARY 12" YELLOW LINE (PAINT)
STA. 415+00 - STA. 429+07 (HATCHED)

675.50 REMOVING SIGN
AS SHOWN - 5

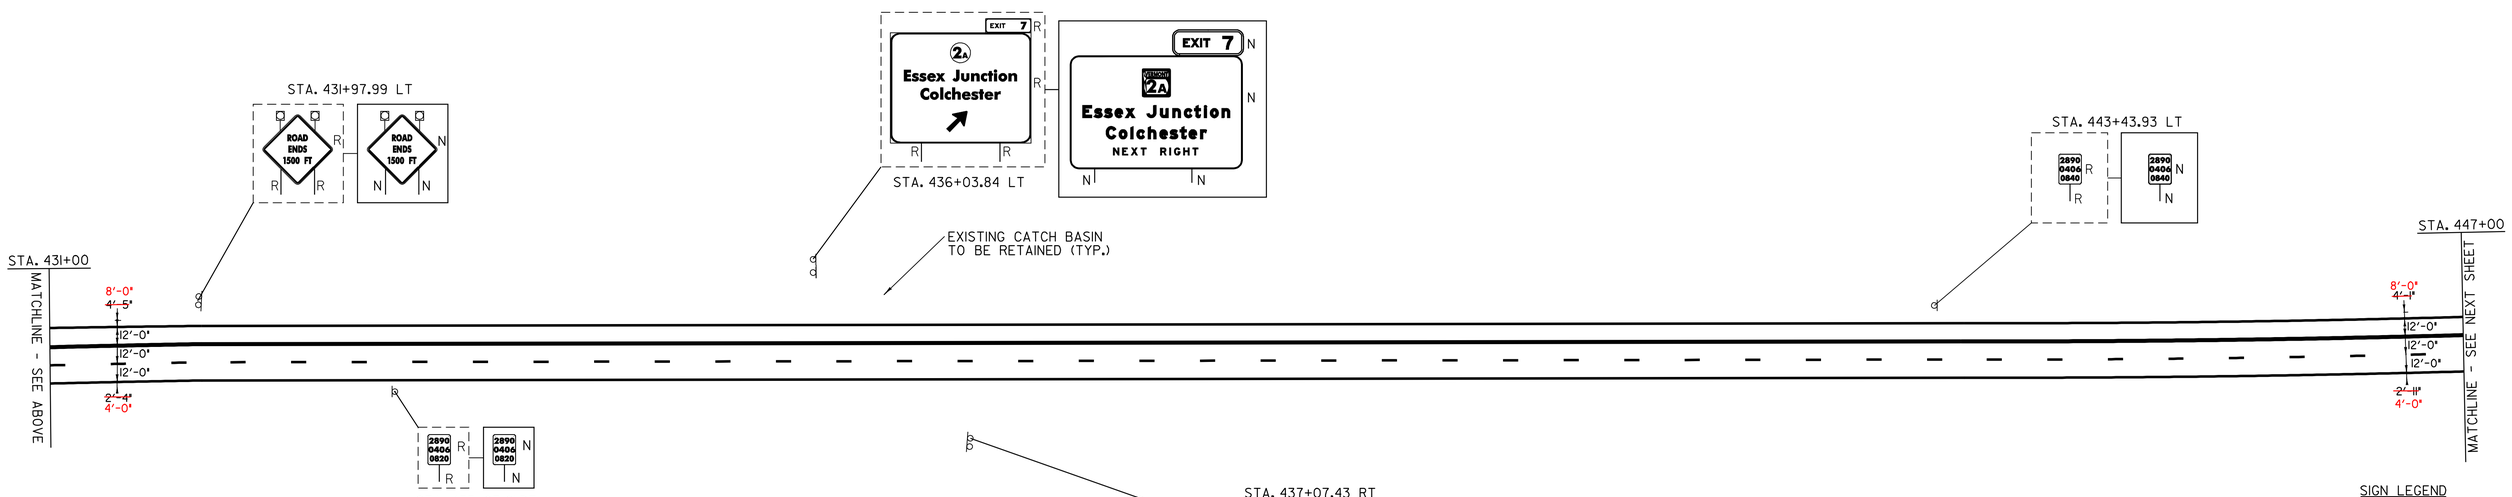

646.414 DURABLE 6" WHITE LINE (MOD. - RETROREFLECTIVITY / INLAID)
STA. 431+00 RT - STA. 447+00 RT (SOLID)
STA. 431+00 RT - STA. 447+00 RT (DASHED)
STA. 431+00 LT - STA. 447+00 LT (SOLID)

646.415 DURABLE 6" YELLOW LINE (MOD. - RETROREFLECTIVITY / INLAID)
STA. 431+00 - STA. 447+00 LT (DOUBLE SOLID)

646.614 TEMPORARY 6" WHITE LINE (PAINT)
STA. 431+00 RT - STA. 447+00 RT (SOLID)
STA. 431+00 RT - STA. 447+00 RT (DASHED)
STA. 431+00 LT - STA. 447+00 LT (SOLID)

646.615 TEMPORARY 6" YELLOW LINE (PAINT)
STA. 431+00 - STA. 447+00 LT (DOUBLE SOLID)

675.50 REMOVING SIGN
AS SHOWN - 5

678.16 FLASHING BEACON - GROUND MOUNTED (MOD.)
STA. 431+97.99 LT (2)

SIGN LEGEND
R = REMOVE
S = SALVAGE
N = NEW
RET = RETAIN
B-B = BACK TO BACK

DATUM
VERTICAL N/A
HORIZONTAL N/A

SCALE 1" = 50'-0
50 0 50

PROJECT LAYOUT SHEET 2

PROJECT NAME: ESSEX
PROJECT NUMBER: NH 2403 (1)S

FILE NAME: pave/04b032/p04b032.dgn
PROJECT LEADER: EPD
DESIGNED BY: JDA
PLOT FILE: p04b032102.1

PLOT DATE: 23-APR-2009 15:4
DRAWN BY: SJB, RHB
CHECKED BY: EPD
SHEET 10 OF 48