STATE OF VERMONT
AGENCY OF TRANSPORTATION

TRAFFIC SIGN SUMMARY SHEET

MILEMARKER, STATION, OR SIGN NUMBER	SIGN LEGEND	SIGN DIMENSIONS EA	WIDTH (in)	HEIGHT (in)	NEW & SALVAGED SIGNS "A"	"B"	SALV SIGN	SALV TIS	EXIST POST RETAIN	EXIST POST SALVAGE	NEW SIGN POSTS NO. OF POSTS	FLANGED CHANNEL lb/ft 1.12	2.0	3.0	SQUARE STEEL (in) lb/ft 1.75 1.88	2.0 2.16	2.5 3.35	ANCHOR	SLEEVE	TUBULAR ALUMINUM Ø (in) lb/ft 3.0 1.3	4.0 1.7	4.0 MOD 1.7	TUBULAR STEEL Ø (in) FOUNDATION	lb/ft 3.0 7.6	3.5 9.0	4.0 10.8	5.0 14.6	W-SHAPE STEEL FTG. SIZE 24"	30"	WEIGHT	POST SIZE	SIGN FRAME REQUIRED	REMARKS	SIGN DETAIL DETAIL ON SHEET NUMBER	STD. SHEET NUMBER
											OPTION ITEMS																									
STA. 495+54.19 LT		1	36	36	9.00						2			X 14/14		X																	W4-1		E-150
STA. 495+70.68 LT		1	6	10	0.42						1	X 8'			X																				E-138
STA. 501+00.00	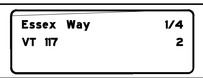	1	240	84		140.00																										MOUNTED ON OVERHEAD BRIDGE	42	
STA. 503+00.00 LT		1	36	48	12.00						2			X 16/16		X																	R2-1		E-142
STA. 505+63.49 RT		1	36	36	9.00						2			X 14/14		X																	W4-3		E-155
STA. 507+80.36 RT		1	6	10	0.42						1	X 8'			X																				E-138
STA. 509+62.09 RT		1	6	10	0.42						1	X 8'			X																				E-138
EXIT 9 RAMP B STA. 1+46.77 LT		1	18	18	2.25						1			X 8'		X																	OMI-1		E-150
EXIT 9 RAMP B STA. 1+71.36 RT		1	36	36	3.75 ~~4.50~~						2			X 14/14		X																	RI-2		E-146
EXIT 9 RAMP B STA. 2+65.42 RT		1	36	36	9.00						2			X 14/14		X																	VR-046		E-142
EXIT 9 RAMP B STA. 7+44.60 RT	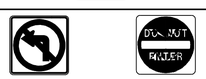	1 1	30 30	30 30	6.25 6.25						1			X 14/14		X																	R3-2 BACK TO BACK R5-1		E-143 E-143
EXIT 9 RAMP C STA. 4+23.80 LT		1	18	18	2.25						1			X 8'		X																	OMI-1		E-150
EXIT 9 RAMP C STA. 4+46.07 LT		1	72	60		30.00					2											2	12/12.25= 184.31 SAY 228 X										E-131
												FT 24.00	FT	FT 195.00	FT 24.00	FT 195.00	FT		EA	LB	LB	LB		LB ~~228~~	LB	LB	LB								
TOTALS		SF ~~61.76~~ 61.16	SF 170.00	EA.	SF				FT ~~219.00~~ 198.00			FT 219.00								LB			EA. 2	LB 228 183.4				EA.	EA.	LB					

FINAL POST LENGTHS ARE TO BE DETERMINED IN THE FIELD. POST SIZES ARE COMPUTED BASED ON INFORMATION FURNISHED ON THE STANDARD SHEETS AND THE TRAFFIC & SAFETY DIVISION'S "SIGN POST DESIGN GUIDELINE."

TRAFFIC SIGN SUMMARY SHEET 5

PROJECT NAME: ESSEX
PROJECT NUMBER: NH 2403 (1)S

FILE NAME: pave/04b032/p04b032.dgn
PROJECT LEADER: EPD
DESIGNED BY: JDA
PLOT FILE: p04b032ss5.1

PLOT DATE: 23-APR-2009 15:5
DRAWN BY: SJB, RHB
CHECKED BY: EPD
SHEET 28 OF 48