STATE OF VERMONT
AGENCY OF TRANSPORTATION

TRAFFIC SIGN SUMMARY SHEET

MILEMARKER, STATION, OR SIGN NUMBER	SIGN LEGEND	SIGN DIMENSIONS EA	WIDTH (in)	HEIGHT (in)	NEW & SALVAGED SIGNS "A"	"B"	SALV SIGN	SALV TIS	EXIST POST RETAIN	EXIST POST SALVAGE	NEW SIGN POSTS NO. OF POSTS	FLANGED CHANNEL lb/ft 1.12	FLANGED CHANNEL lb/ft 2.0	FLANGED CHANNEL lb/ft 3.0	SQUARE STEEL (in) 1.75 lb/ft 1.88	SQUARE STEEL (in) 2.0 lb/ft 2.16	SQUARE STEEL (in) 2.5 lb/ft 3.35	ANCHOR	SLEEVE	TUBULAR ALUMINUM Ø (in) 3.0 lb/ft 1.3	TUBULAR ALUMINUM Ø (in) 4.0 lb/ft 1.7	TUBULAR ALUMINUM Ø (in) 4.0 MOD lb/ft 1.7	TUBULAR STEEL Ø (in) FOUNDATION	TUBULAR STEEL Ø (in) 3.0 lb/ft 7.6	TUBULAR STEEL Ø (in) 3.5 lb/ft 9.0	TUBULAR STEEL Ø (in) 4.0 lb/ft 10.8	TUBULAR STEEL Ø (in) 5.0 lb/ft 14.6	W-SHAPE STEEL FTG. SIZE 24"	W-SHAPE STEEL FTG. SIZE 30"	W-SHAPE STEEL WEIGHT	W-SHAPE STEEL POST SIZE	SIGN FRAME REQUIRED	REMARKS	SIGN DETAIL DETAIL ON SHEET NUMBER	SIGN DETAIL STD. SHEET NUMBER
														OPTION ITEMS																							
EXIT 9 RAMP C STA. 5+61.75 RT		1	36	36	9.00						2			X 14/14		X																W3-3		E-152
EXIT 9 RAMP C STA. 6+89.48 RT	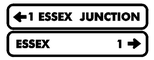	1 1	72 72	12 12	6.00 6.00						2			X 14/14		X																DI-1		E-123
EXIT 9 RAMP C STA. 8+54.39 RT		1 1 1	24 24 21	12 24 15	2.00 4.00 2.19						2			X 16/16		X															X	M3-4 M6-1		E-136B E-136B E-136B
		1 1 1	24 24 21	12 24 15	2.00 4.00 2.19																										M3-2 M6-2R		E-136B E-136B E-136B
EXIT 9 RAMP C STA. 8+83.11 LT, RT		2	36	24	12.00						4			14/14 X 14/14		X																R5-1A		E-143
EXIT 9 RAMP C STA. 10+96.18 LT		1 1 1	30 36 36	30 12 12	6.25 3.00 3.00						1			X 14'		X																R5-1 R6-1R BACK TO BACK R6-1L		E-143 E-142 E-142
EXIT 9 RAMP C STA. 11+11.56 RT		1 1 1	30 36 36	30 12 12	6.25 3.00 3.00						1			X 14'		X																R5-1 R6-1R BACK TO BACK R6-1L		E-143 E-142 E-142
EXIT 9 RAMP C STA. 11+40.38 RT		1 1	30 30	30 30	6.25 6.25						1			X 14'		X																R5-1 BACK TO BACK R1-1		E-143 E-143
	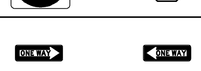	1 1	36 36	12 12	3.00 3.00																											R6-1R BACK TO BACK R6-1L		E-142 E-142
EXIT 9 RAMP D STA. 1+72.32 LT		1	18	18	2.25						1			X 8'		X																OM1-1		E-150
EXIT 9 RAMP D STA. 1+98.31 LT		1 1 1	24 24 21	12 24 15	2.00 4.00 2.19						2			X 14/14		X															X	M3-2 M6-1		E-136B E-136B E-136B
		1 1 1	24 24 21	12 24 15	2.00 4.00 2.19																											M3-4 M6-1		E-136B E-136B E-136B
												FT	FT	FT 255.00	FT	FT 255.00	FT		EA	LB	LB	LB		LB	LB	LB	LB								
TOTALS		SF 113.26	SF	EA.	SF							FT ~~255.00~~ 230.00			FT ~~255.00~~				LB	EA.	LB			EA.	EA.	LB								

FINAL POST LENGTHS ARE TO BE DETERMINED IN THE FIELD. POST SIZES ARE COMPUTED BASED ON INFORMATION FURNISHED ON THE STANDARD SHEETS AND THE TRAFFIC & SAFETY DIVISION'S "SIGN POST DESIGN GUIDELINE."

TRAFFIC SIGN SUMMARY SHEET 6

PROJECT NAME: ESSEX
PROJECT NUMBER: NH 2403 (1)S

FILE NAME: pave/04b032/p04b032.dgn
PROJECT LEADER: EPD
DESIGNED BY: JDA
PLOT FILE: p04b032ss6.i

PLOT DATE: 23-APR-2009 15:5
DRAWN BY: SJB, RHB
CHECKED BY: EPD
SHEET 29 OF 48