TEMPORARY AND DURABLE 4" WHITE LINE

STA	87+75	TO	88+37	SOLID	RT
STA	87+75	TO	90+00	SOLID	LT
STA	88+59	TO	90+00	SOLID	RT

TEMPORARY AND DURABLE 4" YELLOW LINE

STA	87+75	TO	88+54	SOLID LT & RT
STA	88+74	DOUBLE SOLID RT (TH 758)		
STA	88+94	TO	90+00	SOLID LT & RT

TEMPORARY AND DURABLE 24" STOP BAR

STA 88+74 RT (TH 758)

TEMPORARY AND DURABLE LETTER OR SYMBOL

STA 88+81 RT - "STOP" (TH 758)

REMOVING SIGNS

AS SHOWN - 1

CHANGE ELEV. OF SMH
STA. 89+74 RT

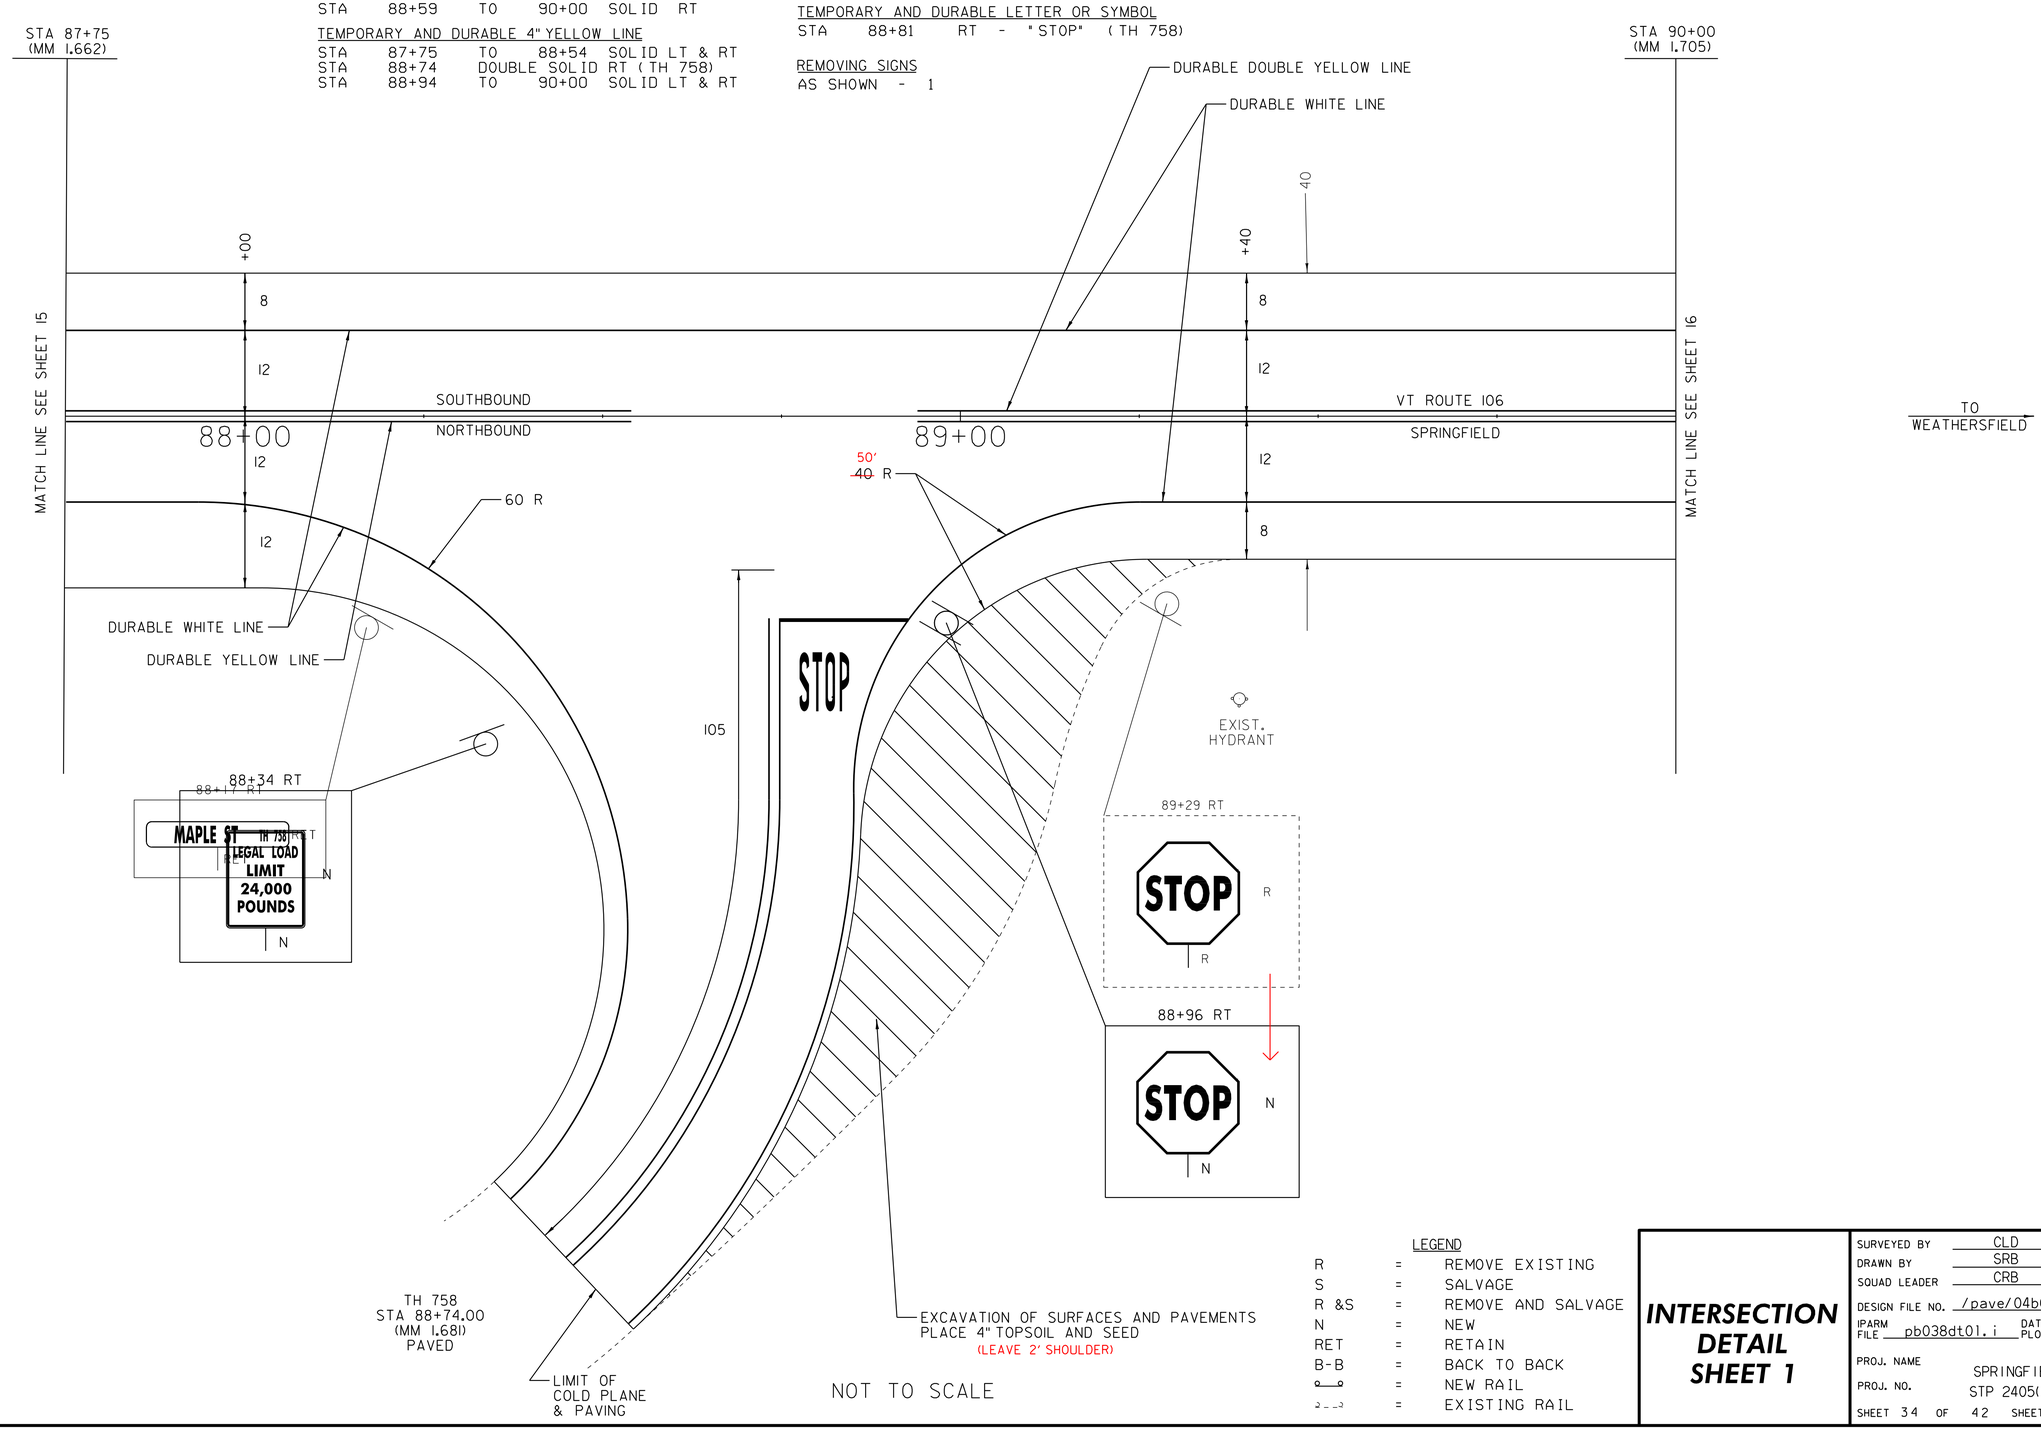

NOT TO SCALE

LEGEND

R	=	REMOVE EXISTING
S	=	SALVAGE
R &S	=	REMOVE AND SALVAGE
N	=	NEW
RET	=	RETAIN
B-B	=	BACK TO BACK
o—o	=	NEW RAIL
›_ _‹	=	EXISTING RAIL

DATUM
VERTICAL N/A
HORIZONTAL N/A

INTERSECTION DETAIL SHEET 1

SURVEYED BY CLD DATE
DRAWN BY SRB DATE 5/05
SQUAD LEADER CRB
DESIGN FILE NO. /pave/04b038/pb038.dgn
IPARM FILE pb038dt01.i DATE PLOTTED 10-JUN-2012 08
PROJ. NAME SPRINGFIELD
PROJ. NO. STP 2405(1)S
SHEET 34 OF 42 SHEETS