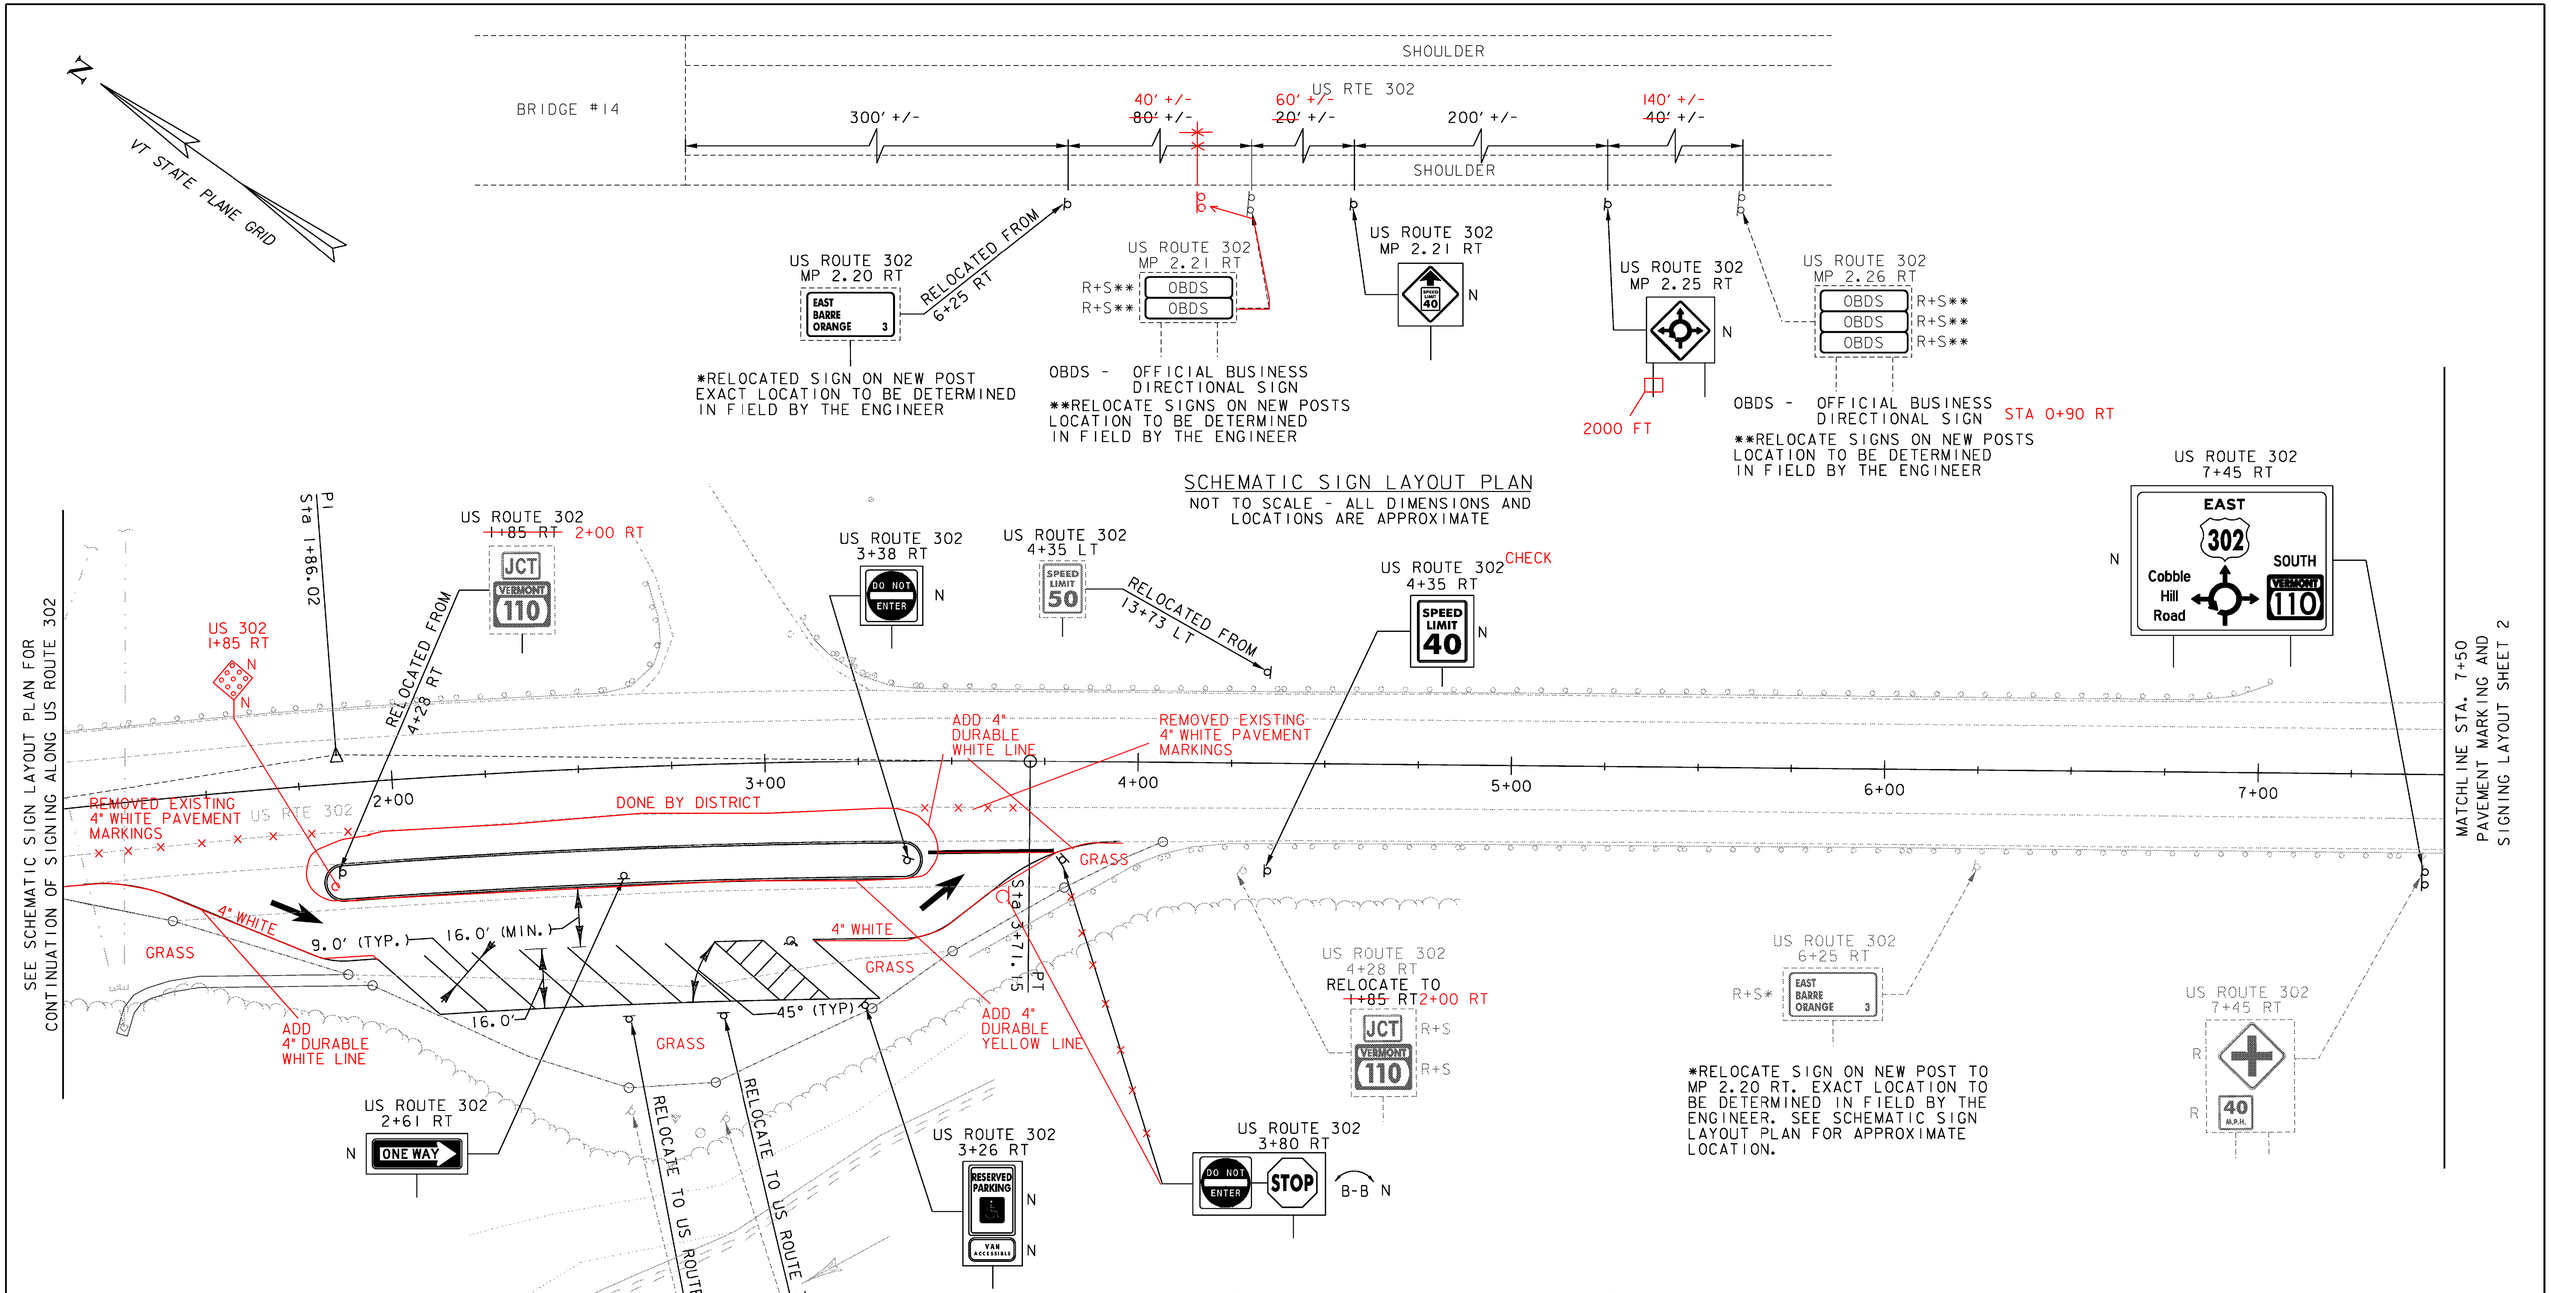

0 20 40
SCALE IN FEET

DATUM

VERTICAL	NAVD 88
HORIZONTAL	NAD 83 (1996)

SIGN LEGEND

- = EXISTING SIGN AND POST
- = NEW SIGN W/ NEW POST
- R = REMOVE EXISTING SIGN AND POST
- R+S = SALVAGE SIGN AND RELOCATE TO NOTED LOCATION WITH NEW SIGN POST. REMOVE AND DISPOSE EXISTING SIGN POST
- N = NEW
- RET = RETAIN AT EXISTING LOCATION
- B-B = BACK TO BACK

NOTES:
THE EXACT LOCATION OF THE PROPOSED SIGNS TO BE DETERMINED IN THE FIELD BY THE ENGINEER.

DURABLE 4 INCH WHITE LINE
US ROUTE 302 2+05 ~ 3+16 RT
8 PARKING LINE (23' EACH) - 184 L.F.
US ROUTE 302 2+85 ~ 3+16 RT
GORE MARKINGS FOR ACCESSIBLE AREA - 45 L.F.

DURABLE 24 INCH STOP BAR
US ROUTE 302 3+44 ~ 3+78 RT - 34 L.F.

DURABLE LETTER OR SYMBOL
US ROUTE 302 1+72 RT QTY=1
1- THRU ARROW
US ROUTE 302 3+06 RT QTY=1
1- HANDICAP PARKING SYMBOL
US ROUTE 302 3+48 RT QTY=1
1- THRU ARROW

REMOVAL OF EXISTING PAVEMENT MARKINGS
US ROUTE 302 1+14 RT ~ 1+85 RT
US ROUTE 302 3+39 RT ~ 3+95 RT

REMOVING SIGNS
13 EACH

ERECTING SALVAGED SIGNS
12 EACH

PAVEMENT MARKING AND SIGNING LAYOUT SHEET 1

PROJECT NAME: BARRE TOWN
PROJECT NUMBER: HES 026-1(38)

FILE NAME: z04b198trfbdr.dgn
PROJECT LEADER: JOSHUA SCHULTZ
DESIGNED BY: J. FORD
PLOT DATE: 1/30/2008
DRAWN BY: V.KACOYANNAKIS
CHECKED BY: J.FORD
SHEET 35 OF 64