


**REMOVING SIGNS**  
40 EACH  
**ERECTING SALVAGED SIGNS**  
6 EACH  
**DURABLE LETTER OR SYMBOL**  
US ROUTE 302 QTY = 15 EA.  
15- 'SHARKS TEETH'- YIELD SYMBOLS  
COBBLE HILL ROAD QTY = 6 EA.  
6 - 'SHARKS TEETH'- YIELD SYMBOLS  
VT 110 QTY = 11EA.  
8 - 'SHARKS TEETH'- YIELD SYMBOLS  
**DURABLE 8 INCH WHITE LINE**

US ROUTE 302 13+75 RT ~ 14+43 RT, R=288', 11X2' = 22 LF  
US ROUTE 302 13+75 LT ~ 14+61 LT, 15X2' = 30 LF  
US ROUTE 302 16+57 LT ~ 17+00 LT, 8X2' = 16 LF  
US ROUTE 302 16+68 RT ~ 17+00 RT, R=550', 5X2' = 10 LF  
US ROUTE 302 14+80 RT ~ 14+81 LT - R = 62.50', 30 LF  
US ROUTE 302 15+23 RT ~ 15+43 RT - R = 62.50', 45 LF  
US ROUTE 302 15+25 LT ~ 15+66 LT - R = 62.50', 20 LF  
US ROUTE 302 16+00 RT ~ 16+02 LT - R = 62.50', 35 LF

**DURABLE 8 INCH YELLOW LINE**  
US ROUTE 302 14+00 RT ~ 14+80 RT - R = 99', 82 LF  
US ROUTE 302 14+00 LT ~ 14+81 LT - R = 287', 84 LF  
US ROUTE 302 14+20 LT ~ 14+39 RT, 9 LF - GORE MARKS  
US ROUTE 302 16+00 RT ~ 16+15 RT - R = 128', 18 LF  
US ROUTE 302 16+02 LT ~ 16+16 LT - R = 150', 15 LF  
US ROUTE 302 16+25 RT ~ 16+68 RT - R = 128', 44 LF  
US ROUTE 302 16+25 LT ~ 16+68 LT - R = 150', 44 LF  
US ROUTE 302 16+42 RT ~ 16+60 LT, 10 LF - GORE MARKS  
VT 110 53+00 RT ~ 53+10 RT - R = 334', 11LF  
VT 110 53+00 LT ~ 53+09 LT - R = 472', 10 LF  
TH 30 54+30 RT ~ 54+63 RT - R = 62', 34 LF  
TH 30 54+30 LT ~ 54+63 LT - R = 62', 34 LF  
TH 30 54+44 LT ~ 54+57 RT, - 10 LF - GORE MARKS  
EDGE OF TRUCK APRON, R = 45.00', 282 LF

**DURABLE 12 INCH WHITE LINE**  
US ROUTE 302 14+80 RT ~ 14+92 RT  
R = 62.50, 5 X 3' = 15 LF  
US ROUTE 302 15+92 LT ~ 16+01 LT  
R = 62.50, 4 X 3' = 12 LF  
VT 110 53+12 RT ~ 53+27 RT  
R = 62.50, 5 X 3' = 15 LF  
TH 30 54+22 LT ~ 54+30 LT  
R = 62.50, 4 X 3' = 12 LF

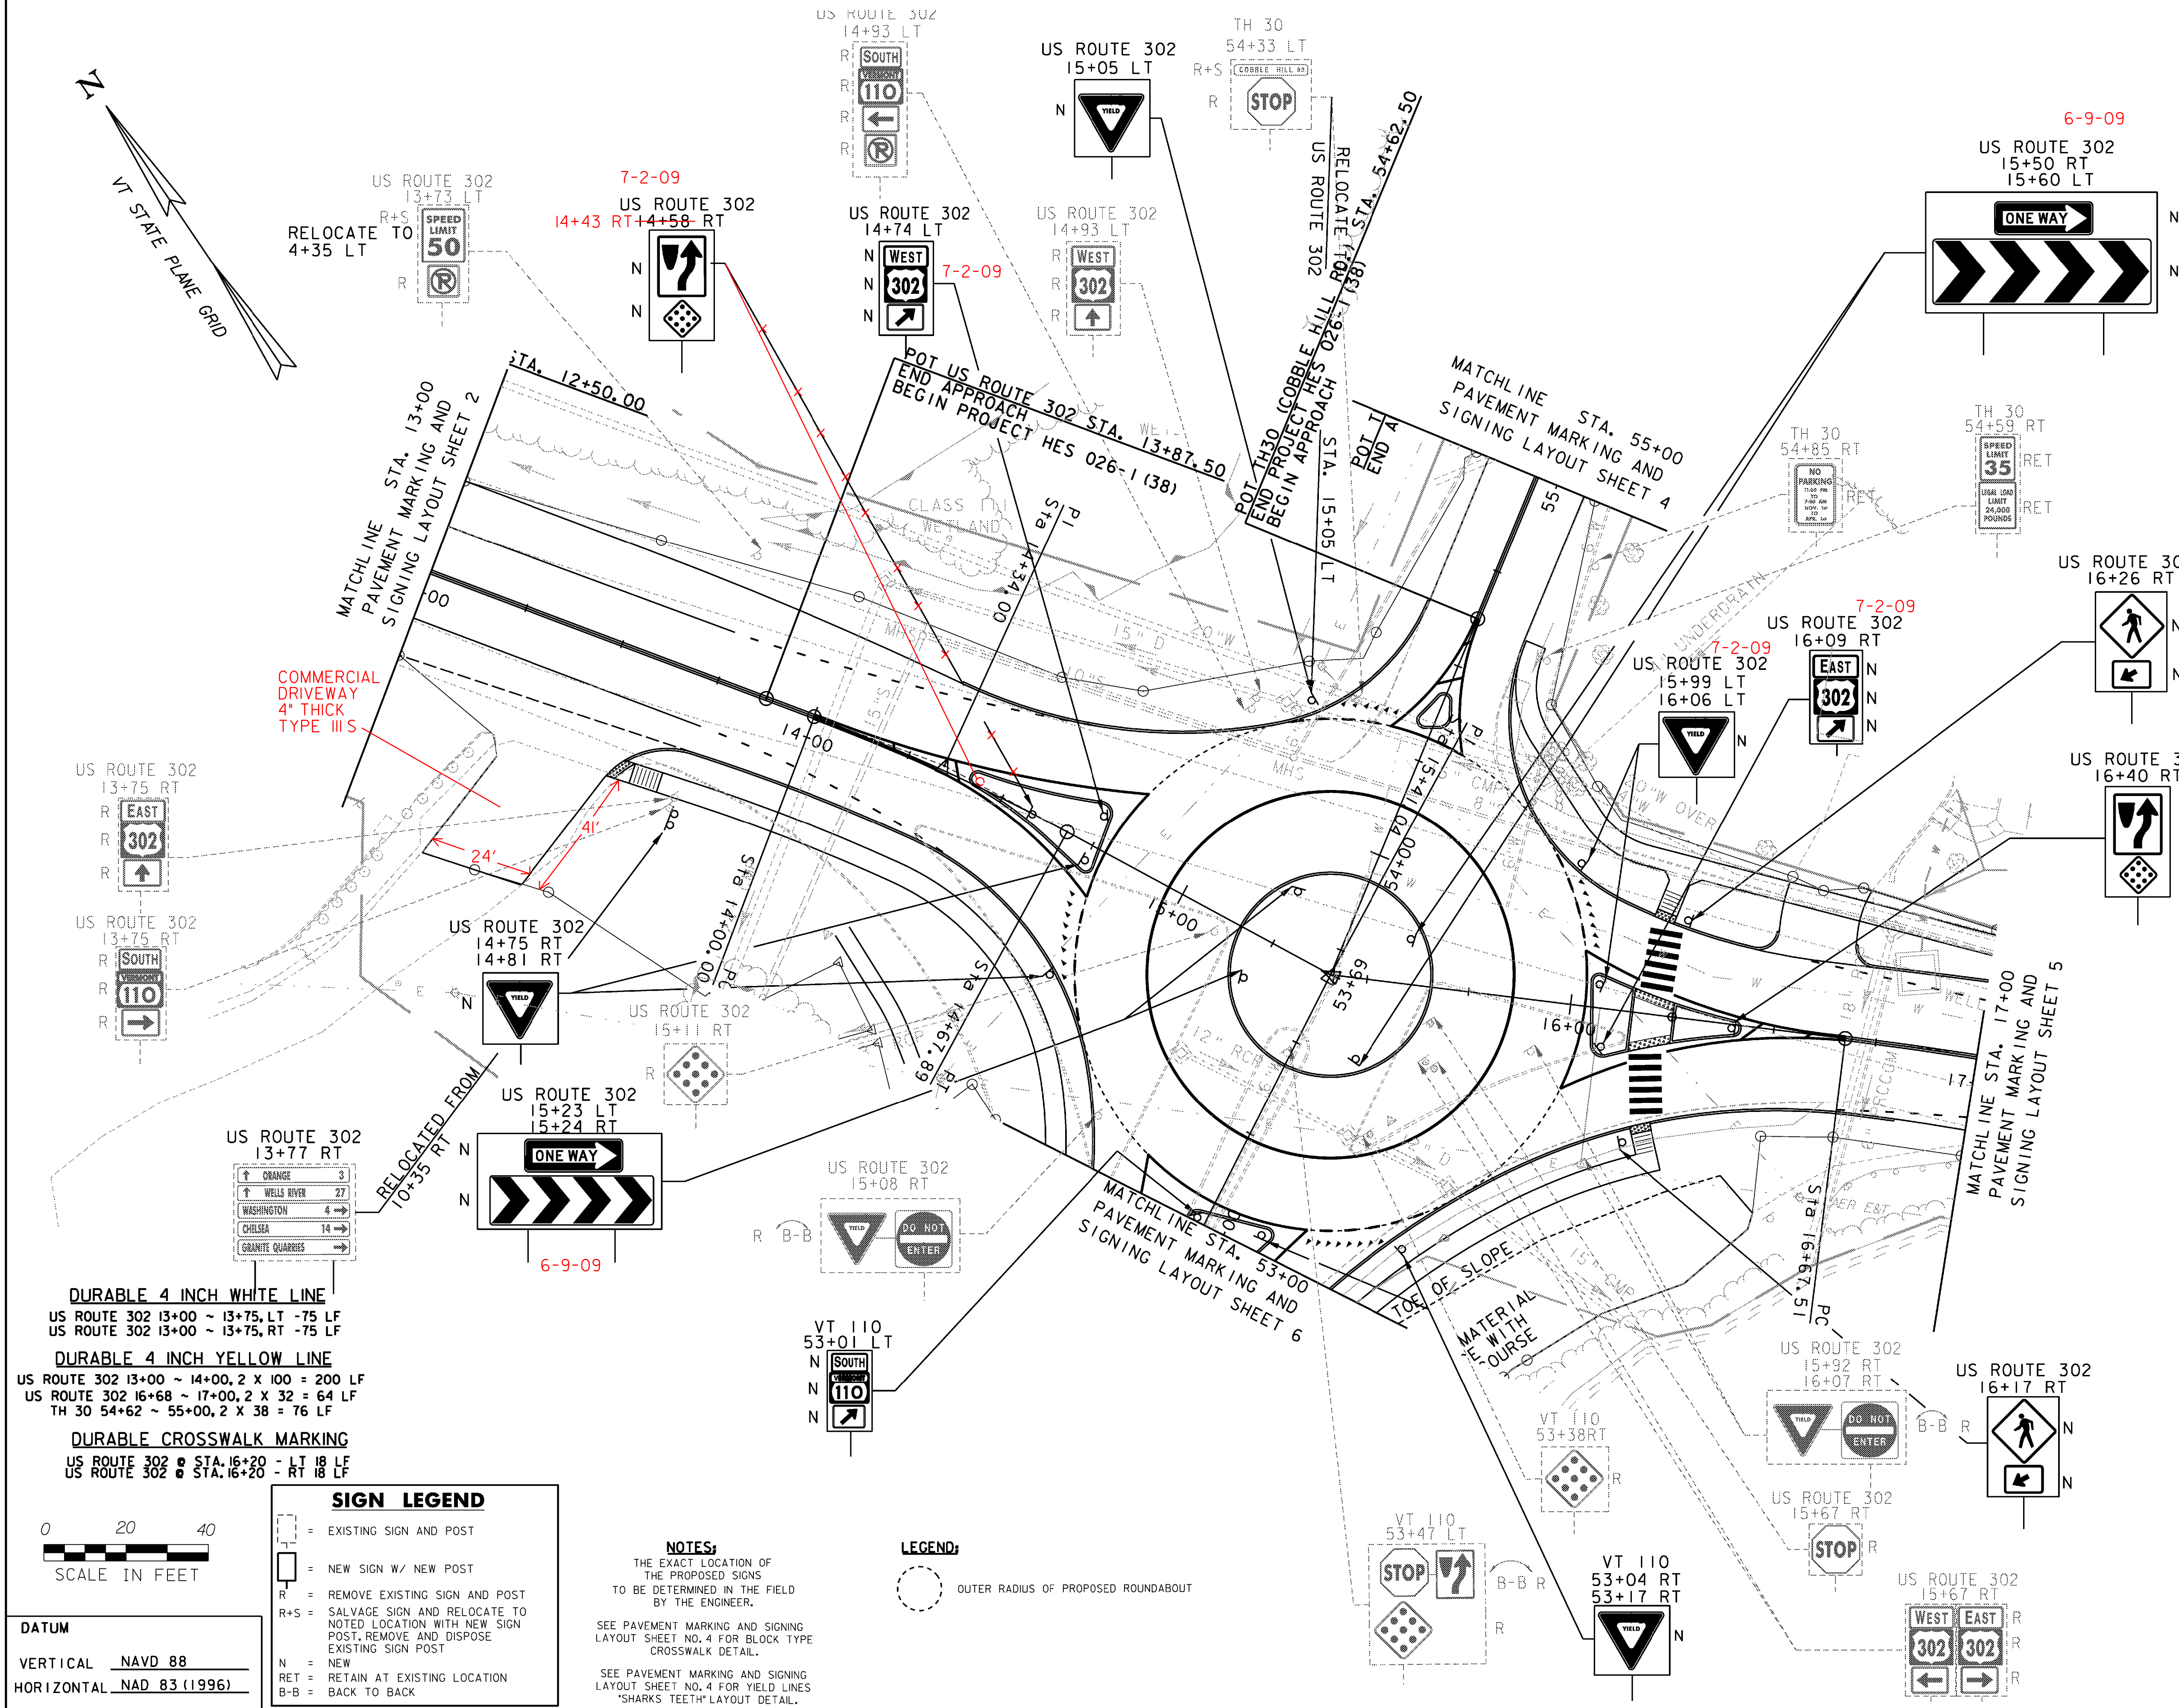

**DURABLE 4 INCH WHITE LINE**  
US ROUTE 302 13+00 ~ 13+75, LT - 75 LF  
US ROUTE 302 13+00 ~ 13+75, RT - 75 LF

**DURABLE 4 INCH YELLOW LINE**  
US ROUTE 302 13+00 ~ 14+00, 2 X 100 = 200 LF  
US ROUTE 302 16+68 ~ 17+00, 2 X 32 = 64 LF  
TH 30 54+62 ~ 55+00, 2 X 38 = 76 LF

**DURABLE CROSSWALK MARKING**  
US ROUTE 302 @ STA. 16+20 - LT 18 LF  
US ROUTE 302 @ STA. 16+20 - RT 18 LF

**SIGN LEGEND**

- = EXISTING SIGN AND POST
- = NEW SIGN W/ NEW POST
- R = REMOVE EXISTING SIGN AND POST
- R+S = SALVAGE SIGN AND RELOCATE TO NOTED LOCATION WITH NEW SIGN POST. REMOVE AND DISPOSE EXISTING SIGN POST
- N = NEW
- RET = RETAIN AT EXISTING LOCATION
- B-B = BACK TO BACK

**NOTES:**  
THE EXACT LOCATION OF THE PROPOSED SIGNS TO BE DETERMINED IN THE FIELD BY THE ENGINEER.

**LEGEND:**  
 OUTER RADIUS OF PROPOSED ROUNDABOUT

**DATUM**  
VERTICAL NAVD 88  
HORIZONTAL NAD 83 (1996)



**PAVEMENT MARKING AND SIGNING LAYOUT SHEET 3**

PROJECT NAME: BARRE TOWN  
PROJECT NUMBER: HES 026-1(38)

FILE NAME: z04b198trfbd.rgn  
PROJECT LEADER: JOSHUA SCHULTZ  
DESIGNED BY: J.FORD

PLOT DATE: 1/30/2008  
DRAWN BY: V.KACOYANNAKIS  
CHECKED BY: J.FORD  
SHEET 37 OF 64