INDEX OF SHEETS (COMPOSITE)

1.	COMPOSITE TITLE SHEET
2-3.	COMPOSITE QUANTITY SHEETS
4.	BLANK
5.	CASTLETON-SUDBURY ACSTP 2402(1)S TITLE SHEET
6.	INDEX OF SHEETS
7.	PROJECT TYPICAL SHEET
8.	PAVING DETAILS SHEET
9-10.	QUANTITY SHEETS
11.	ITEM DETAIL SUMMARY SHEET
12.	DITCH CLEANING DETAIL SHEET
13-37.	LAYOUT SHEETS
38-39.	INTERSECTION DETAIL SHEETS
40-48.	TRAFFIC SIGN SUMMARY SHEETS
49.	MISCELLANEOUS DETAILS SHEET
50.	CONSTRUCTION APPROACH SIGNING DETAIL SHEET
51-55.	BLANK
56.	HUBBARDTON STPST0161(23) TITLE SHEET
57.	INDEX OF SHEETS
58.	TYPICAL ROADWAY SECTIONS SHEET
59.	CONSTRUCTION TRANSITION DETAIL SHEET
60.	QUANTITY SHEET
61-67.	PLAN AND PROFILE SHEETS
68-69.	GUARDRAIL DETAIL SHEETS
70-72.	TRAFFIC SIGNS AND LINES PLAN SHEETS
73.	TRAFFIC SIGN SUMMARY SHEET
74.	EROSION PREVENTION AND SEDIMENT CONTROL (EPSC) NARRATIVE
75-77.	EROSION PREVENTION AND SEDIMENT CONTROL (EPSC) PLAN SHEETS
78.	EROSION PREVENTION AND SEDIMENT CONTROL (EPSC) GENERAL NOTES
79-92.	CROSS SECTIONS

STATE OF VERMONT
AGENCY OF TRANSPORTATION

PROPOSED IMPROVEMENT
TOWNS OF CASTLETON, HUBBARDTON & SUDBURY
COUNTY OF RUTLAND
VT. ROUTE 30

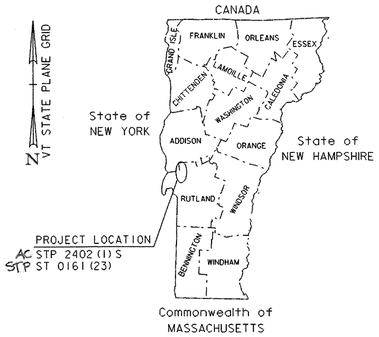

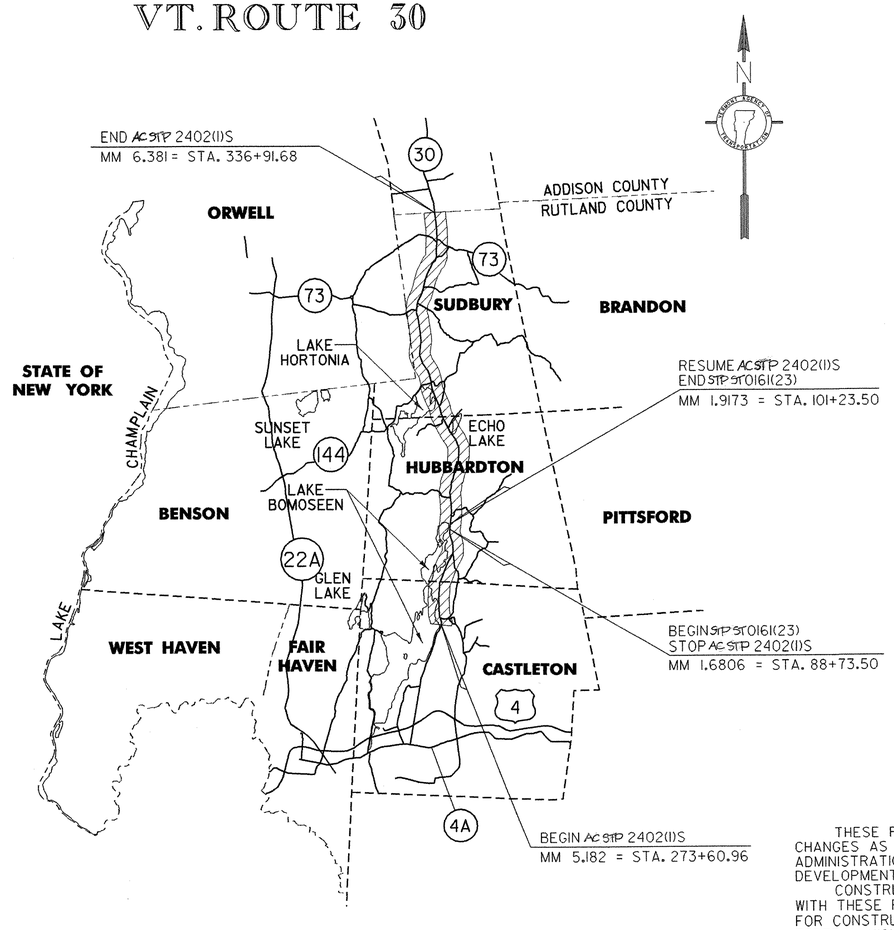

VAOT STANDARDS (COMPOSITE)

B-71	RESIDENTIAL AND COMMERCIAL DRIVES	07-08-05
D-6	REINFORCED CONCRETE DROP INLET W/ GRATE (DITCHES)	06-01-94
D-9	REINFORCED CONCRETE DROP INLET TOPS	06-01-94
D-11	GRATES & COVERS (TYPE A)	06-01-94
D-15	CAST IRON GRATE WITH FAME, TYPE D	06-01-94
E-100	CONSTRUCTION APPROACH SIGNS	01-02-04
E-101	CONSTRUCTION SIGN DETAILS	05-30-03
E-102	CONSTRUCTION SIGN DETAILS	06-30-03
E-102A	CONSTRUCTION SIGN DETAILS	05-01-04
E-103	MAINLINE TRAFFIC CONTROL DIVIDED HIGHWAY ONE LANE CLOSED	03-01-04
E-106	TRAFFIC CONTROL - MISCELLANEOUS DETAILS	03-01-04
E-107A	BREAKAWAY BARRICADE DETAILS	08-08-95
E-108	CONSTRUCTION ZONE LONGITUDINAL DROP OFFS	08-18-95
E-110	MAJOR MAINTENANCE OPERATION LANE CLOSURE	08-08-95
E-111	MINOR MAINTENANCE OPERATION	03-11-97
E-121	STANDARD SIGN PLACEMENT - CONVENTIONAL ROAD	08-08-95
E-123	GUIDE SIGN PLACEMENT - MISCELLANEOUS DETAILS	03-16-04
E-136B	STATE ROUTE MARKER DETAILS	08-08-95
E-138	MILE MARKER DETAILS - STATE & TOWN HIGHWAYS	05-30-03
E-141	REGULATORY SIGNS DETAILS	09-20-95
E-143	REGULATORY SIGNS DETAILS	06-15-04
E-152	WARNING SIGN DETAILS	05-01-04
E-155	WARNING SIGN DETAILS	05-01-04
E-160	FLANGED CHANNEL STEEL SIGN POST	05-20-99
E-163	TUBULAR STEEL SIGN POST	05-20-99
E-164	SQUARE STEEL SIGN POST	05-20-99
E-191	PAVEMENT MARKING DETAILS	02-01-99
E-193	PAVEMENT MARKING DETAILS	08-18-95
E-197	DELINEATOR PLACEMENT TYPICAL	04-01-05
E-198	DELINEATORS AND MILE POSTS	04-01-05
E-199	DELINEATOR AND MILEPOST MOUNTING ON BRIDGE RAIL	04-01-05
G-1	STEEL BEAM GUARDRAIL WITH STEEL POSTS	01-03-00
G-1B	BOX BEAM GUARD RAIL	06-01-94
G-1D	ANCHOR FOR STEEL BEAM GUARDRAIL	01-03-00
G-19	GENERIC GRADING PLANS FOR GUARDRAIL END TERMINALS	11-15-02
J-3	MAILBOX SUPPORT DETAILS	08-07-95

RECORD PLANS

CONTRACTOR: FW WHITCOMB CONSTRUCTION CORP. – WALPOLE, NH

RESIDENT ENGINEER: DAVE HOSKING

CONSTRUCTION BEGAN: JUNE 19, 2006

CONSTRUCTION COMPLETE: NOVEMBER 8, 2006

RECORD PLANS BY: DAVE HOSKING & JUDY. GILMORE

I HEREBY CERTIFY THAT ALL THE CONSTUCTION REQUIRED BY THIS SET OF DRAWINGS HAS BEEN ACCOMPLISHED AS INDICATED HEREIN.

BY Dave Hosking RESIDENT ENGINEER

DATE 4/6/07

NOTE: Any further information concerning final quantities, amounts or other details relative to this project may be found at Central Files in the electronic archives.

CONVENTIONAL SYMBOLS

COUNTY LINE
TOWN LINE
LIMITS OF ACCESS
POINT OF ACCESS
FENCE LINE
STONE WALL
TRAVELED WAY
GUARD RAIL
RAILROAD
SURVEY LINE
CULVERT
POWER POLE
TELEPHONE POLE
TREES
CONTROL OF ACCESS
PROPERTY LINE
R.O.W. TAKING LINE
SLOPE RIGHTS (SR SR SR)
TOP OF CUT
TOE OF SLOPE

SURVEYED BY : NA
SURVEYED DATE : NA

DATUM
VERTICAL NA
HORIZONTAL NA

THESE PLANS ARE SUBJECT TO SUCH ENGINEERING CHANGES AS MAY BE REQUIRED BY THE FEDERAL HIGHWAY ADMINISTRATION OR THE DIRECTOR OF PROGRAM DEVELOPMENT.

CONSTRUCTION IS TO BE CARRIED ON IN ACCORDANCE WITH THESE PLANS AND THE STANDARD SPECIFICATIONS FOR CONSTRUCTION DATED 2001, AS APPROVED BY THE FEDERAL HIGHWAY ADMINISTRATION ON JANUARY 4, 2001 FOR USE ON THIS PROJECT, INCLUDING ALL SUBSEQUENT REVISIONS AND SUCH REVISED SPECIFICATIONS AND SPECIAL PROVISIONS AS ARE INCORPORATED IN THESE PLANS.

IPARM NAME: 03c044-04c028ttl.i
/03c044/Design/03c044-04c028.dgn

DIRECTOR OF PROGRAM DEVELOPMENT
APPROVED Peter Jeffrey DATE 3-21-06

PROJECT NAME : CASTLETON-SUDBURY/HUBBARDTON
PROJECT NUMBER : ACSTP 2402(1)S
STP ST 0161(23)
SHEET 1 OF 92 SHEETS