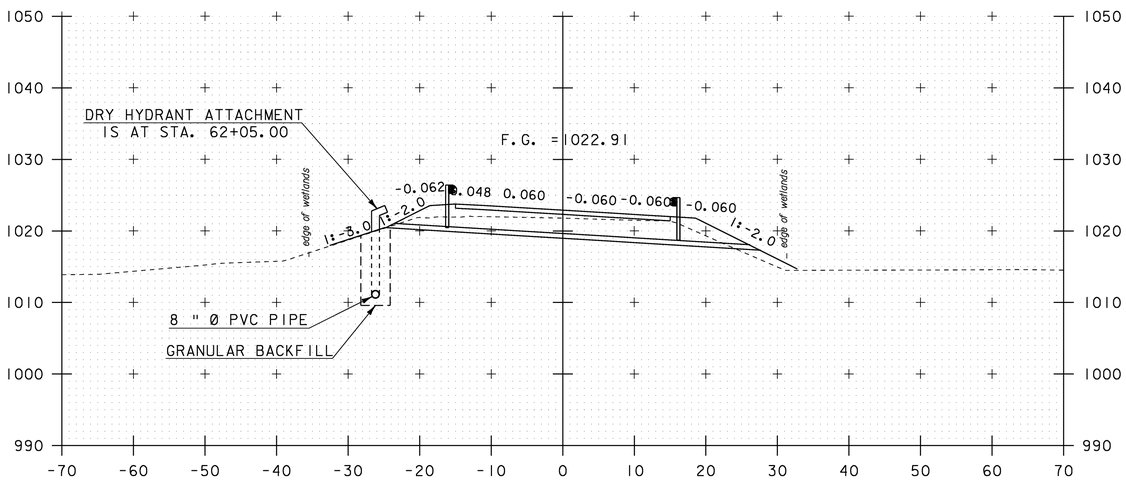

STA. 62+05 LT
END DRY HYDRANT

62+00

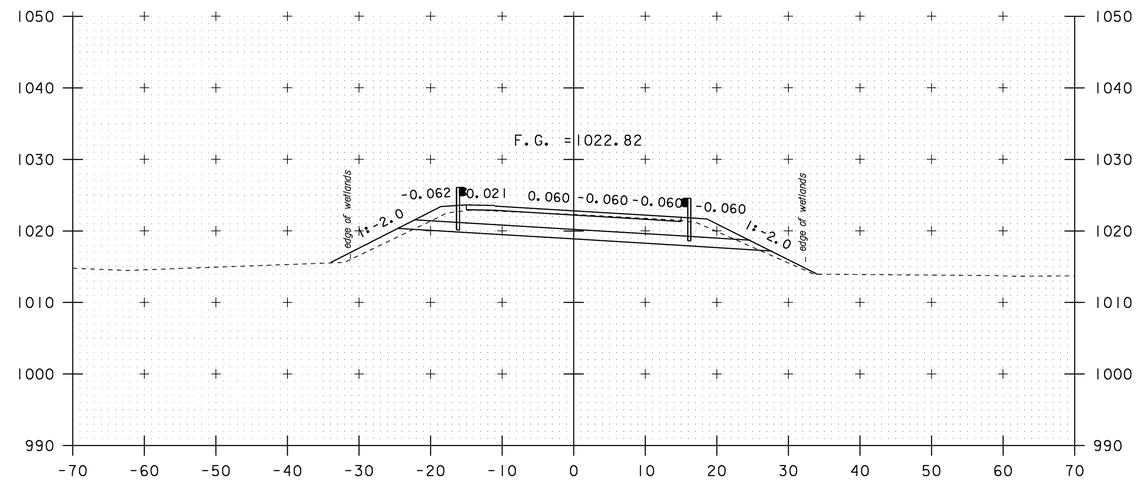

62+50

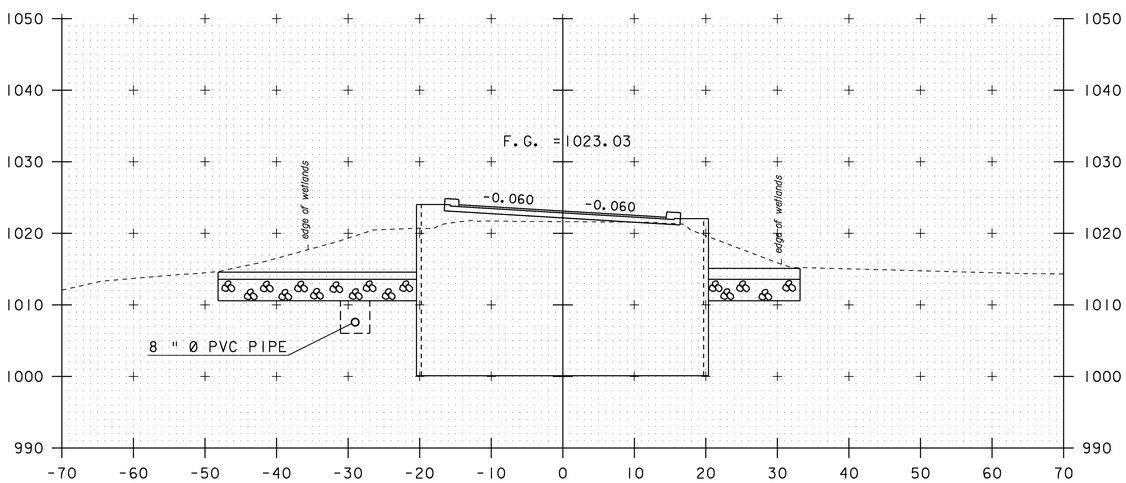

STA. 61+76
END BRIDGE

61+75

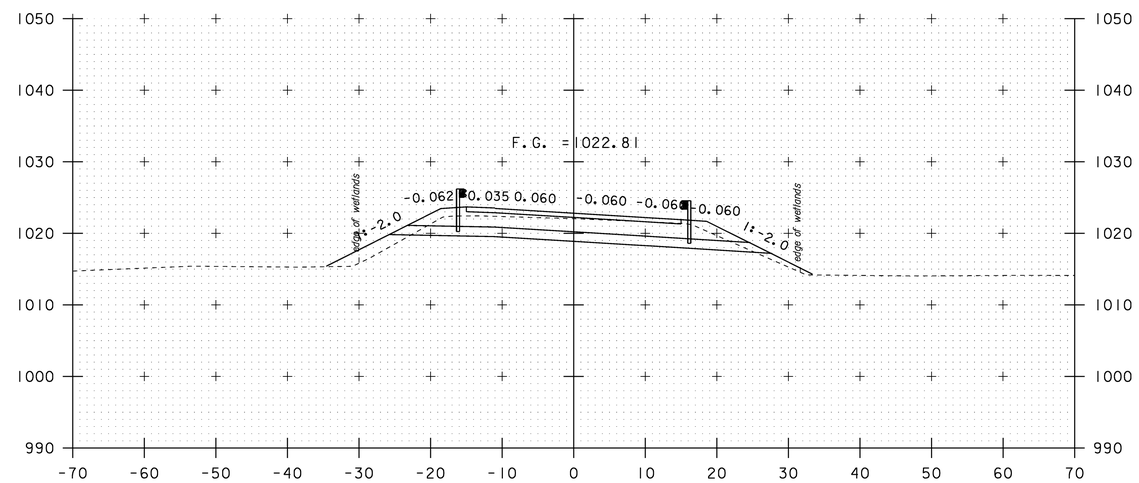

62+25

SCALE 1" = 10'-0
10 0 10

VT 102 CROSS SECTIONS (6)

PROJECT NAME:	CANAAN
PROJECT NUMBER:	ER ST 0271(16)

FILE NAME: /str2/04c098/x04c098bdr.dgn		PLOT DATE:	18-AUG-2008
PROJECT LEADER:	EVANS-MONGEON	DRAWN BY:	HUSK
DESIGNED BY:	SCRIBNER	CHECKED BY:	SCRIBNER
x04c098rxs6.1		SHEET 57	OF 66