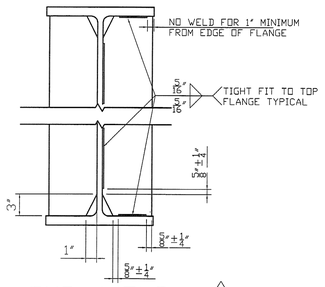

TYP. WELD TERMINATION DETAIL

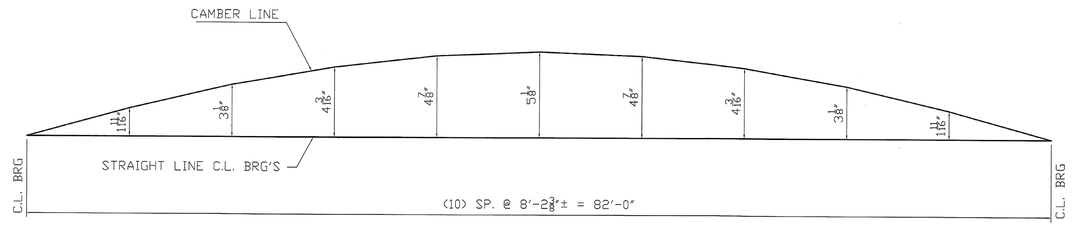

CAMBER DIAGRAM FOR BEAM 6

SHIPPER		BILL OF MATERIAL					
NO.	MARK	NO.	MARK	SIZE	LENGTH	REMARKS	WEIGHT
1	6A			W36X135	83'-6 11/16	CVN/BEVEL	--
		7	pax1	PL 1/2x5	2'-9 7/8		--
		1	phx1	PL 1/4x2 13/16	0'-8 5/16		--

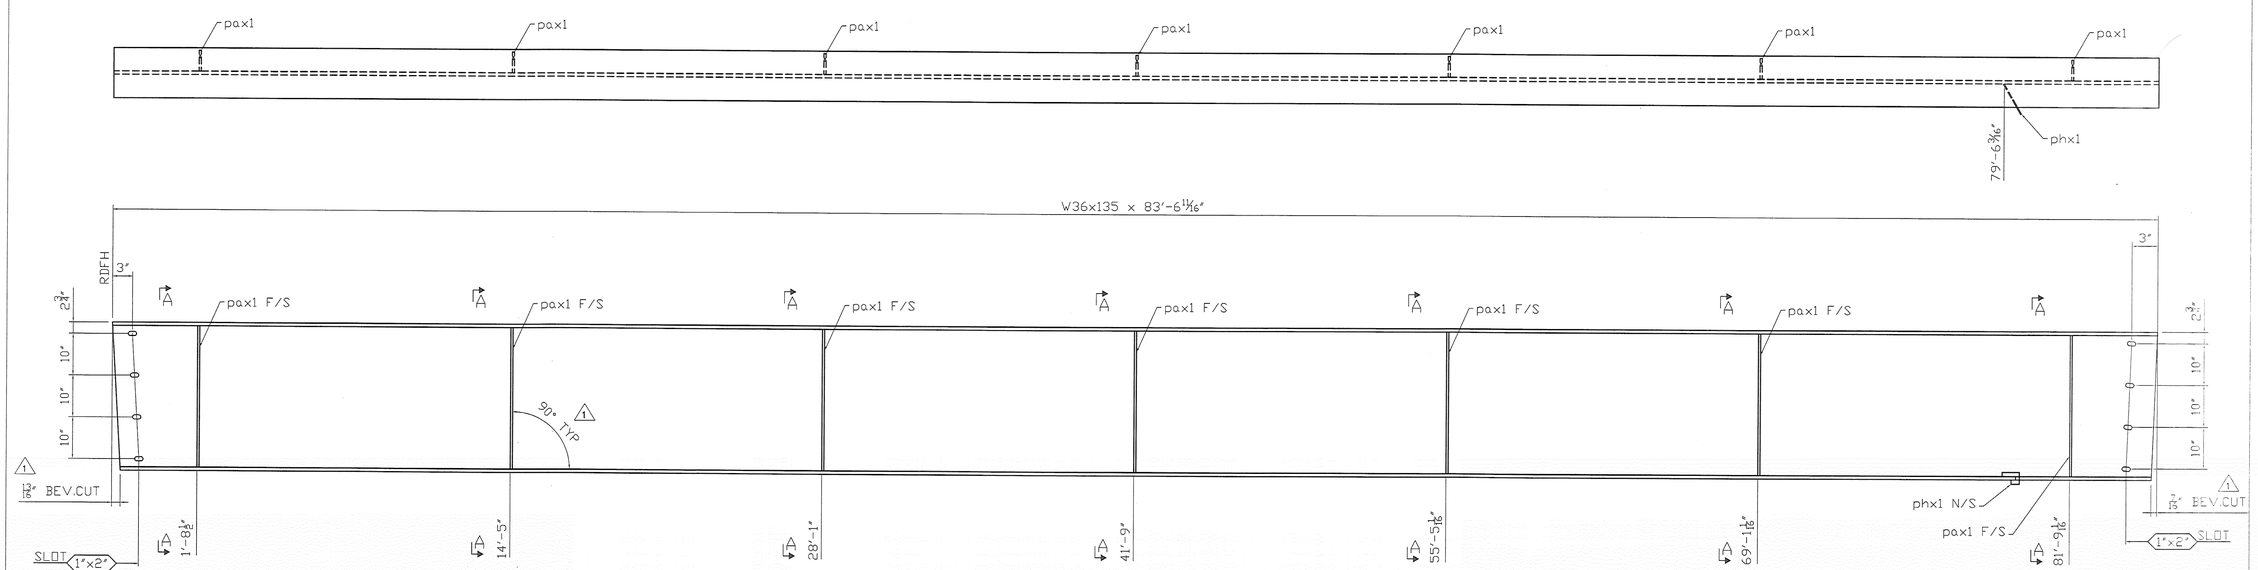

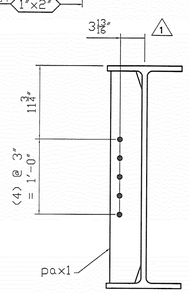

SECTION A-A

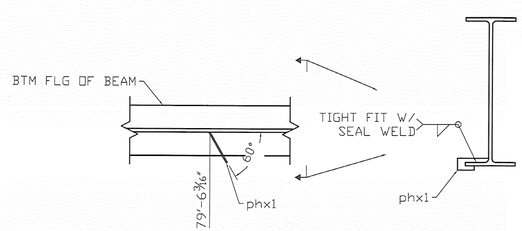

PLAN DRIP PLATE

NOTE:
1. FOR GENERAL NOTES SEE GN1

SHOP NOTES

HOLES 15/16"Ø (U.N.)

BOLTS NONE

PAINT SEE GN DWG

WELDS TO BE MADE USING ER80-NIL ELECTRODES

MATERIAL M270 Gr.50

REV.NO	DATE	REVISION
3		
2		
1	1/9/09	APPROVER COMMENTS

BEAM DETAIL B6

VT.102 (MAJOR COLLETOR) BRIDGE #16 CANAAN, VT
PROJECT NUMBER ER ST 0271 (16)

FOSTER•PRECISE
3 FARM LANE GEORGETOWN, MA 01833
978-352-2591 FAX 978-352-2182

OWNER: STATE OF VERMONT AGENCY OF TRANSPORTATION
CONTRACTOR: WINTERSET INC.

DRAWN BY	CHECKED BY				JOB NO.	SHEET NO.
KC 11/23/08	WL 11/30/08				3476	6