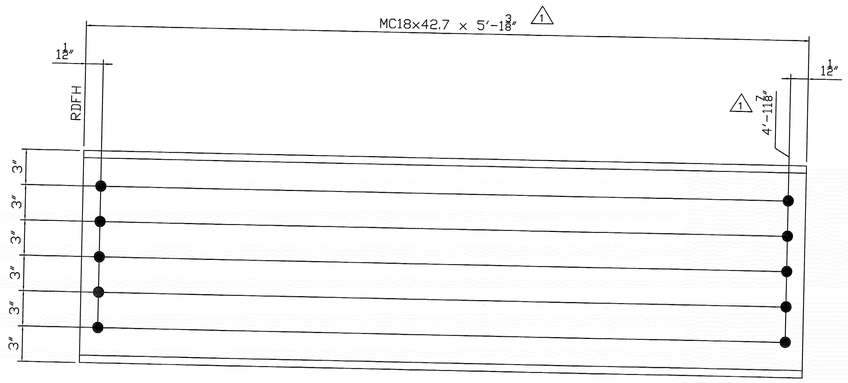

35 REQ'D ~ DIAPHRAGMS ~ 7A

SHIPPER		BILL OF MATERIAL						
NO.	MARK	NO.	MARK	SIZE	LENGTH	REMARKS		WEIGHT
1 35	7A			MC18x42.7	5'-1 3/8"			--
2 12	7P5			PL.1/4 x12	2'-7"			--

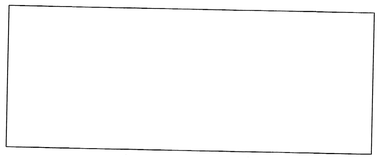

2 12 REQ'D ~ BLOCK OUT PLS. ~ 7P5

Approved for payment
9/28/2009 mem

NOTE:
1. FOR GENERAL NOTES SEE GN1

SHOP NOTES
HOLES 15/16"ø (U.N.)
BOLTS NONE
PAINT SEE GN DWG
WELDS TO BE MADE USING ER80-NIL ELECTRODES
MATERIAL M270 GR50

REV.NO	DATE	REVISION
3		
2	9/28/09	ADDED BLOCK OUT STEEL
1	1/9/09	APPROVER COMMENTS

DIAPHRAM DETAIL

VT.102 (MAJOR COLLETOR) BRIDGE #16 CANAAN, VT
PROJECT NUMBER ER ST 0271 (16)

FOSTER • PRECISE
3 FARM LANE GEORGETOWN, MA 01833
978-352-2591 FAX 978-352-2182

OWNER: STATE OF VERMONT AGENCY OF TRANSPORTATION
CONTRACTOR: WINTEREST INC.

DRAWN BY	CHECKED BY				JOB NO.	SHEET NO.
KC 11/23/08	WL 11/30/08				3476	7