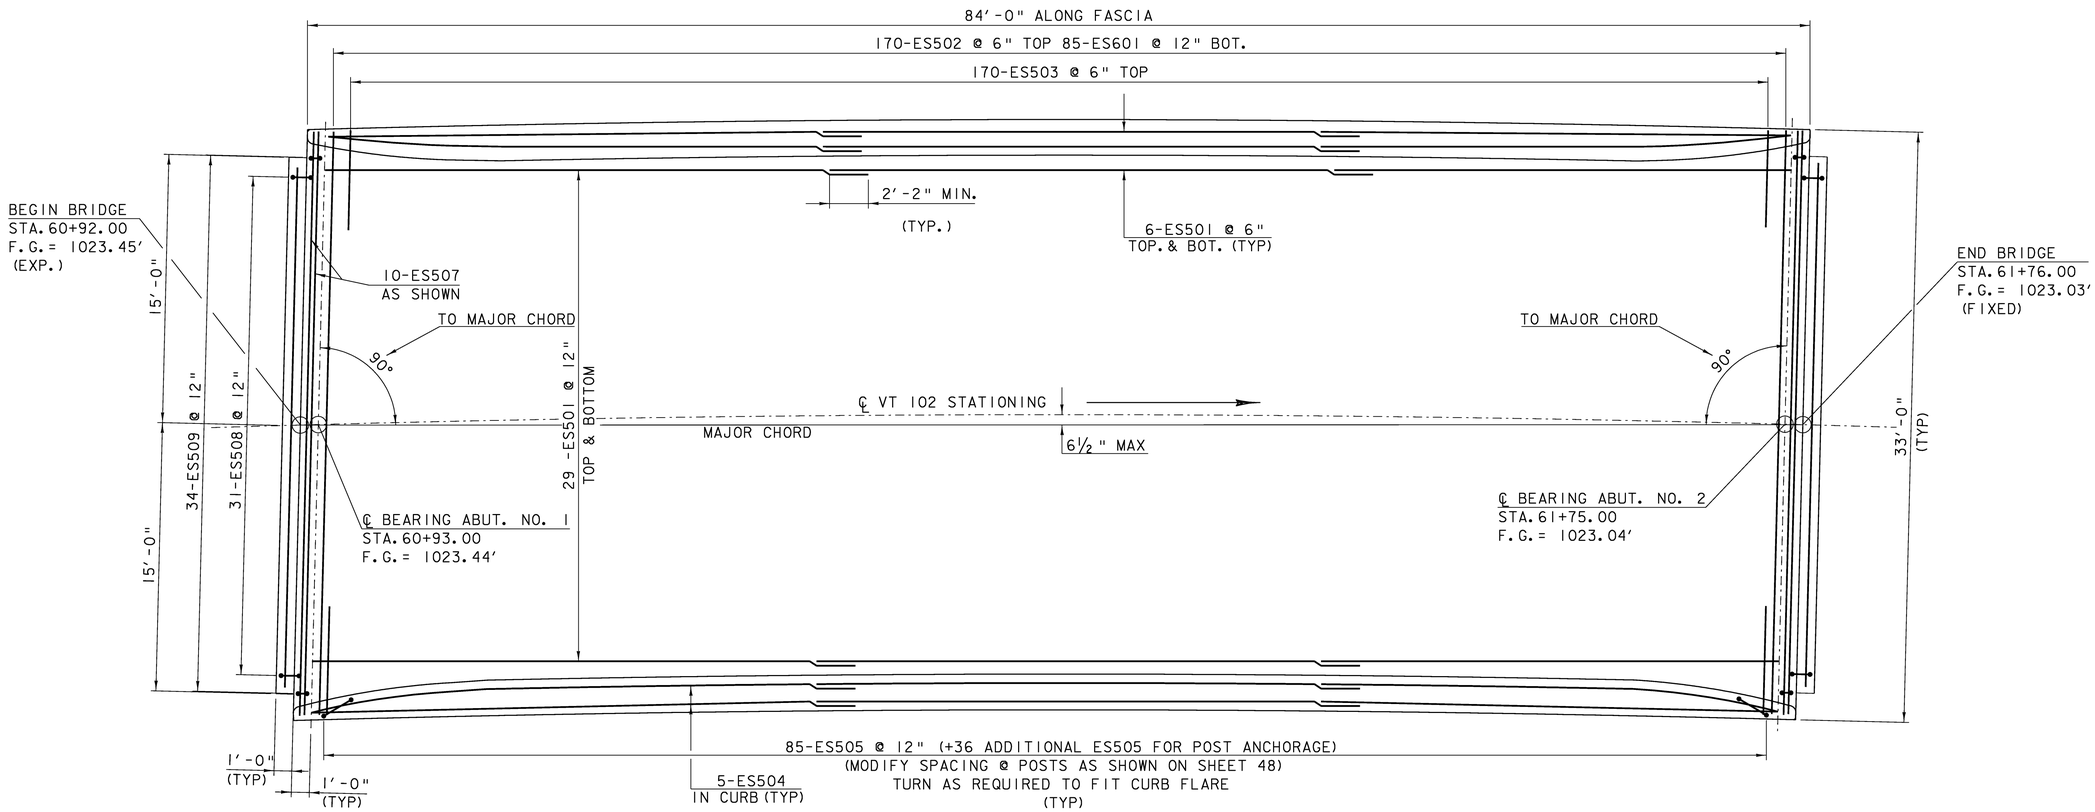


## DECK REINFORCING PLAN

SCALE 1/4" = 1'-0

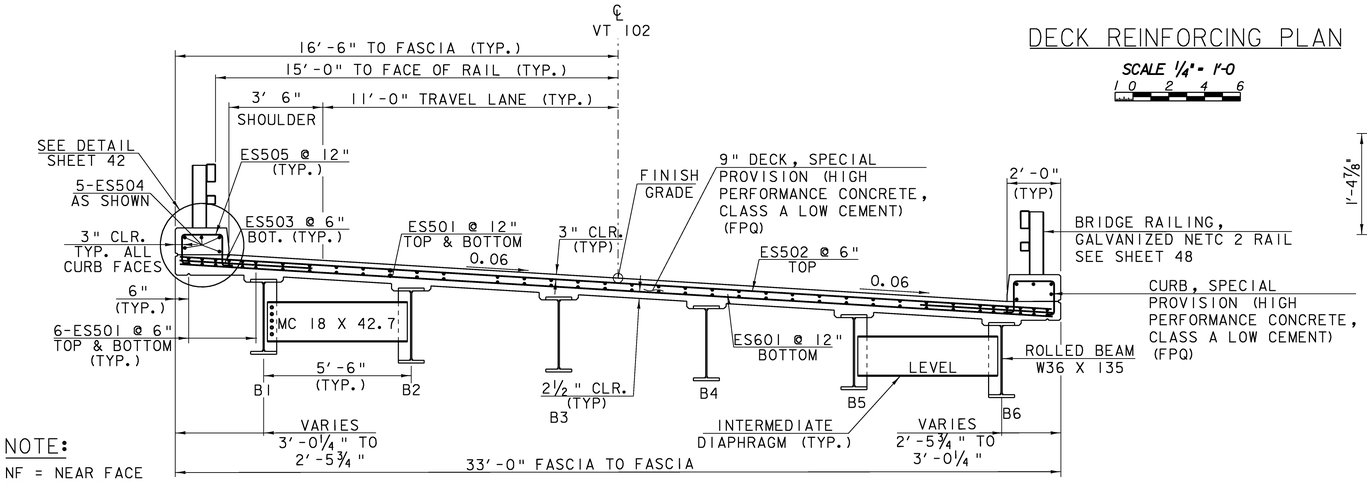


## BRIDGE TYPICAL

SCALE 3/8" = 1'-0

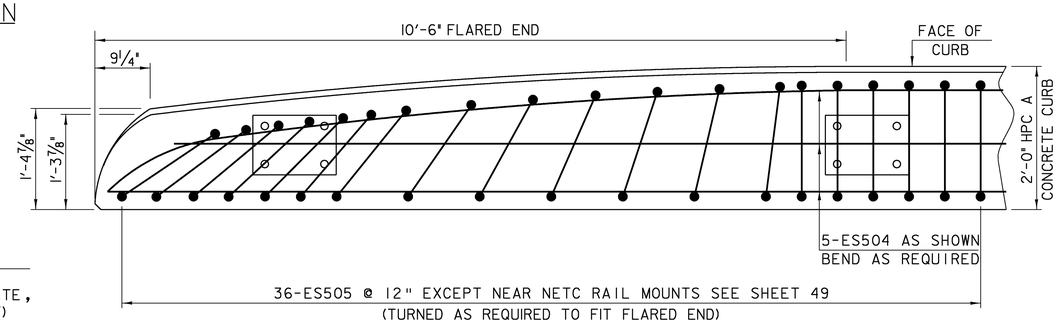


## PLAN VIEW CURB END

NTS

**NOTE:**

NF = NEAR FACE
FF = FAR FACE
EF = EACH FACE
▲ = CUT TO FIT IN FIELD
3" CLEAR, UNLESS OTHERWISE SPECIFIED ON THE PLANS.
2'-2" BAR LAP UNLESS OTHERWISE SPECIFIED ON THE PLANS.

## DECK REINFORCING PLAN

| | |
|---|---|
| PROJECT NAME: CANAAN | |
| PROJECT NUMBER: ER ST 0271(16) | |
| FILE NAME: 04c098/struc./s04c098sup | PLOT DATE: 18-AUG-2008 |
| PROJECT LEADER: M. EVANS-MONGEON | DRAWN BY: L. DUQUETTE |
| DESIGNED BY: S.SCRIBNER | CHECKED BY: S. SCRIBNER |
| | SHEET 35 OF 66 |