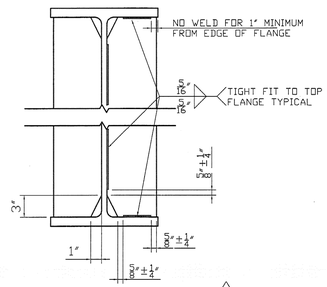

TYP. WELD TERMINATION DETAIL 1

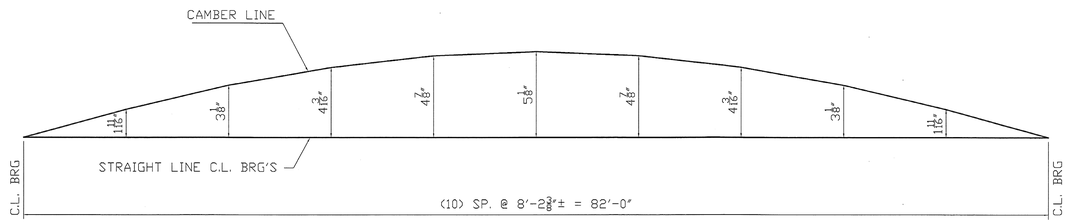

CAMBER DIAGRAM FOR BEAM 2

SHIPPER		BILL OF MATERIAL					
NO.	MARK	NO.	MARK	SIZE	LENGTH	REMARKS	WEIGHT
1	2A			W36X135	83'-6 11/16"	CVN/BEVEL	--
		7	pax1	PL 1/2x5	2'-9 7/8"		--
		7	pcx1	PL 1/2x5	2'-9 7/8"		--

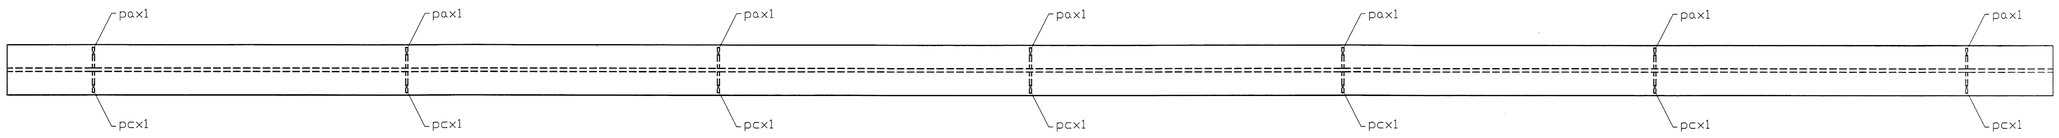

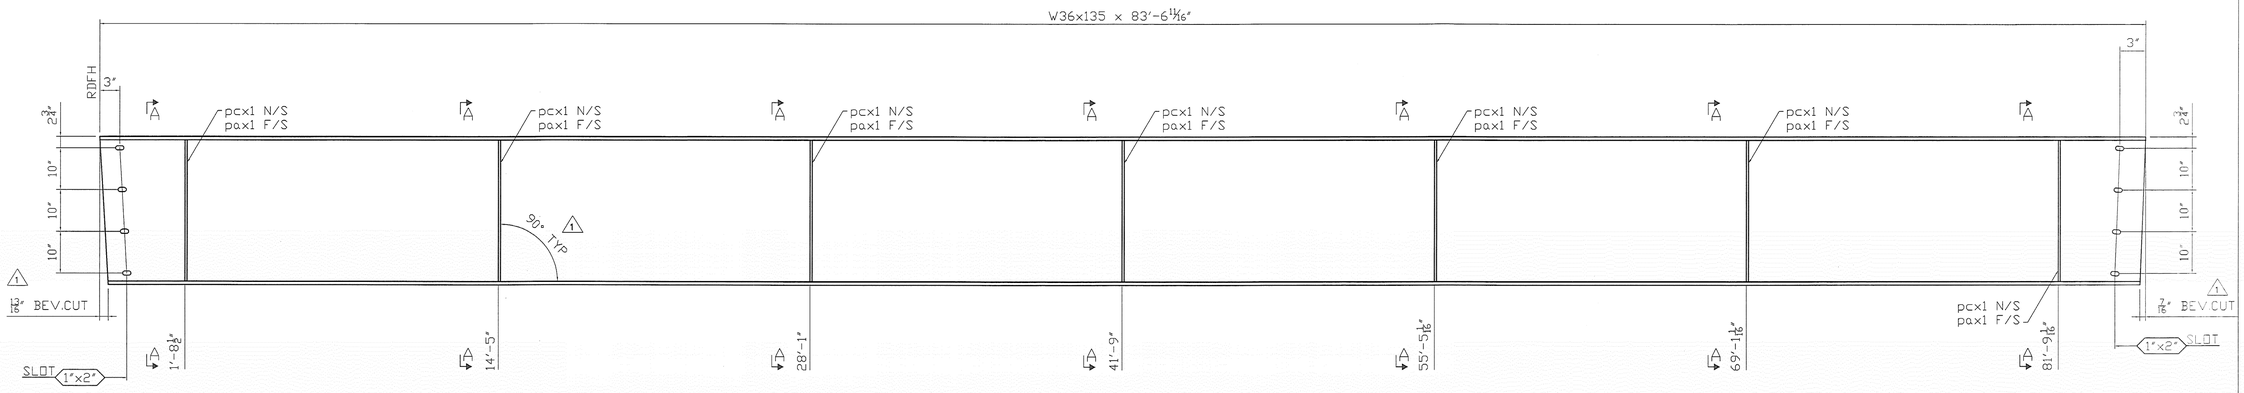

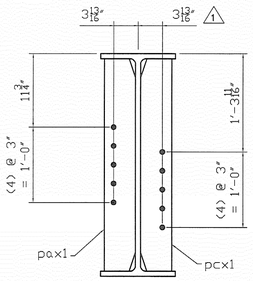

SECTION A-A

RECEIVED
OK'D BY SSS OK'D BY MZM
JAN 2009
APPROVED ✓
BY Date 1/26/09

NOTE:
1. FOR GENERAL NOTES SEE GN1

REV.NO	DATE	REVISION
3		
2		
1	1/9/09	APPROVER COMMENTS

BEAM DETAIL B2

VT.102 (MAJOR COLLETOR) BRIDGE #16 CANAAN, VT
PROJECT NUMBER ER ST 0271 (16)

SHOP NOTES
HOLES 15/16"ø (U.N.)
BOLTS NONE
PAINT SEE GN DWG
WELDS TO BE MADE USING ERBO-NIL ELECTRODES
MATERIAL M270 Gr.50

FOSTER•PRECISE
3 FARM LANE GEORGETOWN, MA 01833
978-352-2591 FAX 978-352-2182
OWNER: STATE OF VERMONT AGENCY OF TRANSPORTATION
CONTRACTOR: WINTERSET INC.

DRAWN BY	CHECKED BY				JOB NO.	SHEET NO.
KC 11/23/08	WL 11/30/08				3476	2