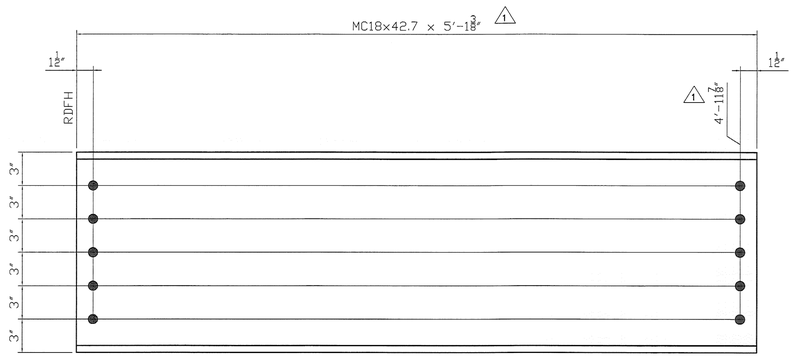

35 REQ'D ~ DIAPHRAGMS ~ 7A

SHIPPER		BILL OF MATERIAL						
NO.	MARK	NO.	MARK	SIZE	LENGTH	REMARKS		WEIGHT
35	7A			MC18x42.7	5'-1 3/8			--

1

DK'D BY SSS DK'D BY mgm

✓

1/26/09

NOTE:
1. FOR GENERAL NOTES SEE GN1

REV.NO	DATE	REVISION
3		
2		
1	1/9/09	APPROVER COMMENTS

DIAPHRAM DETAIL

VT.102 (MAJOR COLLETOR) BRIDGE #16 CANAAN, VT
PROJECT NUMBER ER ST 0271 (16)

SHOP NOTES
HOLES 15/16"ø (U.N.)
BOLTS NONE
PAINT SEE GN DWG
WELDS TO BE MADE USING ER80-NIL ELECTRODES
MATERIAL M270 GR50

FOSTER • PRECISE
3 FARM LANE GEORGETOWN, MA 01833
978-352-2591 FAX 978-352-2182
OWNER: STATE OF VERMONT AGENCY OF TRANSPORTATION
CONTRACTOR: WINTEREST INC.

DRAWN BY	CHECKED BY				JOB NO.	SHEET NO.
KC 11/23/08	WL 11/30/08				3476	7