BANKING DIAGRAM

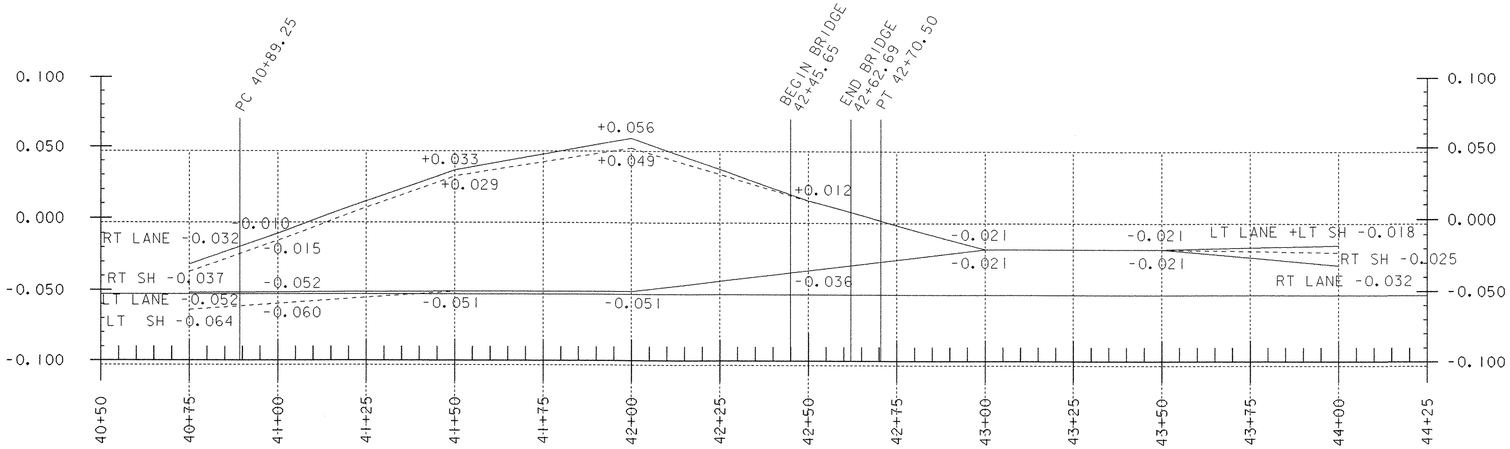

SCALE 1" = 20'-0
20 0 20

PROFILE

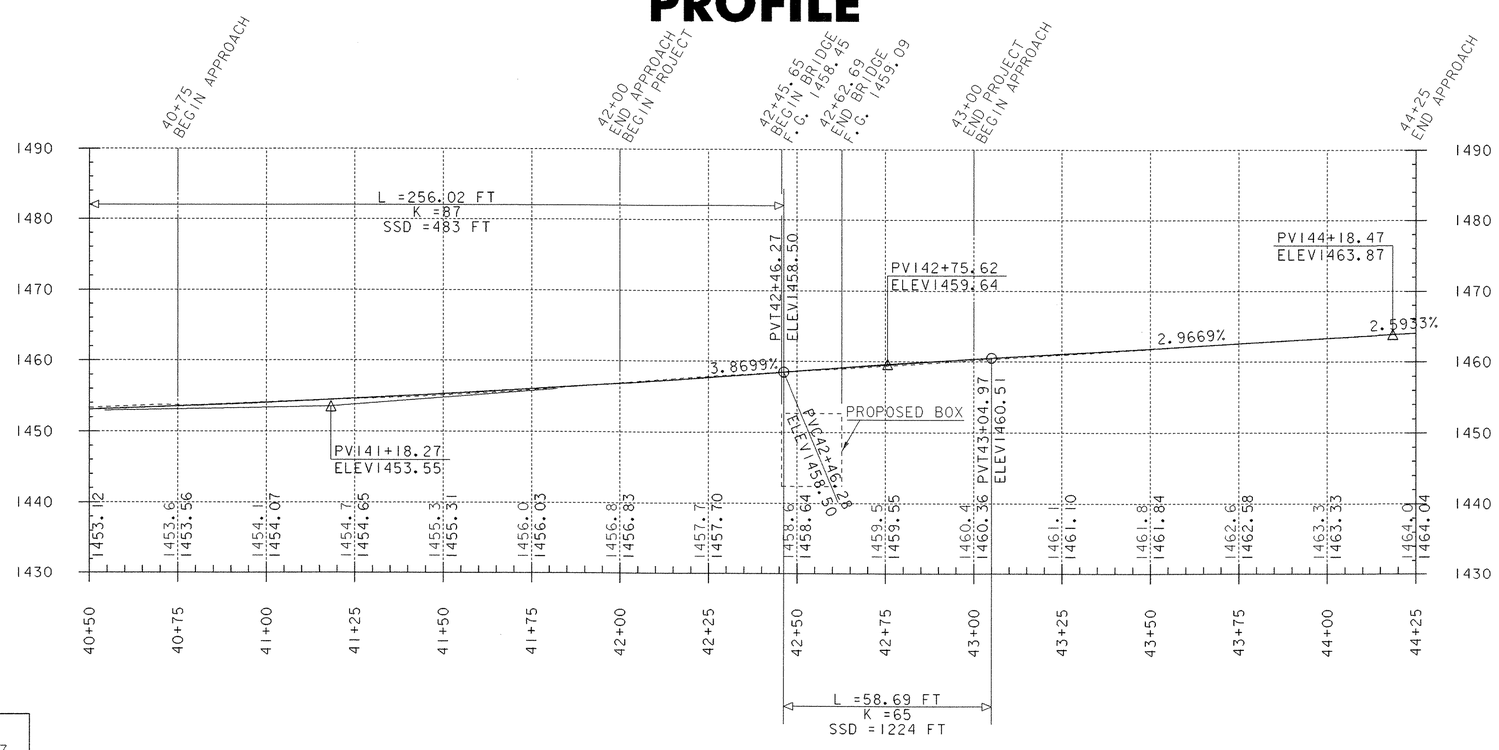

SCALE 1" = 40'-0
10 0 10

SCALE 1" = 20'-0
20 0 20

BANKING DIAGRAM AND PROFILE SHEET

DATUM
VERTICAL NAVD 27
HORIZONTAL ASSUMED

PROJECT NAME: BUELS GORE	
PROJECT NUMBER: STP ST CULV(I)	
FILE NAME: 04c138/structures/s04c138xs.dgn	PLOT DATE: 05-APR-2006
PROJECT LEADER: M EVANS-MONGEON	DRAWN BY: W FARLEY
DESIGNED BY: W FARLEY	CHECKED BY: M EVANS-MONGEON
IPARM: s04c138profile.i	SHEET 11 OF 30