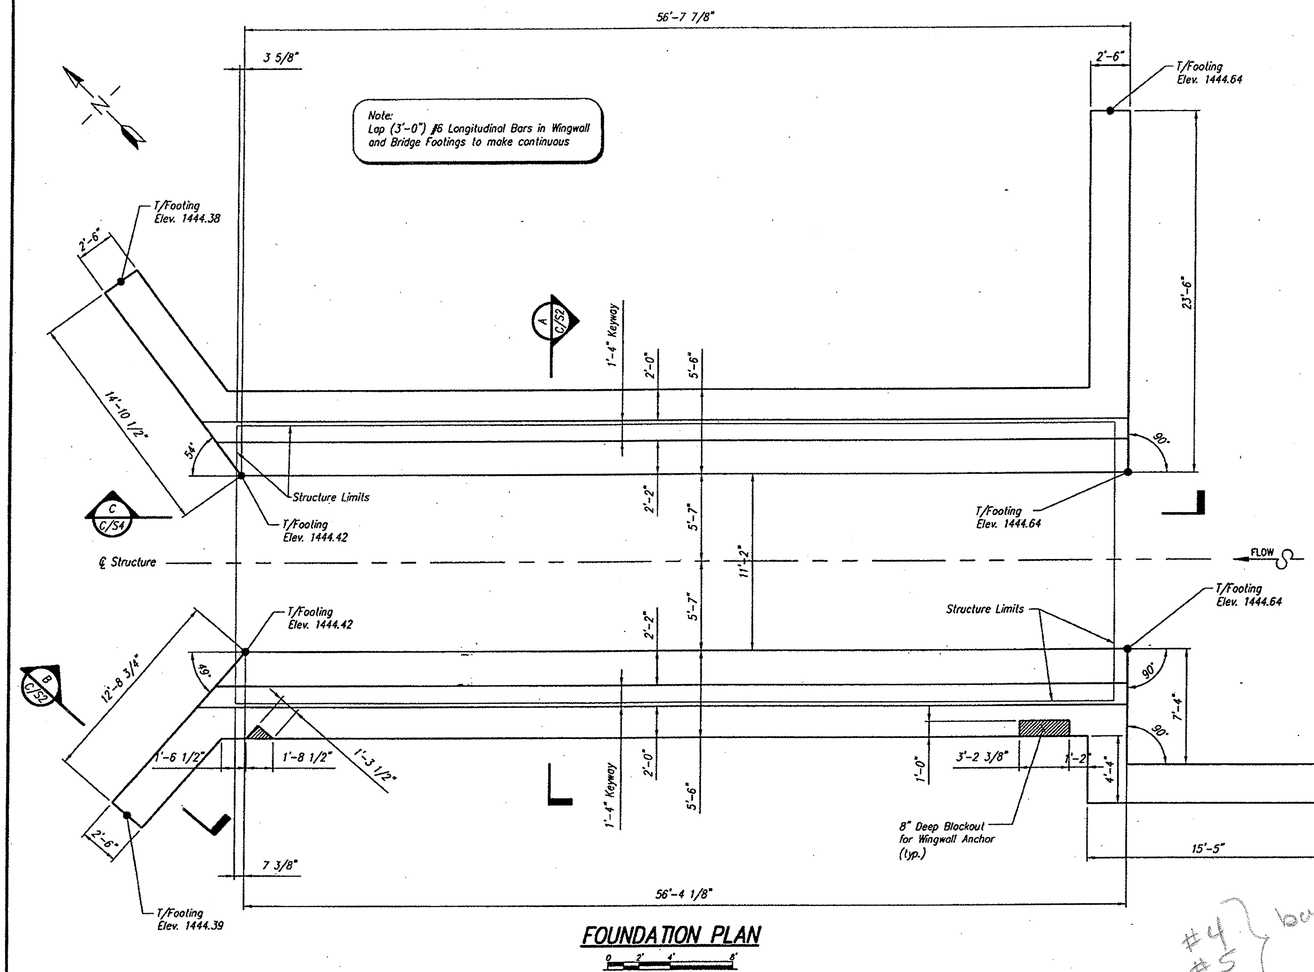

FOUNDATION PLAN

0 2' 4' 8'

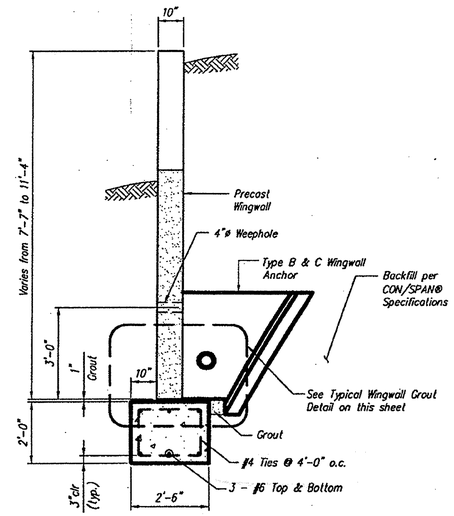

SECTION B C/S1

0 1' 2' 4'

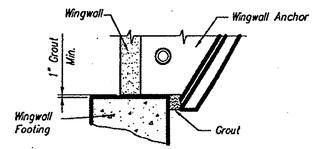

Notes:
- Minimum 1" Grout under wingwall leg & anchor stem.
- Area between wingwall footing and wingwall anchor shall be grouted solid before backfill.

TYPICAL WINGWALL GROUT DETAIL

not to scale

#4 }
#5 } bars
#6 }

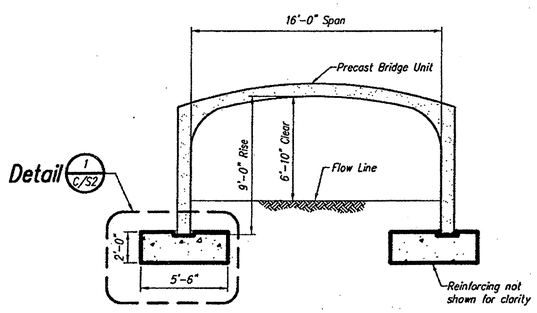

SECTION A C/S1

0 2' 4' 8'

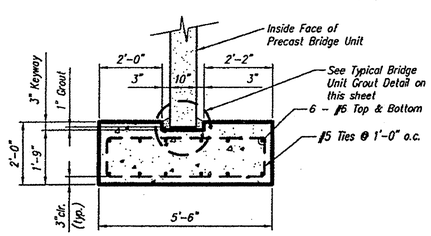

DETAIL 1 C/S2

0 1' 2' 4'

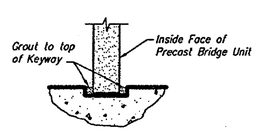

Note:
Fill entire keyway including nominal 1" void between bottom of keyway and bottom of precast bridge unit leg with grout.

TYPICAL BRIDGE UNIT GROUT DETAIL

not to scale

APPROVAL ONLY:
NOT FOR CONSTRUCTION

William D Fahrwood

7-17-06

NOTICE
© 2006, The design and information shown on this drawing is provided as a service to the project owner, engineer and contractor by CON/SPAN® Bridge Systems Ltd. No part of this drawing may be used, reproduced, or modified in any manner without the prior written authorization of CON/SPAN® Bridge Systems Ltd. Any such use, reproduction, or modification without such authorization is strictly prohibited. By using this drawing, you agree to indemnify CON/SPAN® Bridge Systems Ltd. from and against any and all claims, liability, and expenses, including, but not limited to, reasonable attorney's fees, arising from such use, reproduction or modification.
If discrepancies between the supplied information and actual field conditions are encountered as site work progresses, these discrepancies must be reported to CON/SPAN® Bridge Systems Ltd., immediately for re-evaluation of the design. CON/SPAN® Bridge Systems Ltd. accepts no liability for designs based on inaccurate information supplied by others.
The CON/SPAN® Bridge System is protected by one or more patents, patents pending and Trademarks.

No.	Date	REVISIONS
1		
2		
3		
4		
5		
6		
7		

Engineer's Seal

CON/SPAN® BRIDGE SYSTEMS
3100 Research Blvd. P.O. Box 20266 Dayton, Ohio 45420-0266
(800) 528-3099 (937) 254-8585 FAX
Offices
Dayton, OH (937) 254-2333 (704) 588-8585 FAX
Charlotte, NC (704) 588-8426 (610) 326-3377 FAX
Somerset, CA (610) 326-3377 (518) 371-3872 FAX
Albany, NY (518) 371-2811

VERMONT

MONTPELIER

BUELS GORE

034

Designed	KJG	C/S Project No. 14688
Drawn	WLC	
Checked	MRW	Sheet No. C/S2
Date	6/22/06	