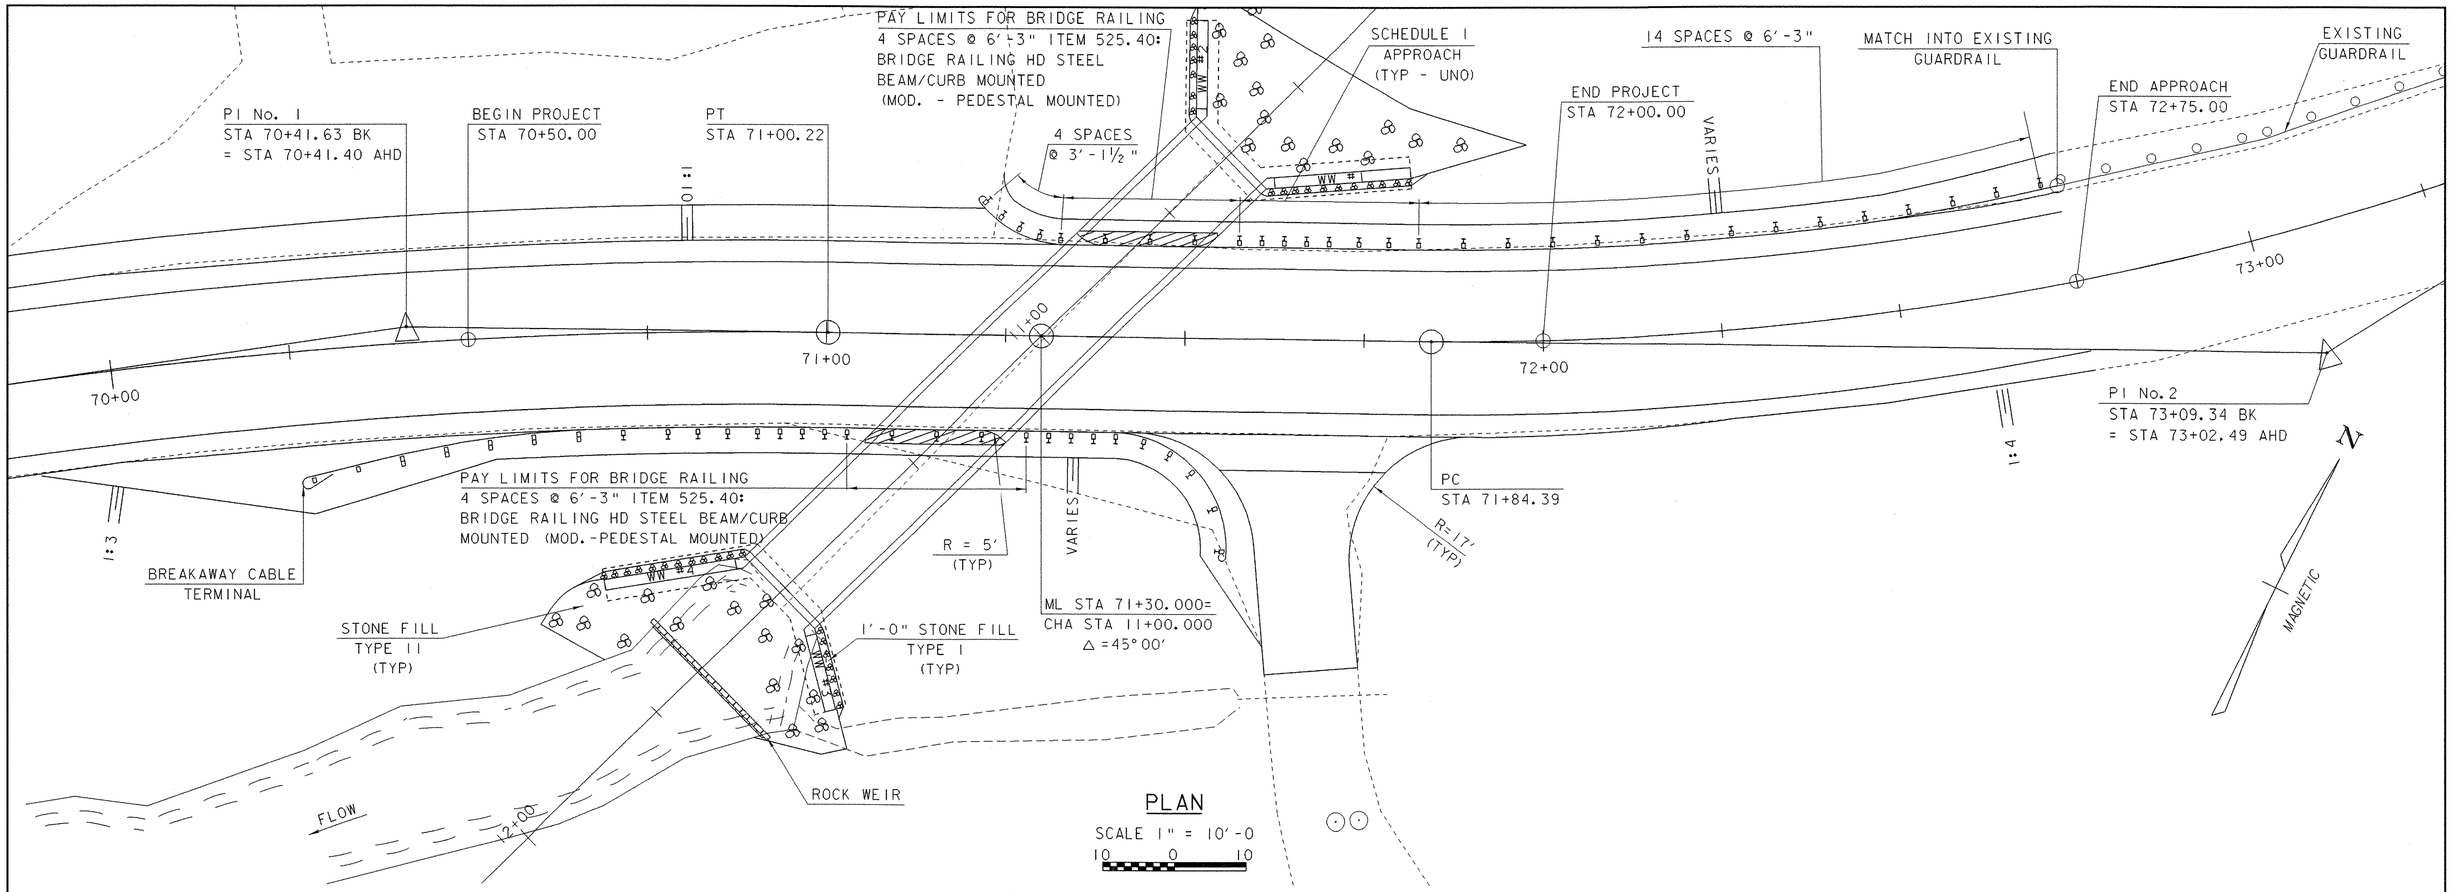

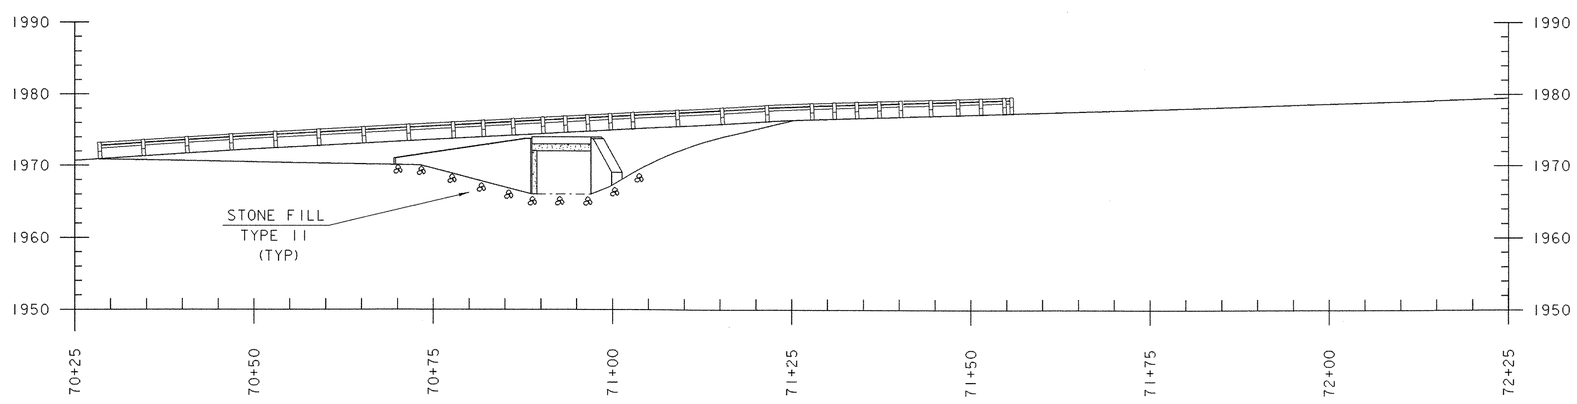

ELEVATION @ DOWNSTREAM FASCIA

SCALE 1" = 10'-0
10 0 10

PROJECT NAME: READSBORO	
PROJECT NUMBER: ST CULV (4)	
FILE NAME: 04c176/Str/s04c176pe.dgn	PLOT DATE: 18-JUL-2006
PROJECT LEADER: C.P.WILLIAMS	DRAWN BY: M.FESSEL
DESIGNED BY: E.L.RUSTAY	CHECKED BY: M.GAGULIC
PLAN AND ELEVATION	SHEET 13 OF 39