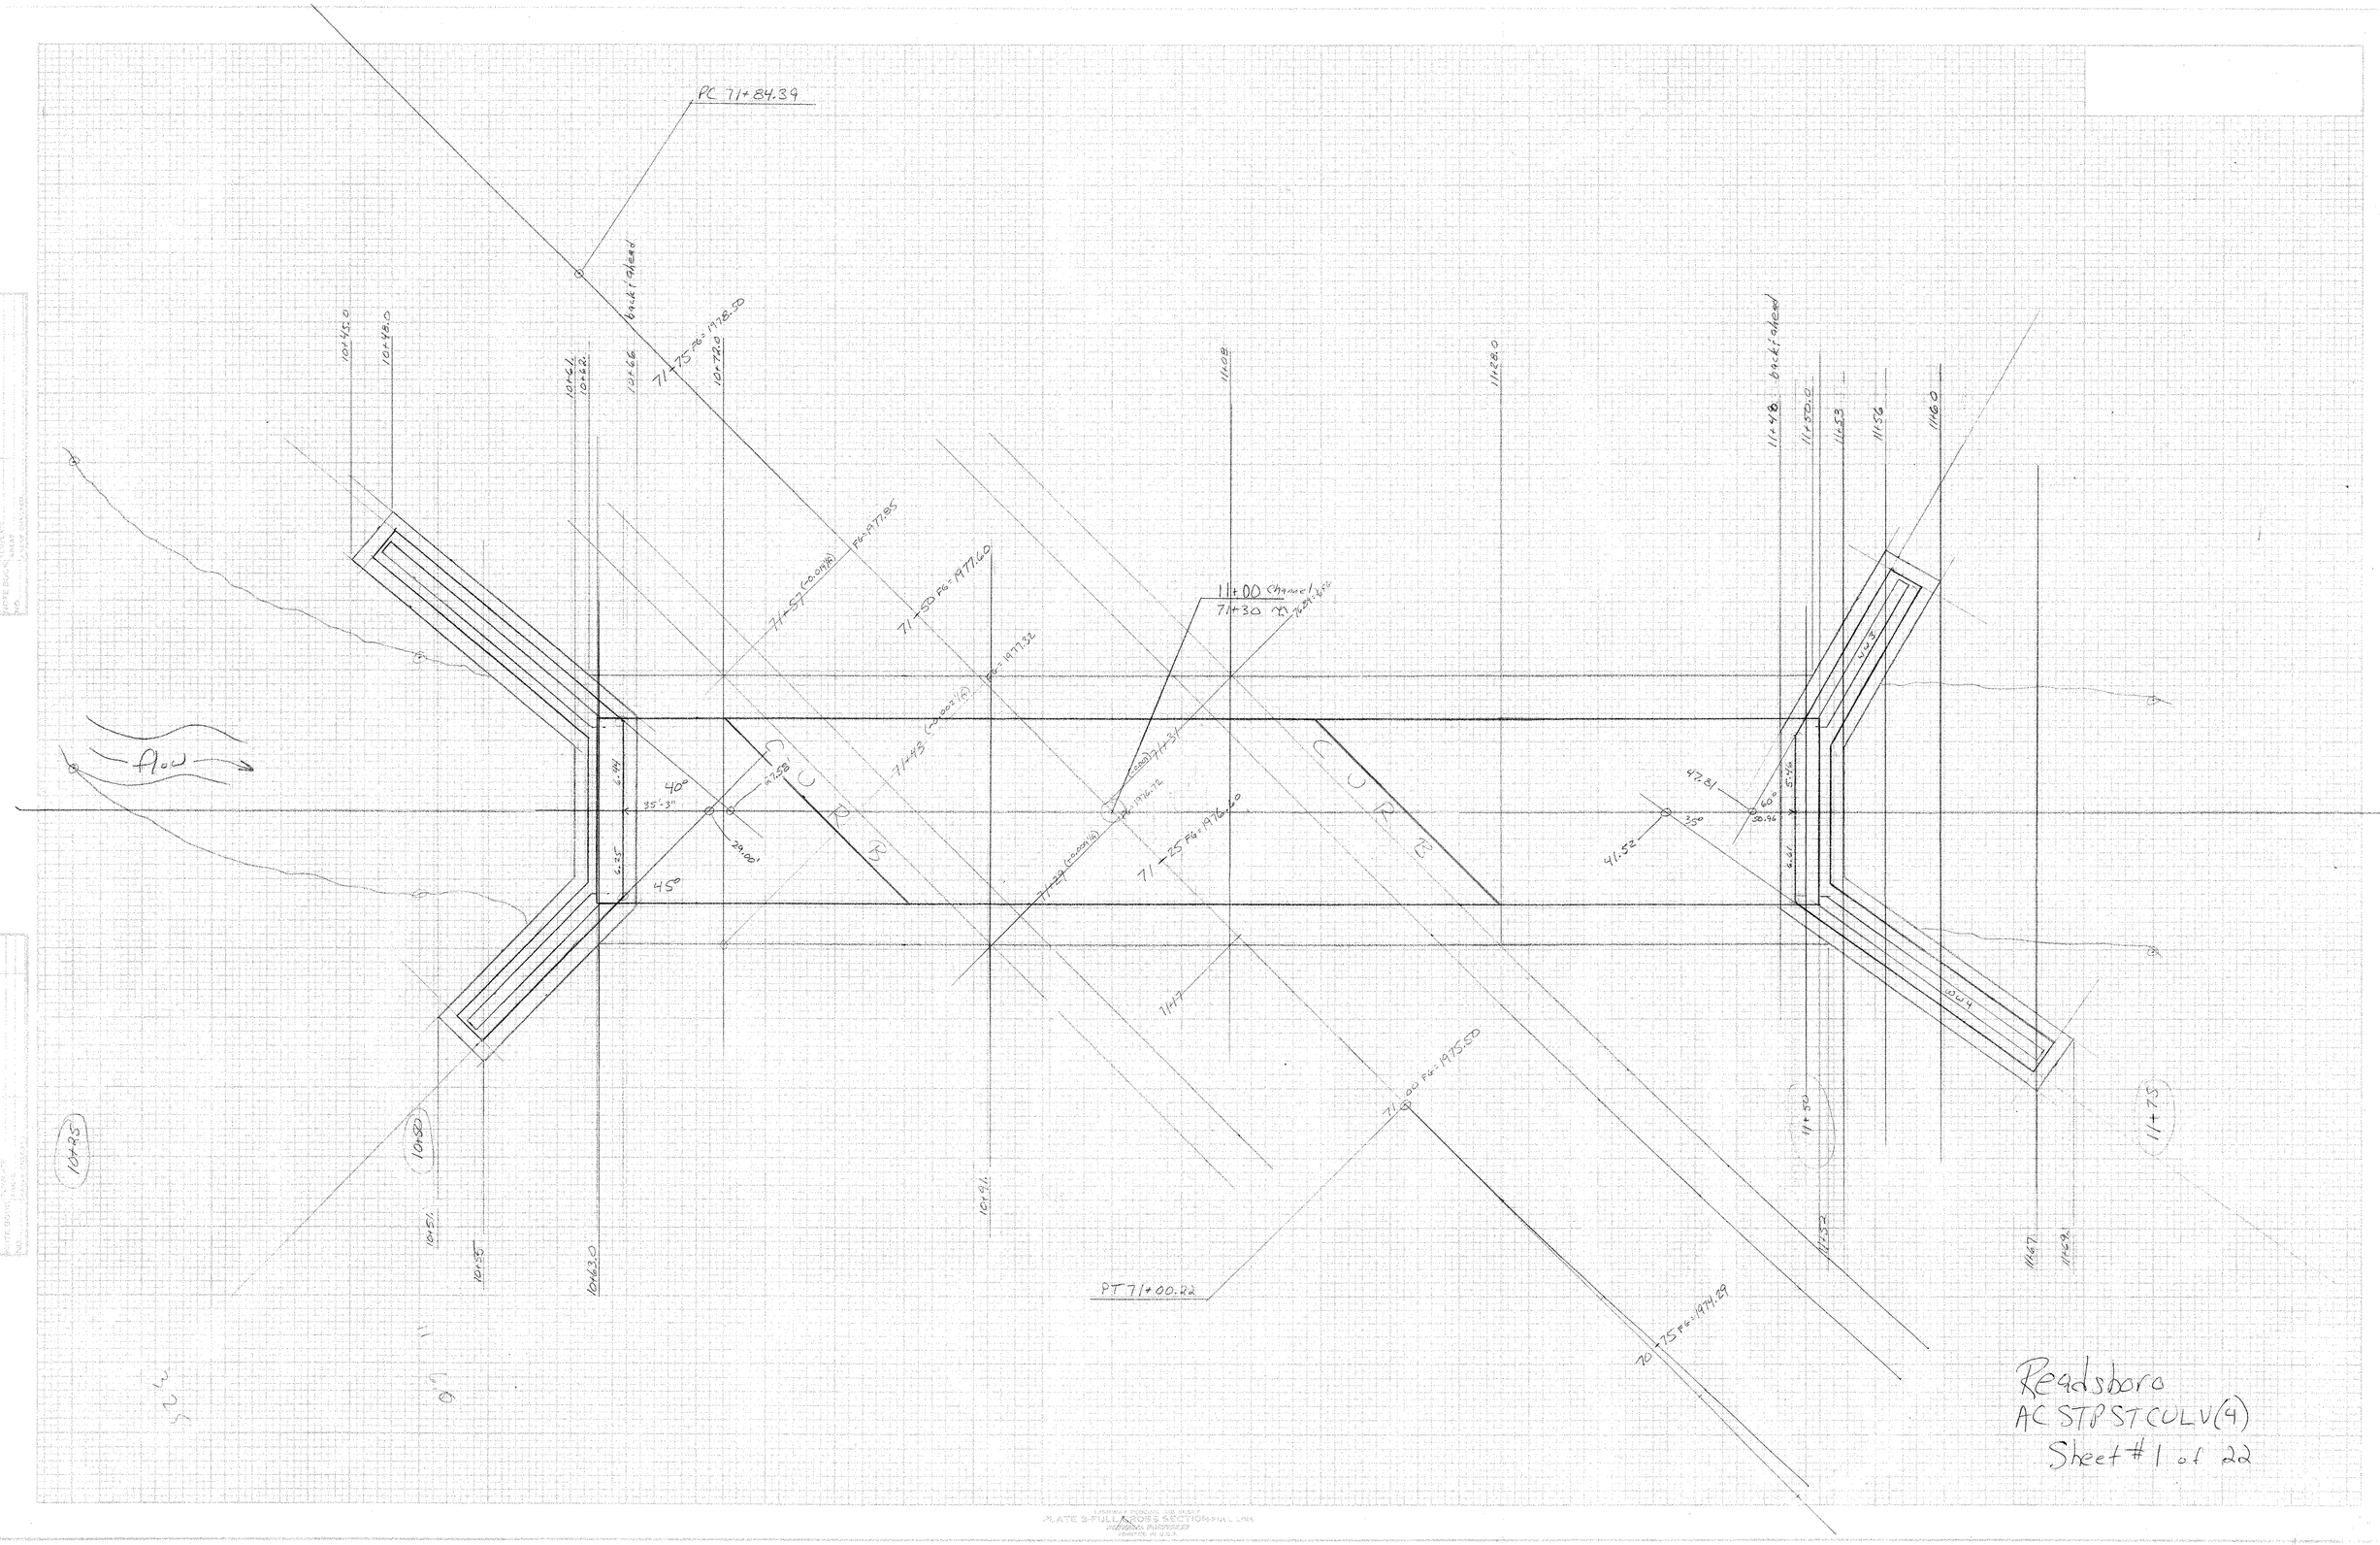
PC 71+84.39
back ahead
71+75 FG=1978.50
71+57 (-0.09%) FG=1977.85
71+50 FG=1977.60
71+43 (-0.02%) FG=1977.32
71+29 (-0.09%)
71+25 FG=1976.60
71+00 FG=1973.50
70+75 FG=1974.49
PT 71+00.22
11+00 Channel
71+30
11+17
flow
40°
35'-3"
45°
60°
35°
47.81
41.52
20.06
17.58
6.94
6.35
57.96
62.61
10+45.0
10+48.0
10+54
10+62
10+66
10+72.0
11.08
11+28.0
11+48
11+50.0
11.53
11.56
11.60
10+25
10+80
10+51
10+55
10+63.0
10+91
11+50
11+75
11.32
11.67
11+82
Readsboro
AC STP ST CULV(4)
Sheet #1 of 22