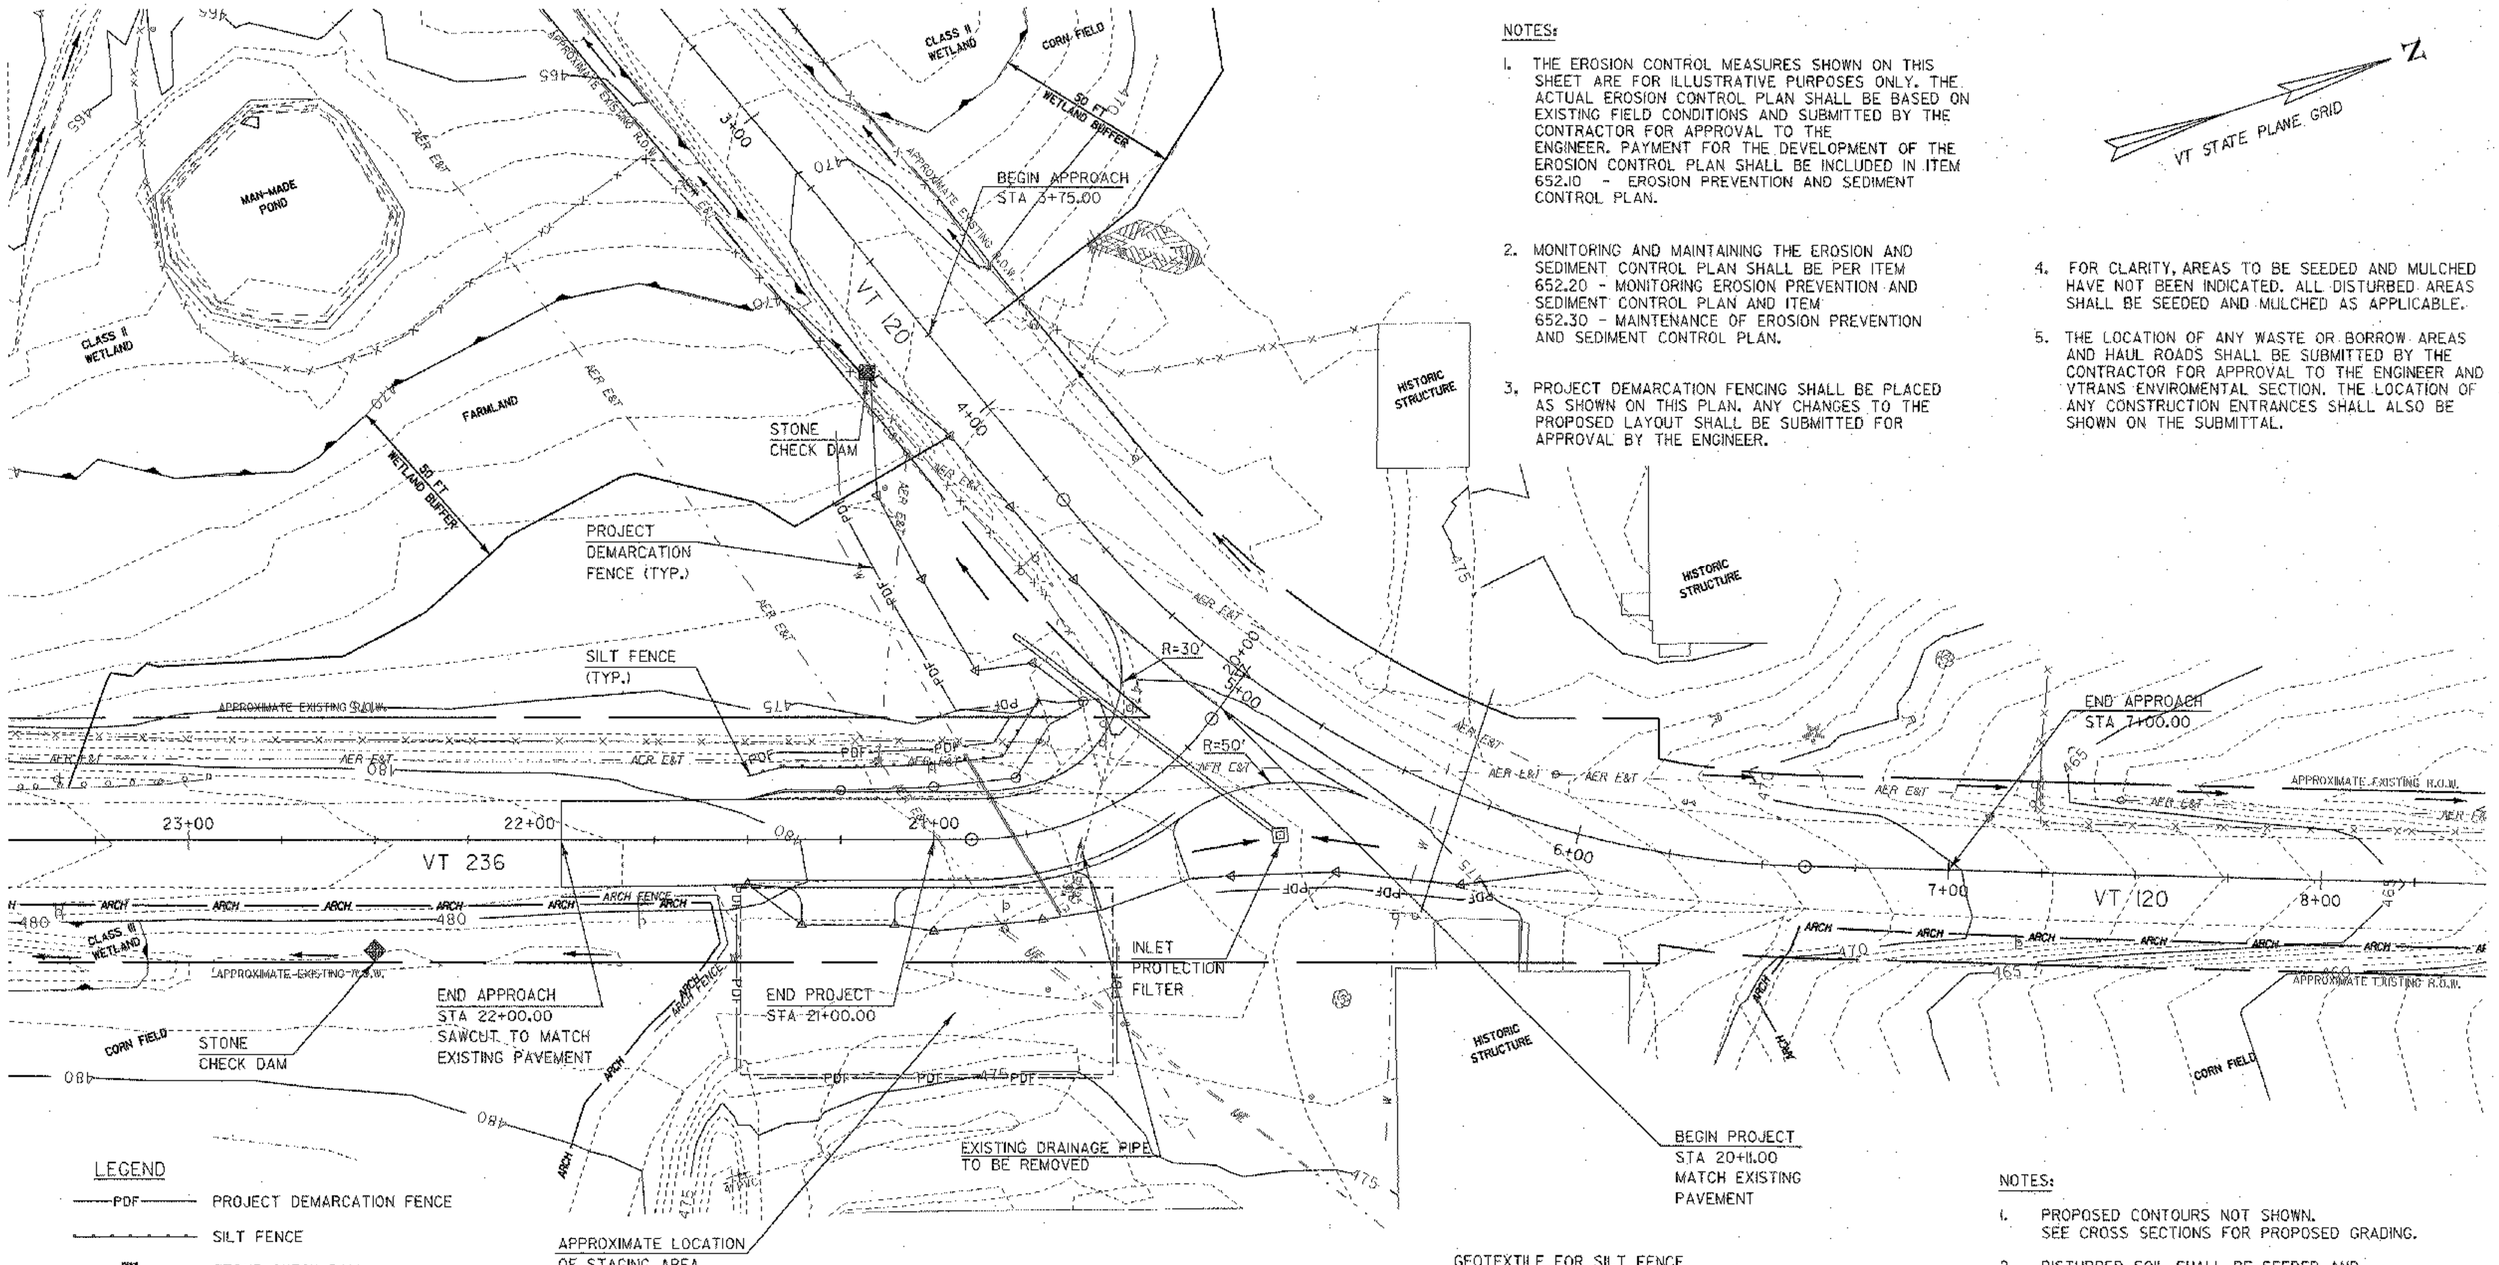

NOTES:

1. THE EROSION CONTROL MEASURES SHOWN ON THIS SHEET ARE FOR ILLUSTRATIVE PURPOSES ONLY. THE ACTUAL EROSION CONTROL PLAN SHALL BE BASED ON EXISTING FIELD CONDITIONS AND SUBMITTED BY THE CONTRACTOR FOR APPROVAL TO THE ENGINEER. PAYMENT FOR THE DEVELOPMENT OF THE EROSION CONTROL PLAN SHALL BE INCLUDED IN ITEM 652.10 - EROSION PREVENTION AND SEDIMENT CONTROL PLAN.

2. MONITORING AND MAINTAINING THE EROSION AND SEDIMENT CONTROL PLAN SHALL BE PER ITEM 652.20 - MONITORING EROSION PREVENTION AND SEDIMENT CONTROL PLAN AND ITEM 652.30 - MAINTENANCE OF EROSION PREVENTION AND SEDIMENT CONTROL PLAN.

3. PROJECT DEMARCATION FENCING SHALL BE PLACED AS SHOWN ON THIS PLAN. ANY CHANGES TO THE PROPOSED LAYOUT SHALL BE SUBMITTED FOR APPROVAL BY THE ENGINEER.

4. FOR CLARITY, AREAS TO BE SEEDED AND MULCHED HAVE NOT BEEN INDICATED. ALL DISTURBED AREAS SHALL BE SEEDED AND MULCHED AS APPLICABLE.

5. THE LOCATION OF ANY WASTE OR BORROW AREAS AND HAUL ROADS SHALL BE SUBMITTED BY THE CONTRACTOR FOR APPROVAL TO THE ENGINEER AND VTRANS ENVIROMENTAL SECTION. THE LOCATION OF ANY CONSTRUCTION ENTRANCES SHALL ALSO BE SHOWN ON THE SUBMITTAL.

N

VT STATE PLANE GRID

LEGEND

- PDF — PROJECT DEMARCATION FENCE
- SILT FENCE
- STONE CHECK DAM
- DRAINAGE PATTERNS
- WETLANDS
- ARCH — ARCHAEOLOGICAL AREAS
- ARCH FENCE — ARCHAEOLOGICAL FENCE

DATUM
VERTICAL: NAVD 88
HORIZONTAL: NAD83

SNOW FENCE (MOD-ARCH)

STA 21+~~55.2,~~ 60.0 LT TO STA 22+00.0, LT

GEOTEXTILE FOR SILT FENCE

4+55 (VT 120)
STA ~~20+39.2,~~ TO STA 21+50.0, RT
STA 20+52 TO STA 21+05.0 LT

SNOW FENCE (MOD-PDF)

STA 3+75.0, RT TO STA 21+50.0, RT
5+50 STA ~~5+23.7,~~ RT TO STA ~~5+83.5,~~ RT+85
STA 20+~~62.1,~~ 52 LT TO STA 21+~~53.0,~~ +05 LT

STONE FILL, TYPE I (MOD-CHECK DAMS)

50.0
STA 3+~~75.0,~~ RT
STA 22+50.0, LT

NOTES:

1. PROPOSED CONTOURS NOT SHOWN. SEE CROSS SECTIONS FOR PROPOSED GRADING.

2. DISTURBED SOIL SHALL BE SEEDED AND MULCHED TO ESTABLISH PERMANENT STABILIZATION.

0 20 40
SCALE IN FEET

PROJECT NAME: FRANKLIN
PROJECT NUMBER: HES 0313(4)

FILE NAME: ECO3.DGN
PROJECT LEADER: GAMBLE
DESIGNED BY: BRC
EPSC PLAN

PLOT DATE: 02-NOV-2006
DRAWN BY: MJF
CHECKED BY: DMB
SHEET 16 OF 26