STATE OF VERMONT
AGENCY OF TRANSPORTATION

TRAFFIC SIGN SUMMARY SHEET 20

MILEMARKER, STATION, OR SIGN NUMBER	SIGN LEGEND	EA	SIGN DIMENSIONS WIDTH (in)	SIGN DIMENSIONS HEIGHT (in)	NEW & SALVAGED SIGNS "A"	"B"	SALV SIGN	SALV TIS	EXIST POST RETAIN	EXIST POST SALVAGE	NO. OF POSTS	NEW SIGN POSTS: FLANGED CHANNEL lb/ft 1.12	2.0	3.0	SQUARE STEEL (in) 1.75 lb/ft 1.88	2.0 lb/ft 2.42	2.5 lb/ft 3.35	ANCHOR	SLEEVE	TUBULAR ALUMINUM Ø (in) 3.0 lb/ft 1.3	4.0 lb/ft 1.7	4.0 MOD lb/ft 1.7	FOUNDATION	TUBULAR STEEL Ø (in) 3.0 lb/ft 7.6	3.5 lb/ft 9.0	4.0 lb/ft 10.8	5.0 lb/ft 14.6	W-SHAPE STEEL FTG. SIZE 24"	FTG. SIZE 30"	WEIGHT	POST SIZE	SIGN FRAME REQUIRED	REMARKS SHS = FHWA STANDARD HIGHWAY SIGNS BOOK	SIGN DETAIL: DETAIL IN SHS	DETAIL ON DWG. NUMBER	STD. SHEET NUMBER
RUTLAND CITY RIPLEY ROAD: R 1+59.0, RT		1	48	9	6.00				1																								SIGN ID CODE R15-1 PROPOSED SIGN TO BE MOUNTED ON EXISTING SIGNAL MAST	X		
		1	27	18	2.25																												SIGN ID CODE R15-2P PROPOSED SIGN TO BE MOUNTED ON EXISTING SIGNAL MAST	X		
	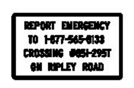	1	30	18	3.75 3.75				1							10.00		2.25															SIGN ID CODE I-13A PROPOSED SIGN ~~TO BE MOUNTED ON EXISTING SIGNAL MAST~~		122	
	REPLACED WITH CORRECTED PHONE NUMBER																																			
R 2+10.0, LT		1	30	18	3.75 3.75				1							9.00		2.25															SIGN ID CODE I-13A PROPOSED SIGN ~~TO BE MOUNTED ON EXISTING RAILROAD SIGNAL CABINET~~		122	
	REPLACED WITH CORRECTED PHONE NUMBER																																			
R 2+19.0, LT		1	48	9	6.00				1																								SIGN ID CODE R15-1 PROPOSED SIGN TO BE MOUNTED ON EXISTING SIGNAL MAST	X		
		1	27	18	2.25																												SIGN ID CODE R15-2P PROPOSED SIGN TO BE MOUNTED ON EXISTING SIGNAL MAST	X		
		1	30	18	3.75 3.75				1							10.00		4															SIGN ID CODE I-13A PROPOSED SIGN ~~TO BE MOUNTED ON EXISTING SIGNAL MAST~~		122	
	REPLACED WITH CORRECTED PHONE NUMBER																																			
R 2+45.0, LT		1	24	30	5.00						1					X 9.25		X 4															SIGN ID CODE R8-8	X		
RUTLAND CITY WEST STREET: W 0+52.0, RT		~~1~~	~~30~~	~~18~~	~~3.75~~			SIGN INSTALLED BY OTHERS PRIOR TO CONSTRUCTION																									SIGN ID CODE I-13A PROPOSED SIGN TO BE MOUNTED ON EXISTING RAILROAD SIGNAL CABINET		120	
												LF	LF	LF	LF	LF ~~14~~	LF		EA	LB	LB	LB		LB	LB	LB	LB									
	TOTALS				SF 36.50	SF	EA.	SF				LF			LF ~~14~~ 50.79					LB			EA.	LB				EA.	EA.	LB						

FINAL POST LENGTHS ARE TO BE DETERMINED IN THE FIELD. POST SIZES ARE COMPUTED BASED ON INFORMATION FURNISHED ON THE STANDARD SHEETS AND THE VTRANS "SIGN POST DESIGN GUIDELINE."

TRAFFIC SIGN SUMMARY SHEET #20

PROJECT NAME: RUTLAND CITY - PROCTOR
PROJECT NUMBER: STP 2728(1)

FILE NAME: p07d282.dgn
PROJECT LEADER: D.E.G.
DESIGNED BY: L.M.B.
IPARM FILE: p07d282tss20.l

PLOT DATE: 7/19/2013
DRAWN BY: W.G.P.
CHECKED BY: J.P.S.
SHEET 99 OF 392

FILE NAME = U:\17762\CADD\MSTN\STP 2728\p07d282_tss_20.dgn
DATE/TIME = 7/19/2013
USER = 4916