STATE OF VERMONT
AGENCY OF TRANSPORTATION

TRAFFIC SIGN SUMMARY SHEET 25

MILEMARKER, STATION, OR SIGN NUMBER	SIGN LEGEND	SIGN DIMENSIONS EA	WIDTH (In)	HEIGHT (In)	NEW & SALVAGED SIGNS "A"	"B"	SALV SIGN	SALV TIS	EXIST POST RETAIN	EXIST POST SALVAGE	NEW SIGN POSTS NO. OF POSTS	FLANGED CHANNEL lb/ft 1.12	2.0	3.0	SQUARE STEEL (In) lb/ft 1.75 1.88	2.0 2.42	2.5 3.35	ANCHOR	SLEEVE	TUBULAR ALUMINUM Ø (In) lb/ft 3.0 1.3	4.0 1.7	4.0 MOD 1.7	TUBULAR STEEL Ø (In) FOUND-ATION	lb/ft 3.0 7.6	3.5 9.0	4.0 10.8	5.0 14.6	W-SHAPE STEEL FTG. SIZE 24"	30"	WEIGHT	POST SIZE	SIGN REMOVED	REMARKS SHS = FHWA STANDARD HIGHWAY SIGNS BOOK	SIGN DETAIL DETAIL IN SHS	DETAIL ON DWG. NUMBER	STD. SHEET NUMBER
PROCTOR VT. ROUTE 3: 122+61.0, LT	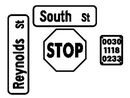	1 1	36 30	8 8	2.00 1.67						1					X 10.25		X 4																DOUBLE SIDED SIGN, SIGN ID CODE D3-1 DOUBLE SIDED SIGN, SIGN ID CODE D3-1 TOP MOUNTING BRACKET REQUIRED TO INSTALL SIGN ON POST. COSTS ASSOCIATED WITH THIS BRACKET ARE INCIDENTAL TO THE SIGN POST.		121 121	
		1 1	30 6	30 10	6.25 0.42																												BACK-TO-BACK SIGN ID CODE R1-1 SIGN ID CODE VD-700	X		E-138
122+83.0, RT		1	24	30	5.00						1					X 9.25		X 4																SIGN ID CODE R2-1	X		
128+98.0, RT							2				1					X 8.50		X 4																SALVAGED SIGNS TO BE MOUNTED ON NEW POST.	-	-	-
		1	6	10	0.42																												SIGN ID CODE VD-700			E-138
133+23 LT	HIDDEN DRIVE						1				1					X 9.00		X 4																			
134+00.0, LT		1	24	30	5.00						1					X 9.00		X 4																SIGN ID CODE R2-1	X		
		1	6	10	0.42																												SIGN ID CODE VD-700			E-138
135+90.0, RT		1	30	30	6.25						1					X 10.75		X 4																SIGN ID CODE W11-2 SIGN SHALL HAVE A FLUORESCENT YELLOW GREEN BACKGROUND	X		
	AHEAD	1	24	12	2.00																												SIGN ID CODE W16-9P SIGN SHALL HAVE A FLUORESCENT YELLOW GREEN BACKGROUND	X		
133+23 LT	VT MARBLE MUSEUM OMYA MAPLE MUSEUM						3				1					X 9.00		X 4																			
FINAL POST LENGTHS ARE TO BE DETERMINED IN THE FIELD. POST SIZES ARE COMPUTED BASED ON INFORMATION FURNISHED ON THE STANDARD SHEETS AND THE VTRANS "SIGN POST DESIGN GUIDELINE."												LF	LF	LF	LF	LF ~~70~~	LF		EA	LB	LB	LB	EA.	LB	LB	LB	LB	EA.	EA.	LB						
	TOTALS				SF 29.43	SF	EA. ~~2~~ 6	SF				LF			LF		~~70~~ 93.75			LB			EA.	LB				EA.	EA.	LB						

TRAFFIC SIGN SUMMARY SHEET #25

PROJECT NAME: RUTLAND CITY - PROCTOR
PROJECT NUMBER: STP 2728(I)

FILE NAME: p07d282.dgn
PROJECT LEADER: D.E.G.
DESIGNED BY: L.M.B.
IPARM FILE: p07d282tss25.I
PLOT DATE: 7/19/2013
DRAWN BY: W.G.P.
CHECKED BY: J.P.S.
SHEET 104 OF 392

FILE NAME = U:\1776\CADD\MISTN\STP 2728\p07d282_tss_25.dgn
DATE/TIME = 7/19/2013
USER = 4416