646.406 DURABLE 4 INCH WHITE LINE, RECESSED POLYUREA
(ALL LINES WILL INCLUDE EDGE LINE BREAKS AND RADIUS FOR TOWN HIGHWAYS)
U.S. ROUTE 4:
STA 37+00.00 - STA 43+00.00 EDGE LINE LT & RT
STA 37+00.00 - STA 43+00.00 DASHED LANE LINE LT
STA 37+00.00 - STA 43+00.00 DASHED LANE LINE RT

646.602 TEMPORARY 4 INCH WHITE LINE, PAINT
(ALL LINES WILL INCLUDE EDGE LINE BREAKS AND RADIUS FOR TOWN HIGHWAYS)
U.S. ROUTE 4:
STA 37+00.00 - STA 43+00.00 EDGE LINE LT & RT
STA 37+00.00 - STA 43+00.00 DASHED LANE LINE LT
STA 37+00.00 - STA 43+00.00 DASHED LANE LINE RT

646.416 DURABLE 4 INCH YELLOW LINE, RECESSED POLYUREA
(ALL LINES WILL INCLUDE C/L BREAKS FOR TOWN HIGHWAYS)
U.S. ROUTE 4:
STA 37+00.00 - STA 43+00.00 DOUBLE SOLID CL
STA 37+75.20 DOUBLE SOLID LT, TEMPLE STREET

646.612 TEMPORARY 4 INCH YELLOW LINE, PAINT
(ALL LINES WILL INCLUDE C/L BREAKS FOR TOWN HIGHWAYS)
U.S. ROUTE 4:
STA 37+00.00 - STA 43+00.00 DOUBLE SOLID CL
STA 37+75.20 DOUBLE SOLID LT, TEMPLE STREET

646.487 DURABLE 24 INCH STOP BAR, RECESSED TYPE I TAPE
U.S. ROUTE 4:
STA 37+75.20 LT, TEMPLE STREET

646.682 TEMPORARY 24 INCH STOP BAR, PAINT
U.S. ROUTE 4:
STA 37+75.20 LT, TEMPLE STREET

646.491 DURABLE LETTER OR SYMBOL, TYPE I TAPE
U.S. ROUTE 4:
STA 37+75.20 LT, TEMPLE STREET, "S,T,O,P" (4 EA)

646.692 TEMPORARY LETTER OR SYMBOL, PAINT
U.S. ROUTE 4:
STA 37+75.20 LT, TEMPLE STREET, "S,T,O,P" (8 EA)

646.501 DURABLE CROSSWALK MARKING, TYPE I TAPE
U.S. ROUTE 4:
STA 37+75.20 LT, TEMPLE STREET

646.702 TEMPORARY CROSSWALK MARKING, PAINT
U.S. ROUTE 4:
STA 37+75.20 LT, TEMPLE STREET

675.50 REMOVING SIGNS
AS SHOWN - 9

VT STATE PLANE GRID

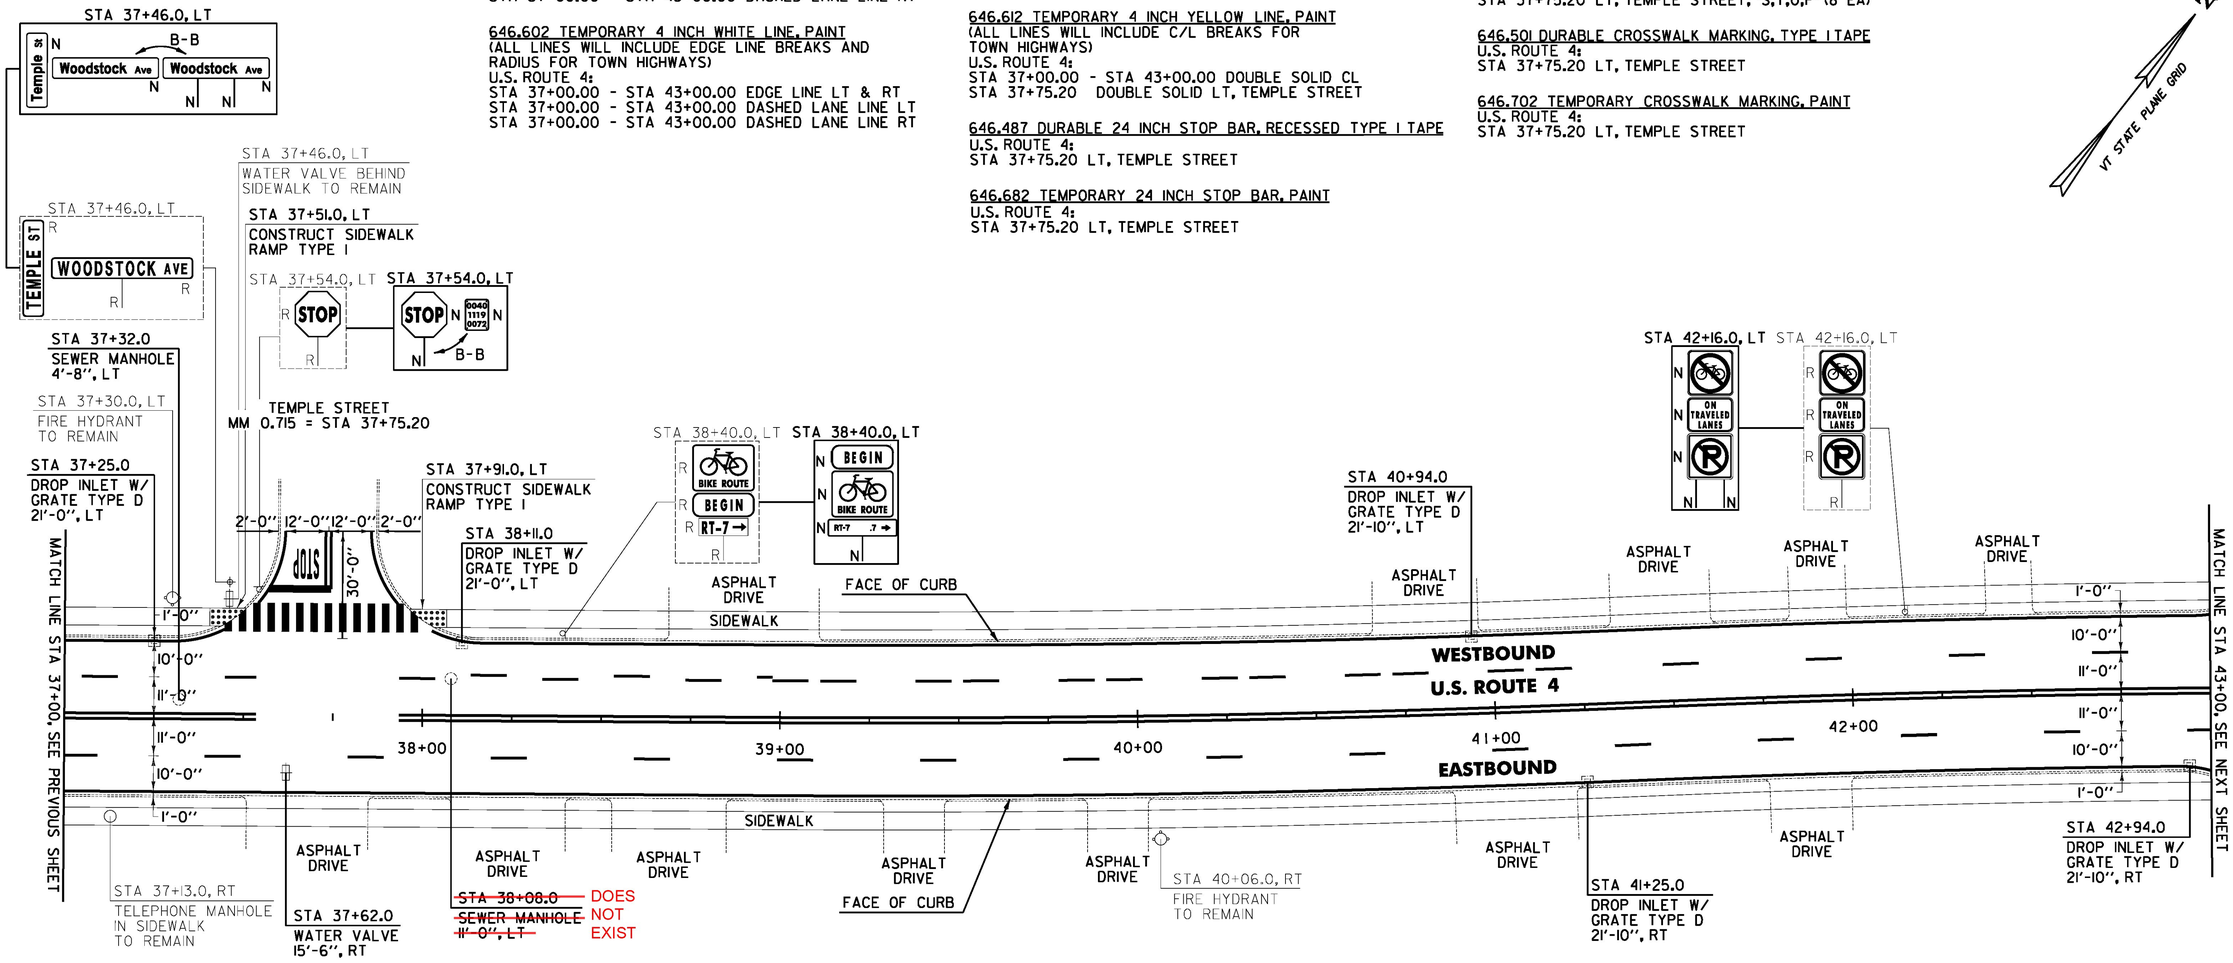

604.412, 604.415, 604.418 REHAB. DROP INLETS, CATCH BASINS, OR MANHOLES, CLASS I, II, OR III (SEE NOTE 1)
U.S. ROUTE 4:
STA 37+25.0 LT
STA 38+11.0 LT
STA 40+94.0 LT
STA 41+25.0 RT
STA 42+94.0 RT

604.42 CHANGING ELEVATION OF SEWER MANHOLES
U.S. ROUTE 4:
STA 37+32.0 LT
STA 38+08.0 LT

616.28 CAST-IN-PLACE CONCRETE CURB, TYPE B
U.S. ROUTE 4:
STA 37+51.0 LT (14.0 LF)
STA 37+91.0 LT (14.0 LF)

618.10 PORTLAND CEMENT CONCRETE SIDEWALK, 5 INCH
U.S. ROUTE 4:
STA 37+51.0 LT (6.7 SY)
STA 37+91.0 LT (6.7 SY)

618.30 DETECTABLE WARNING SURFACE
U.S. ROUTE 4:
STA 37+51.0 LT (10.0 SF)
STA 37+91.0 LT (10.0 SF)

629.20 ADJUST ELEVATION OF VALVE BOX
U.S. ROUTE 4:
STA 37+62.0 RT

SIGN LEGEND
R = REMOVE
S = SALVAGE
N = NEW
RET = RETAIN
B-B = BACK TO BACK
EXISTING = ----------
NEW = ——————
Ⓘ = RETURN TO THE CITY OF RUTLAND

NOTE:
1. THE CONTRACTOR SHALL REHABILITATE THE EXISTING DROP INLETS, CATCH BASINS OR MANHOLES TO A DEPTH AS DIRECTED BY THE ENGINEER. ALL REHABILITATION WORK WILL BE PAID FOR UNDER THE APPLICABLE REHABILITATION ITEM AS DIRECTED BY THE ENGINEER. ALL EXISTING UTILITIES MARKED "TO REMAIN" SHALL NOT BE ALTERED OR REHABILITATED UNLESS DIRECTED OTHERWISE BY THE ENGINEER.

PROJECT LAYOUT SHEET #21 ALTERNATE A

PROJECT NAME: RUTLAND CITY
PROJECT NUMBER: NH 2716(1)
FILE NAME: p07d188.dgn
PROJECT LEADER: D.E.G.
DESIGNED BY: M.J.M.
IPARM FILE: 07d188121.1
PLOT DATE: 7/19/2013
DRAWN BY: W.G.P.
CHECKED BY: D.E.G.
SHEET 179 OF 392

FILE NAME = U:\1762\CADD\MSTN\NH 2716\07d188.bdr_ru_21.dgn
DATE/TIME = 7/19/2013
USER = 4916