STATE OF VERMONT
AGENCY OF TRANSPORTATION

TRAFFIC SIGN SUMMARY SHEET 14

MILEMARKER, STATION, OR SIGN NUMBER	SIGN LEGEND	SIGN DIMENSIONS EA	SIGN DIMENSIONS WIDTH (in)	SIGN DIMENSIONS HEIGHT (in)	NEW & SALVAGED SIGNS "A"	NEW & SALVAGED SIGNS "B"	SALV SIGN	SALV TIS	EXIST POST RETAIN	EXIST POST SALVAGE	NO. OF POSTS	FLANGED CHANNEL lb/ft 1.12	FLANGED CHANNEL lb/ft 2.0	FLANGED CHANNEL lb/ft 3.0	SQUARE STEEL (in) 1.75 lb/ft 1.88	SQUARE STEEL (in) 2.0 lb/ft 2.42	SQUARE STEEL (in) 2.5 lb/ft 3.35	ANCHOR	SLEEVE	TUBULAR ALUMINUM Ø (in) 3.0 lb/ft 1.3	TUBULAR ALUMINUM Ø (in) 4.0 lb/ft 1.7	TUBULAR ALUMINUM Ø (in) 4.0 MOD lb/ft 1.7	FOUNDATION	TUBULAR STEEL Ø (in) 3.0 lb/ft 7.6	TUBULAR STEEL Ø (in) 3.5 lb/ft 9.0	TUBULAR STEEL Ø (in) 4.0 lb/ft 10.8	TUBULAR STEEL Ø (in) 5.0 lb/ft 14.6	W-SHAPE STEEL FTG. SIZE 24"	W-SHAPE STEEL FTG. SIZE 30"	W-SHAPE STEEL WEIGHT	W-SHAPE STEEL POST SIZE	SIGN FRAME REQUIRED	REMARKS (SHS = FHWA STANDARD HIGHWAY SIGNS BOOK)	SIGN DETAIL: DETAIL IN SHS	SIGN DETAIL: DETAIL ON DWG. NUMBER	SIGN DETAIL: STD. SHEET NUMBER
U.S. ROUTE 7: 68+10.0, RT	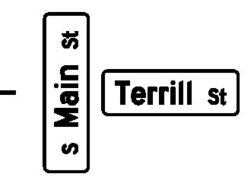	1 1	42 36	12 12	3.50 3.00						1					X 6.75		X 4															DOUBLE SIDED SIGN, SIGN ID CODE D3-1. DOUBLE SIDED SIGN, SIGN ID CODE D3-1. TOP MOUNTING BRACKET REQUIRED TO INSTALL SIGN ON NEW POST. COSTS ASSOCIATED WITH THIS BRACKET ARE INCIDENTAL TO THE SIGN POST.		239 240	
68+12.0, RT		1 1	12 12	18 18	1.50 1.50											X 8.00		X 4															BACK-TO-BACK SIGN ID CODE R9-5 SIGN ID CODE R9-7	X X		
												LF	LF	LF	LF	LF ~~14~~	LF	(hatched)	EA.	LB	LB	LB		LB	LB	LB	LB									
TOTALS					SF 9.50	SF	EA.	SF	(hatched)	(hatched)	(hatched)	LF			LF ~~14~~ 22.75					LB			EA.	LB				EA.	EA.	LB						

FINAL POST LENGTHS ARE TO BE DETERMINED IN THE FIELD. POST SIZES ARE COMPUTED BASED ON INFORMATION FURNISHED ON THE STANDARD SHEETS AND THE VTRANS "SIGN POST DESIGN GUIDELINE."

TRAFFIC SIGN SUMMARY SHEET #14

PROJECT NAME: RUTLAND CITY
PROJECT NUMBER: NH 2716(1)

FILE NAME: p07d188.dgn
PROJECT LEADER: D.E.G.
DESIGNED BY: M.J.M.
IPARM FILE: 07d188tss14.1

PLOT DATE: 7/19/2013
DRAWN BY: W.G.P.
CHECKED BY: D.E.G.
SHEET 209 OF 392

FILE NAME = U:\17762\CADD\MSTN\NH 2716\07d188_tss_14.dgn
DATE/TIME = 7/19/2013
USER = 4916