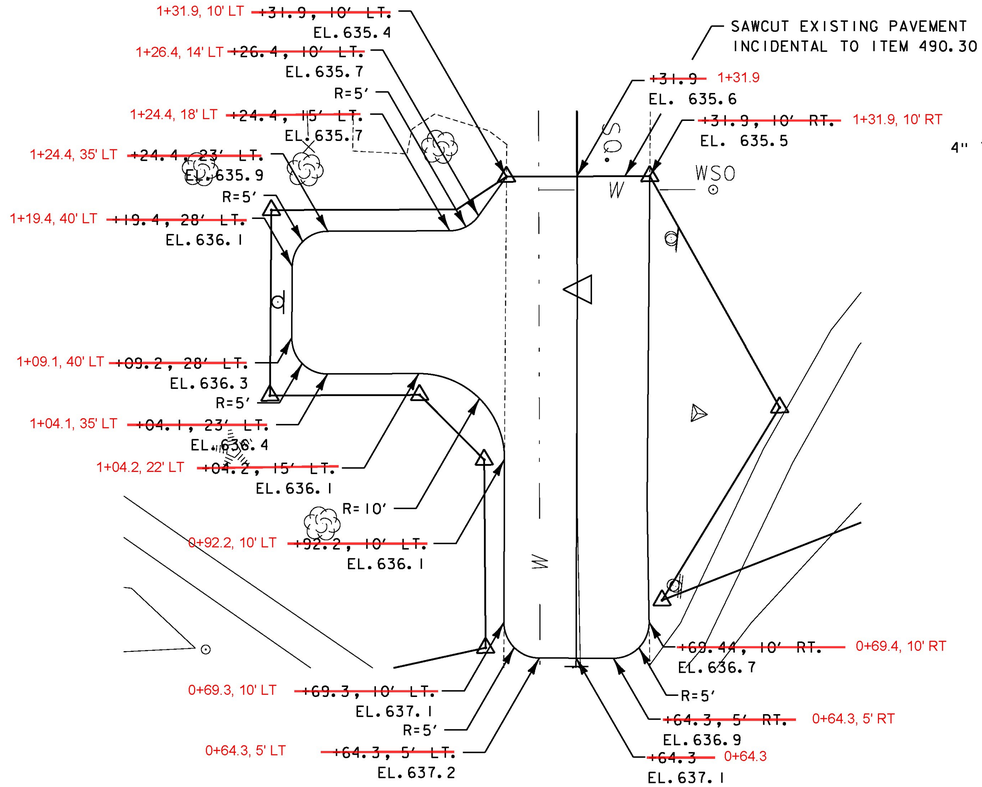

REVISED: 5/10/2014

COURT SQUARE TURNAROUND PLAN

N. T. S.

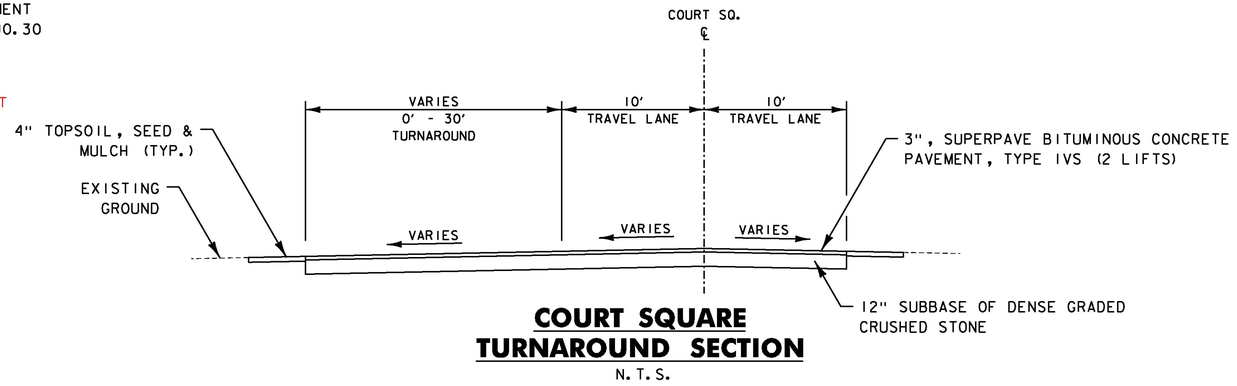

COURT SQUARE TURNAROUND SECTION

N. T. S.

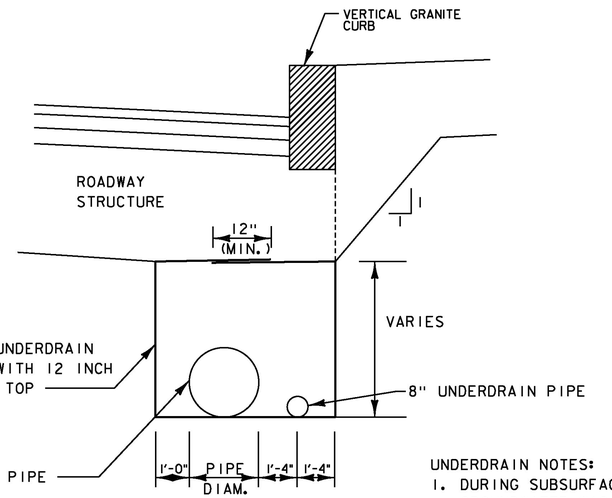

UNDERDRAIN WITH STORM DRAIN PIPE

N. T. S.

UNDERDRAIN NOTES:

1. DURING SUBSURFACE INVESTIGATION, THE PRESENCE OF GROUNDWATER WAS DISCOVERED IN THE PROJECT AREA.
2. WHERE FOUND, GROUNDWATER WAS BETWEEN 5' AND 10' BELOW THE GROUND SURFACE. REFER TO THE PROJECT SPECIFICATIONS FOR THE GEOTECHNICAL ENGINEERING REPORT.
3. SHOULD THE RESIDENT ENGINEER DEEM IT NECESSARY DURING CONSTRUCTION, INSTALL UNDERDRAIN IN THE MANNER ABOVE. UNDERDRAIN TO BE PAID AS ITEM 605.11. ADDITIONAL EXCAVATION REQUIRED TO INSTALL NECESSARY UNDERDRAIN SHALL BE PAID INCIDENTAL TO 605.11.
4. INSTALL FLUSHING BASINS AS REQUIRED BY THE RESIDENT ENGINEER. FLUSHING BASIN TO BE PAID AS ITEM 605.95.
5. FOR UNDERDRAIN OUTLET, FIELD CORE DOWN GRADIENT CATCH BASIN TO MATCH STORM DRAIN INVERT. FIELD CORE TO BE PAID INCIDENTAL TO ITEM 605.95.

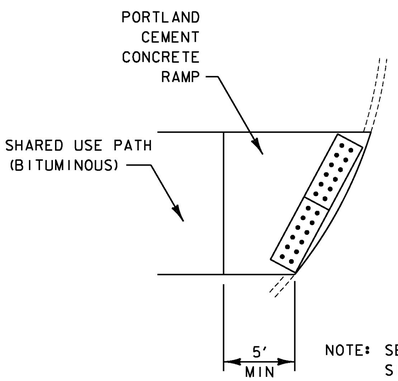

NOTE: SEE PORTLAND CEMENT CONCRETE SIDEWALK DETAIL FOR DEPTHS OF CONCRETE AND SUBBASE.

SU PATH RAMP PLAN (SU PATH ONLY)

N. T. S.

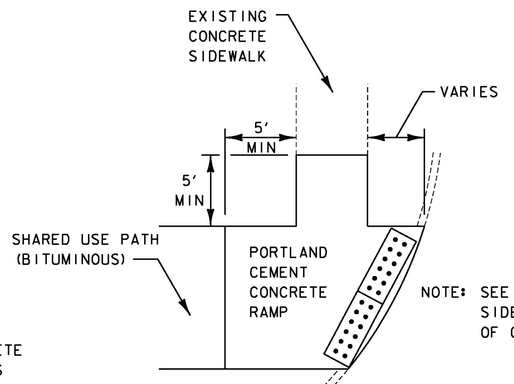

NOTE: SEE PORTLAND CEMENT CONCRETE SIDEWALK DETAIL FOR DEPTHS OF CONCRETE AND SUBBASE.

SU PATH RAMP PLAN (INTERSECTING SW)

N. T. S.

PROJECT NAME:	RUTLAND CITY
PROJECT NUMBER:	STP 019-3(57)
FILE NAME: ...\Trans\PlotFiles\typicals.dgn	PLOT DATE: 7/12/2013
PROJECT LEADER: GAE	DRAWN BY: PZA
DESIGNED BY: TFD	CHECKED BY: GAE
TYPICAL SECTIONS TS-04	SHEET 267 OF 392

Stantec