SPECIAL PROVISION
(SQUARE GRANITE BOLLARD)

STA. 731+34, 32' LT.
STA. 731+38, 32' LT.
STA. 731+42, 46' LT.
STA. 731+53, 65' LT.
STA. 732+22, 68' LT.
STA. 732+41, 50' LT.
STA. 732+45, 38' LT.
STA. 732+50, 39' LT.

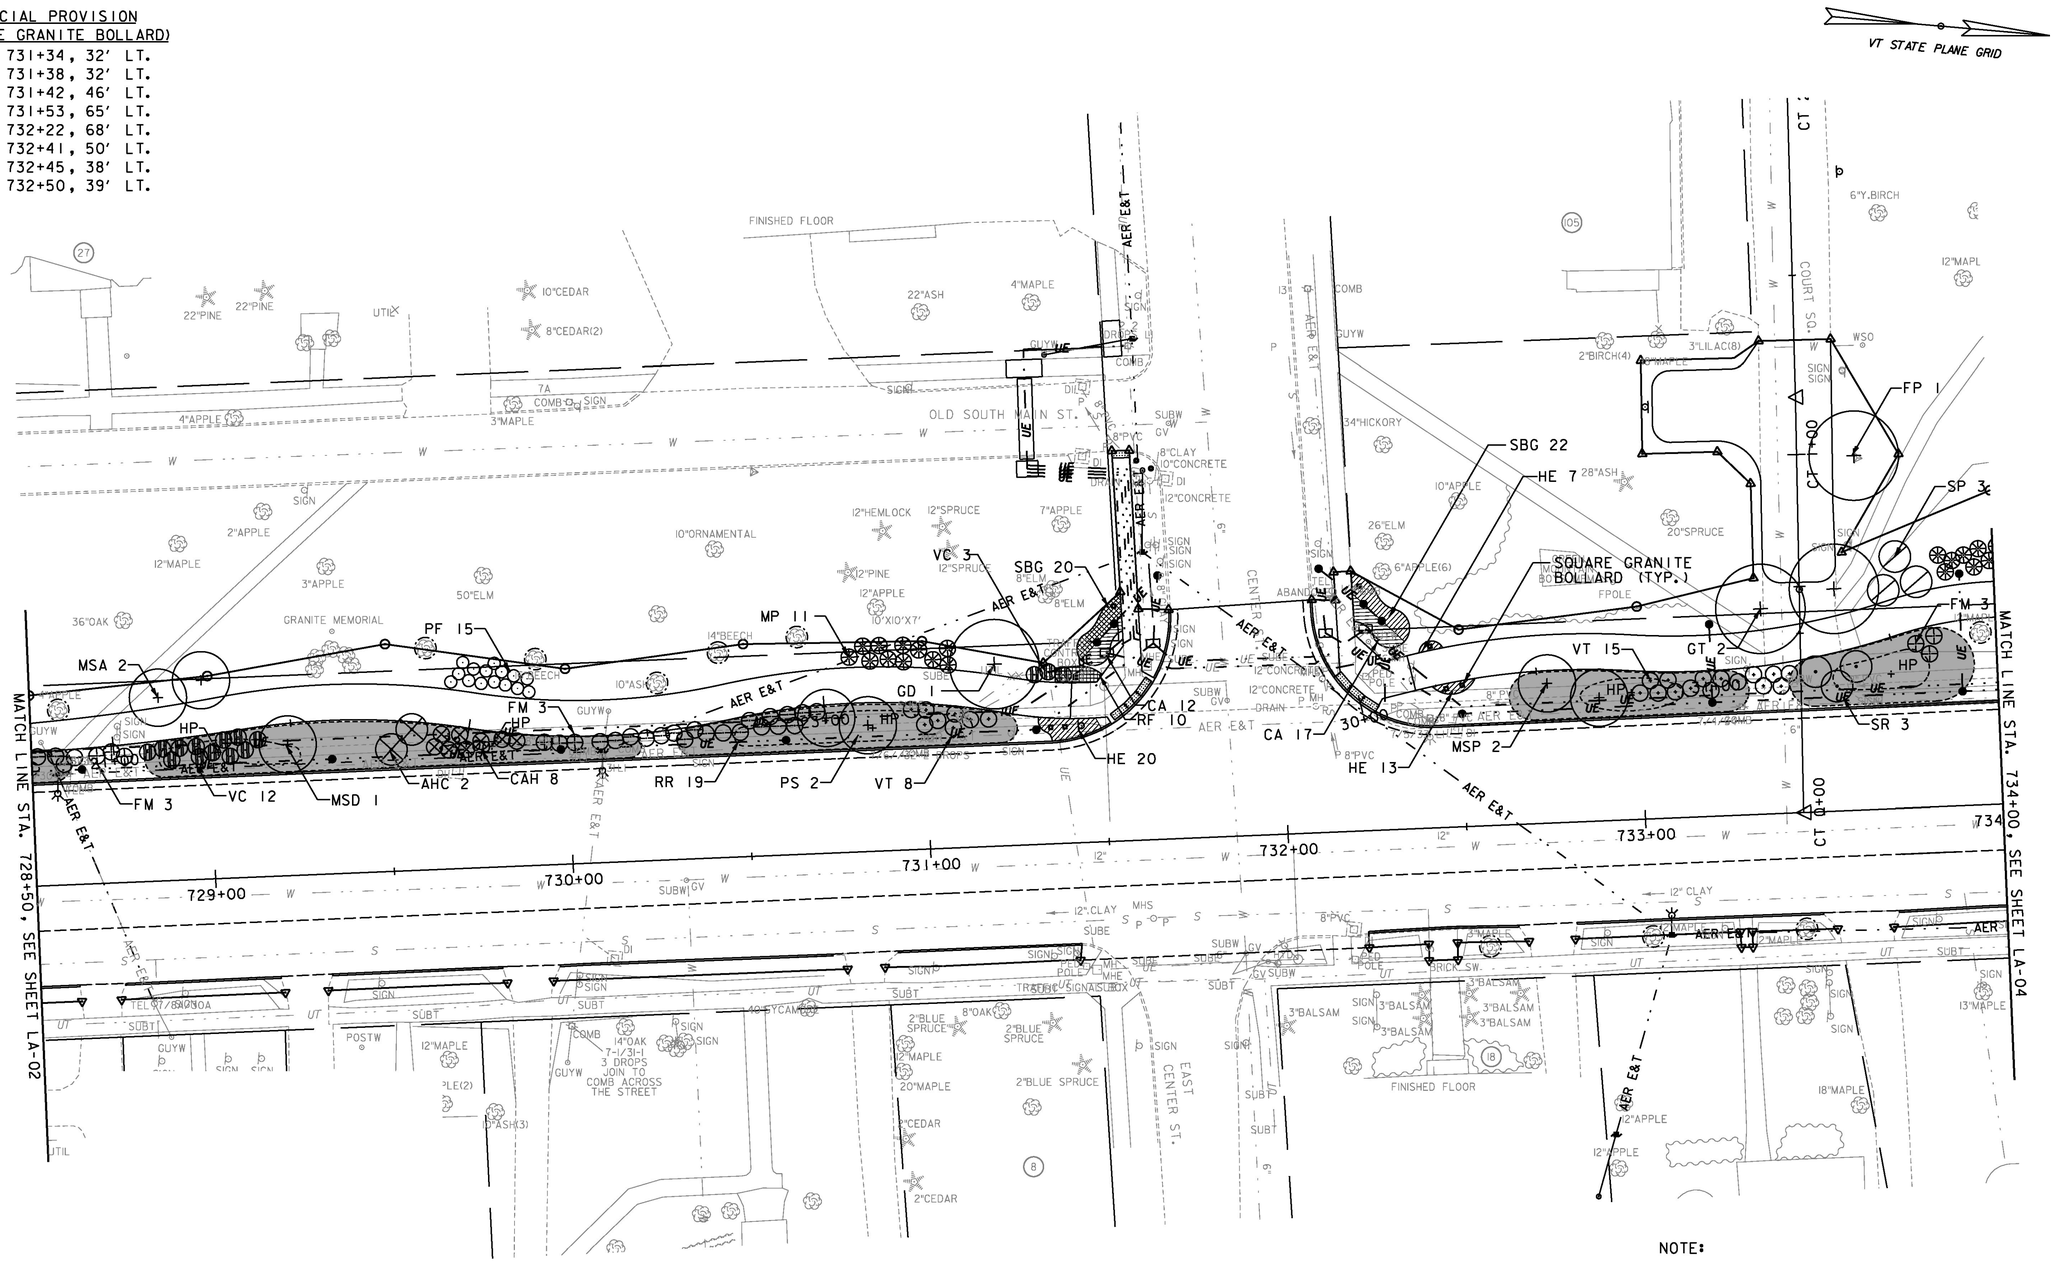

NOTE:

1. FOR LANDSCAPE GENERAL NOTES SEE SHEET LA-01.

0 20 40
SCALE

Stantec

PROJECT NAME: RUTLAND CITY	
PROJECT NUMBER: STP 019-3(57)	
FILE NAME: ...\Trans\PlotFiles\rut_land.dgn	PLOT DATE: 7/12/2013
PROJECT LEADER: GAE	DRAWN BY: PZA
DESIGNED BY: TFD	CHECKED BY: GAE
LANDSCAPE PLAN LA-03	SHEET 368 OF 392