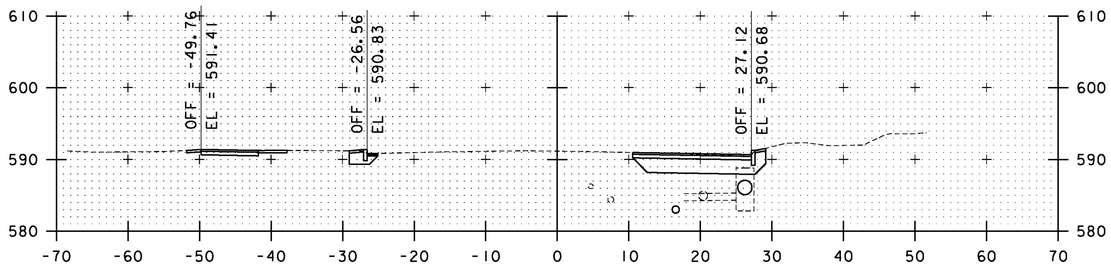

713+50

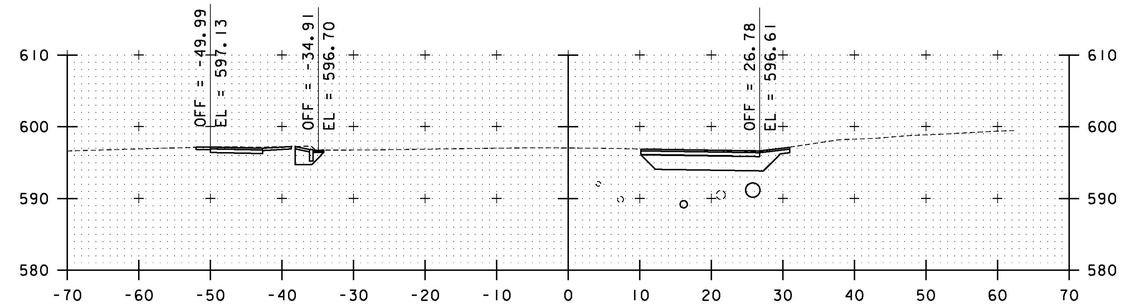

714+36
BIT. DRIVE, RT

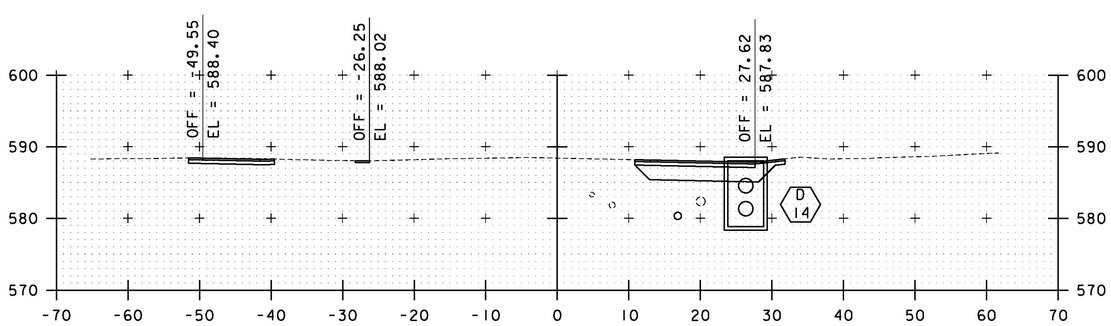

713+10
BIT. DRIVE, LT

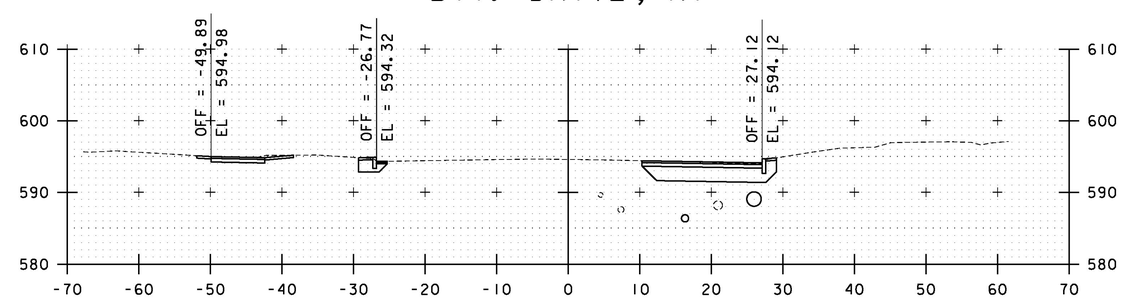

714+00

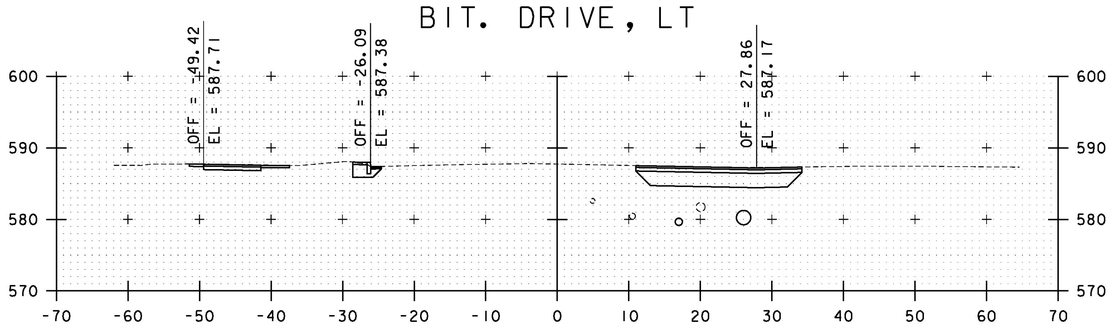

713+00

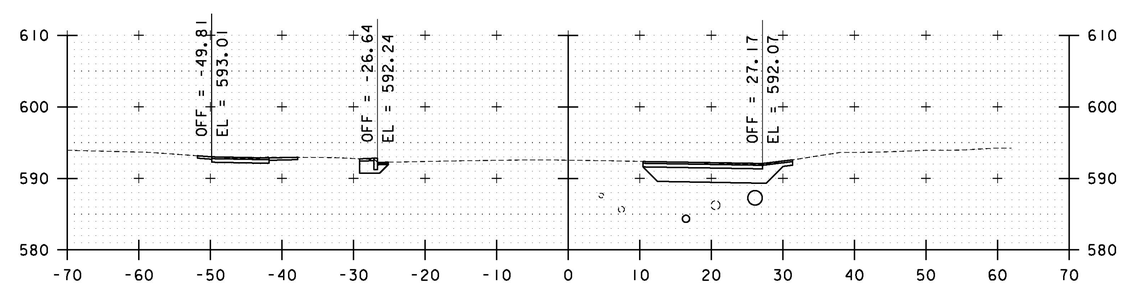

713+70
BIT. DRIVE, RT

STA. 713+00 TO STA. 714+36

0 10 20
SCALE IN FEET

Stantec

PROJECT NAME: RUTLAND CITY
PROJECT NUMBER: STP 019-3(57)

FILE NAME: ...\PlotFiles\rut_sections.dgn
PROJECT LEADER: GAE
DESIGNED BY: TFD
CROSS SECTIONS XS-07

PLOT DATE: 7/12/2013
DRAWN BY: PZA
CHECKED BY: GAE
SHEET 380 OF 392