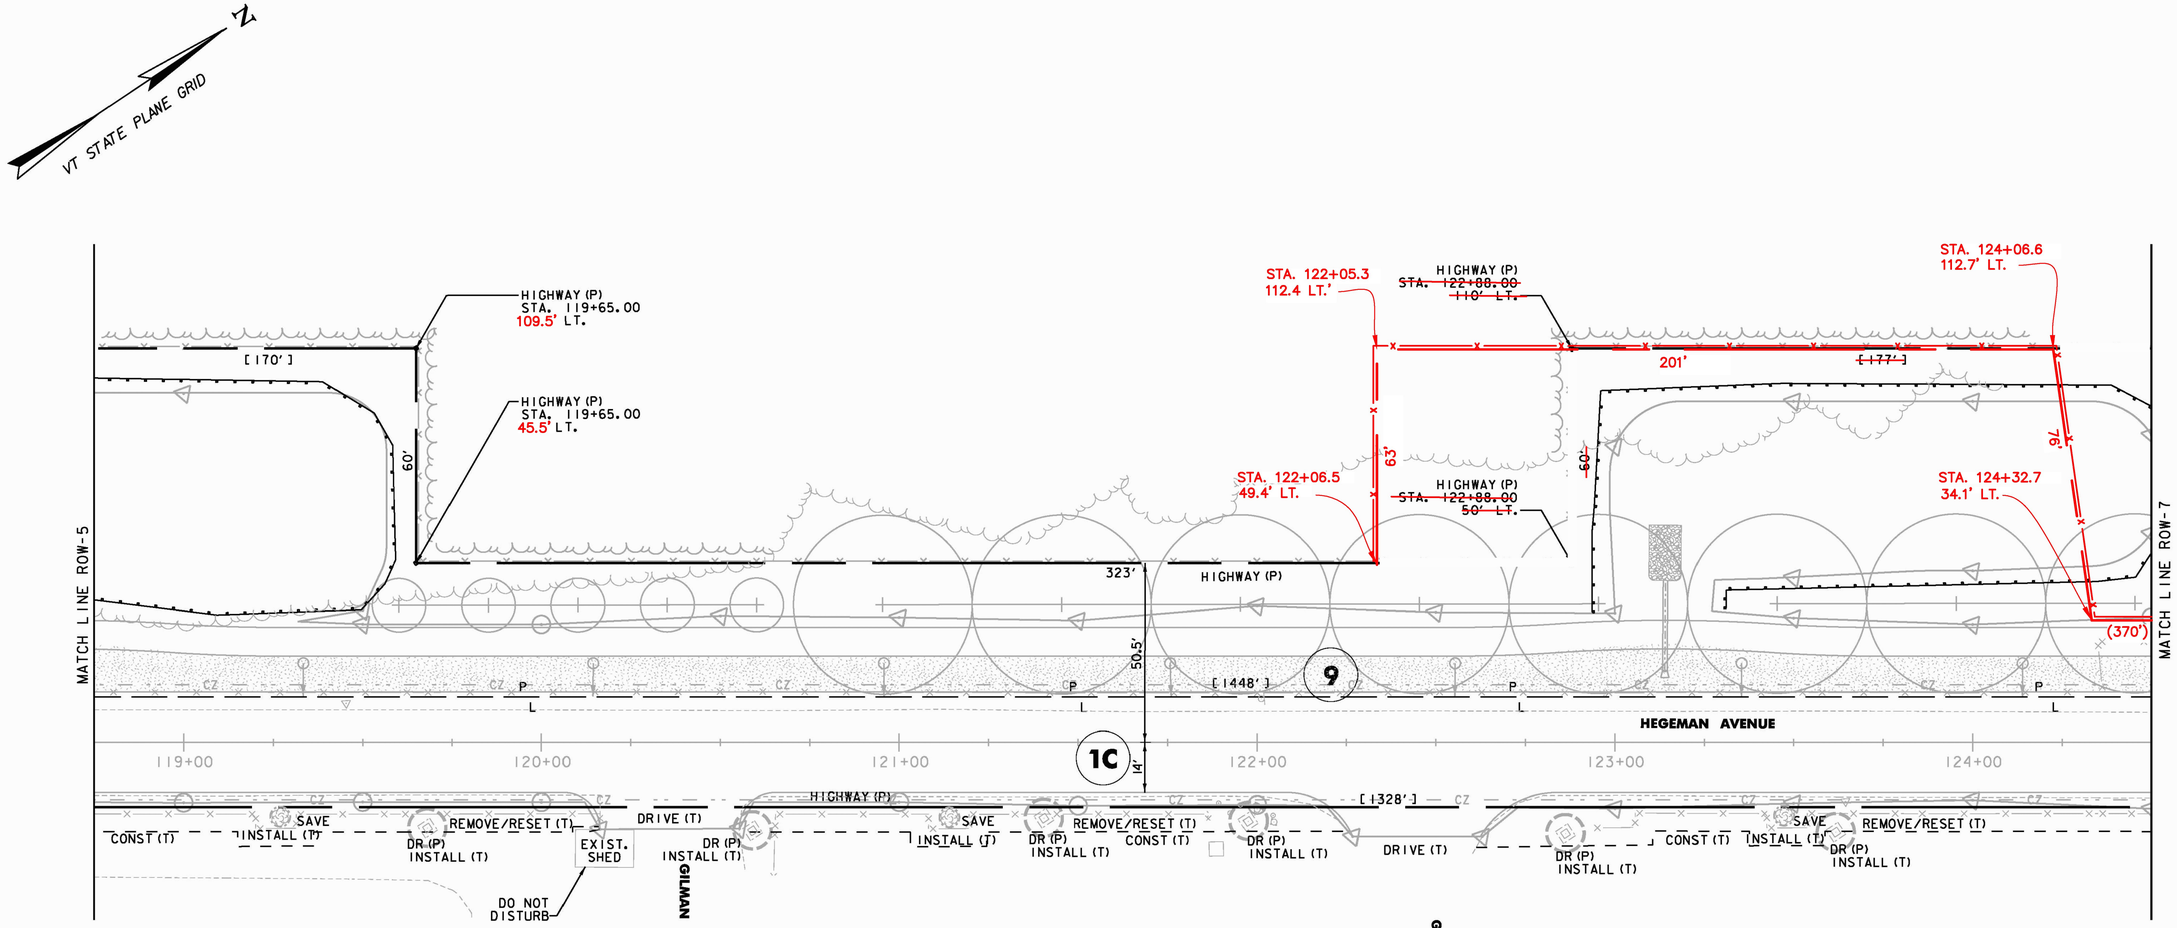

FOR CONSTRUCTION NOTES AND DETAILS SEE ROW SHEET 33 OF 94

FOR DRAINAGE NOTES AND DETAILS SEE ROW SHEET 49 OF 94

FOR EROSION CONTROL NOTES AND DETAILS SEE ROW SHEET 57 OF 94

FOR LANDSCAPING NOTES AND DETAILS SEE ROW SHEET 73 OF 94

FOR LIGHTING NOTES AND DETAILS SEE ROW SHEET 92 OF 94

LINES SHOWN ON THIS PLAN AS EXISTING PROPERTY LINES (P/L) ARE BELIEVED TO BE ACCURATE BUT SHOULD NOT BE RELIED UPON FOR PURPOSES UNRELATED TO THE TOWN OF COLCHESTER, VERMONT'S ACQUISTION OF LAND AND RIGHTS FOR THIS PROJECT.

CONSTRUCT DRIVES

CL STATION	WIDTH	TYPE
120+36, RT.	39.0	BITUMINOUS RESIDENTIAL
122+46, RT.	36.1	BITUMINOUS RESIDENTIAL

EXISTING RIGHT-OF-WAY
TAKING WITH ACCESS
TAKING WITHOUT ACCESS
CZ — CLEAR ZONE
P/L — PROPERTY LINE
TOE OF SLOPE
TOP OF CUT
SR (P) — SLOPE RIGHT
CONST. (T) or (P) — CONSTRUCTION RIGHT

(P)	PERMANENT
(T)	TEMPORARY
DR.	DRAINAGE RIGHT
DIT.	DITCHING RIGHT
CH.	CHANNEL RIGHT
DRIVE	DRIVE RIGHT
CUL.	CULVERT
C&T	CLEARING & TRIMMING
SR	SLOPE RIGHT
UE	UTILITY EASEMENT
SL	STREET LIGHT
HH	HAND HOLE

0 20 40
SCALE

Stantec

RECORD DRAWING
DATE: DECEMBER 21, 2012

PROJECT NAME: COLCHESTER CAMPUS CONNECTOR
PROJECT NUMBER: TCSP TCSE (007)

FILE NAME: ...\030-037_Row plans.ptf
PROJECT LEADER: JBL
DESIGNED BY: STANTEC
ROW PLAN ROW-6

PLOT DATE: 12/2/2010
DRAWN BY: DDH
CHECKED BY: STANTEC
SHEET 35 OF 153