VT STATE PLANE GRID

BITUMINOUS CONCRETE SIDEWALK
LOCATION — WIDTH
STA. 118+75, 30.0' LT - STA. 124+50, 28.0' LT — 8.5'

REMOVAL OF EXISTING FENCE
STA. 118+75, 14.0' LT - STA. 124+50, 28.0' LT

REMOVING AND RESETTING FENCE (WOOD STOCKADE)
~~STA. 118+75, 20.0' RT - STA. 120+16, 24.0' RT~~
~~STA. 120+65, 33.0' RT - STA. 121+87, 22.0' RT~~
~~STA. 122+35, 24.0' RT - STA. 124+50, 20.0' RT~~

SPECIAL PROVISION (CHAIN-LINK FENCE WITH BARBED WIRE, ~~8 FEET~~ 6 FEET) (1)
STA. 118+75, 110.5' LT - STA. 124+50, 110.5 LT

ADJUST ELEVATION OF VALVE BOX

ALIGNMENT	STATION	OFFSET
MAINLINE	121+89.3	16.9' RT
	121+95.4	17.4' RT

SPECIAL PROVISION (SAW CUTTING SURFACES AND PAVEMENTS)
STA. 120+16, 24.0' RT - STA. 120+55, 24.0' RT - 39'
STA. 122+27, 26.0' RT - STA. 122+63, 26.0' RT - 36'

CONSTRUCT DRIVES

CL STATION	WIDTH	TYPE
120+36, RT.	39.0	BITUMINOUS, RESIDENTIAL
122+46, RT.	36.1	BITUMINOUS, RESIDENTIAL

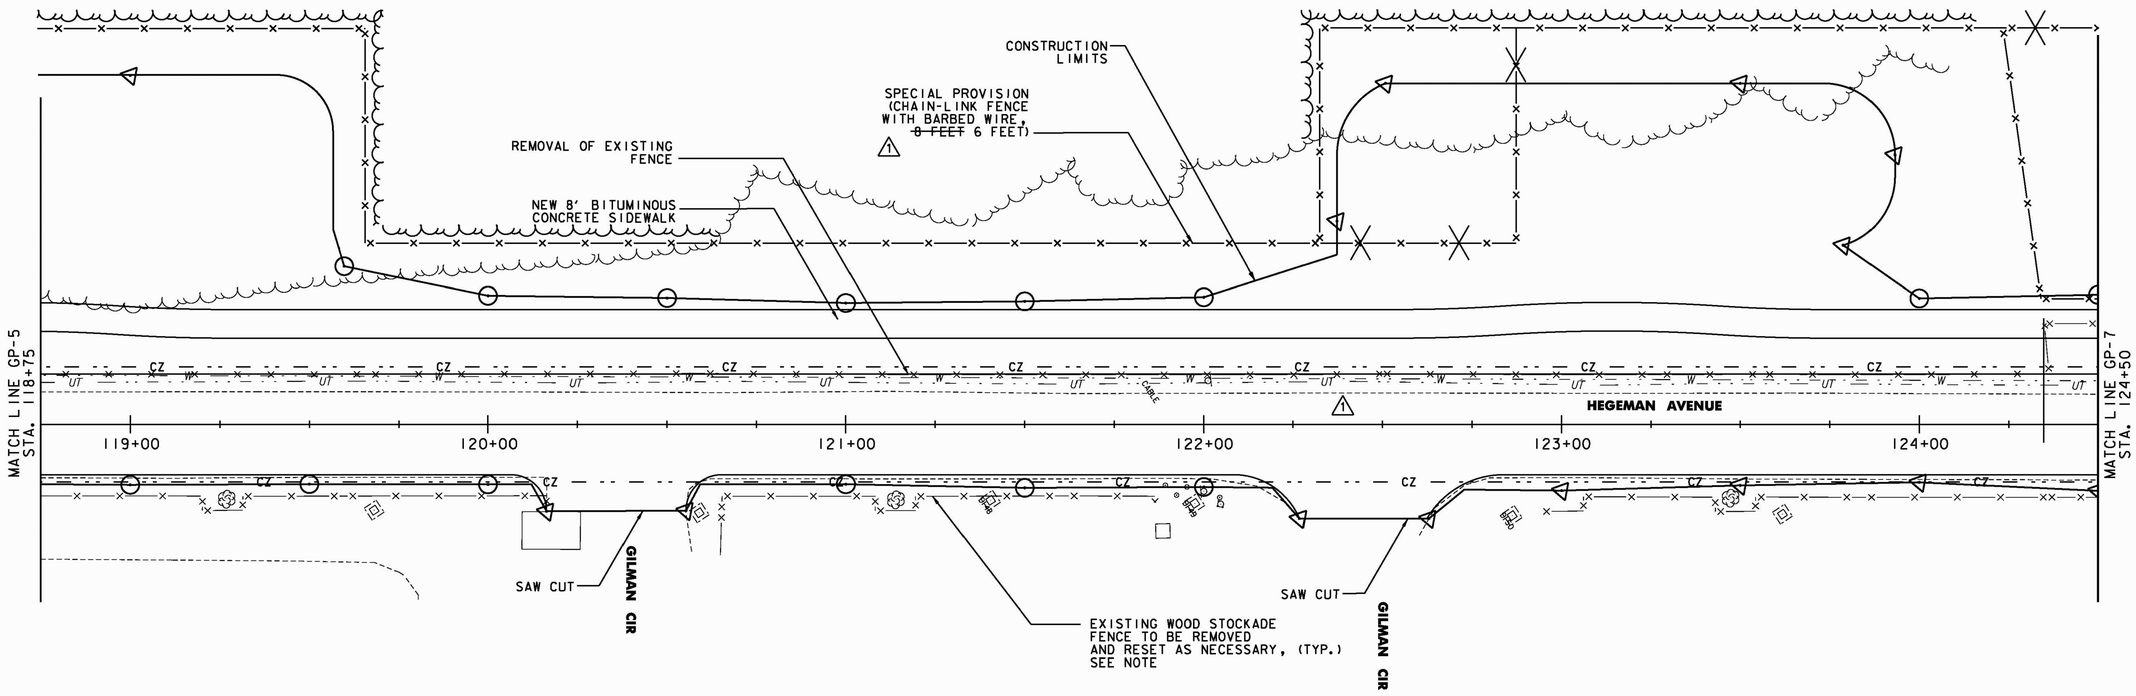

REVISION	BY	DATE
(1) ADDENDUM - 1	JBL	01/24/11

0 20 40
SCALE

Stantec

RECORD DRAWING

DATE: DECEMBER 21, 2012

NOTE:

1. EXISTING WOOD STOCKADE FENCE SHALL BE REMOVED AS NECESSARY TO AVOID DAMAGE DURING CONSTRUCTION. FENCE SHALL BE RESET BACK TO ORIGINAL LOCATION PRIOR TO COMPLETION OF CONSTRUCTION. CONTRACTOR SHALL OBTAIN APPROVAL FROM RESIDENT ENGINEER PRIOR TO REMOVING FENCE.

FIELD CHANGE #3 - SEPTEMBER 2, 2011
MOVED NATIONAL GUARD FENCE, INFILTRATION BASIN AND REVISED CUT/FILL LIMIT

PROJECT NAME: COLCHESTER CAMPUS CONNECTOR
PROJECT NUMBER: TCSP TCSE (007)

FILE NAME: ...\058-065_Gen.ptf — PLOT DATE: 9/7/2011
PROJECT LEADER: JBL — DRAWN BY: PZA
DESIGNED BY: TFD — CHECKED BY: GGG
GENERAL PLAN GP-6 — SHEET 63 OF 155