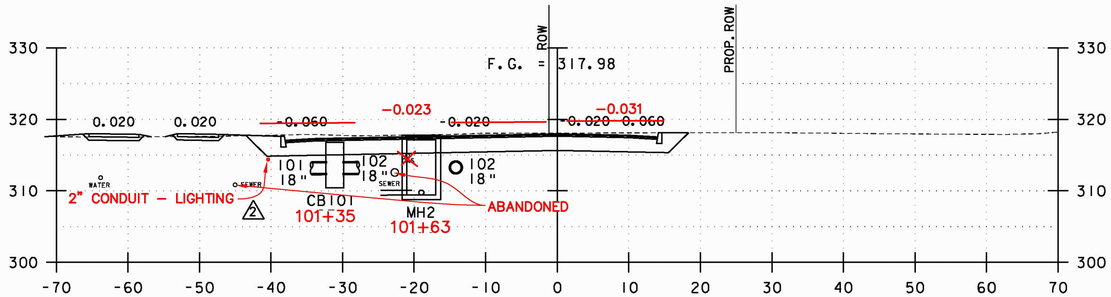

101+50

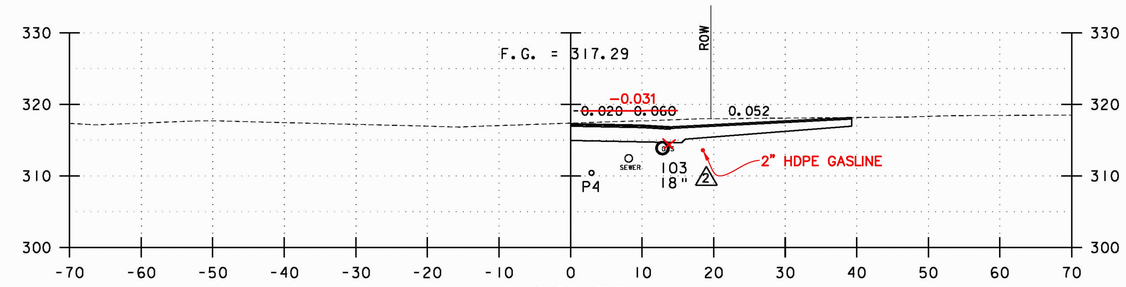

102+72

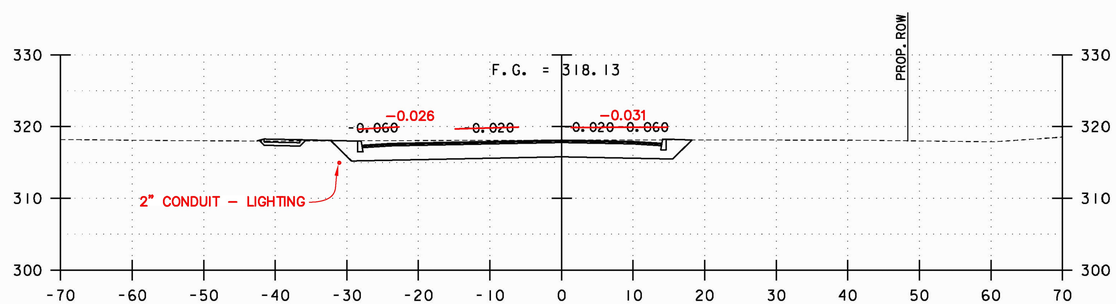

101+00

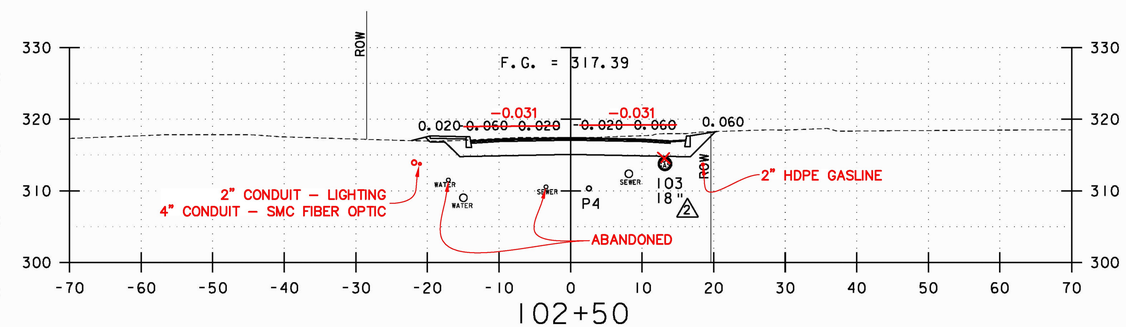

102+50

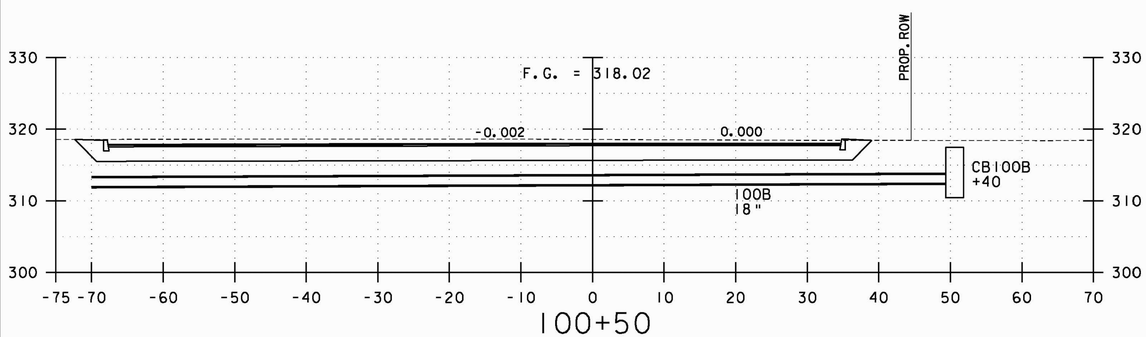

100+50

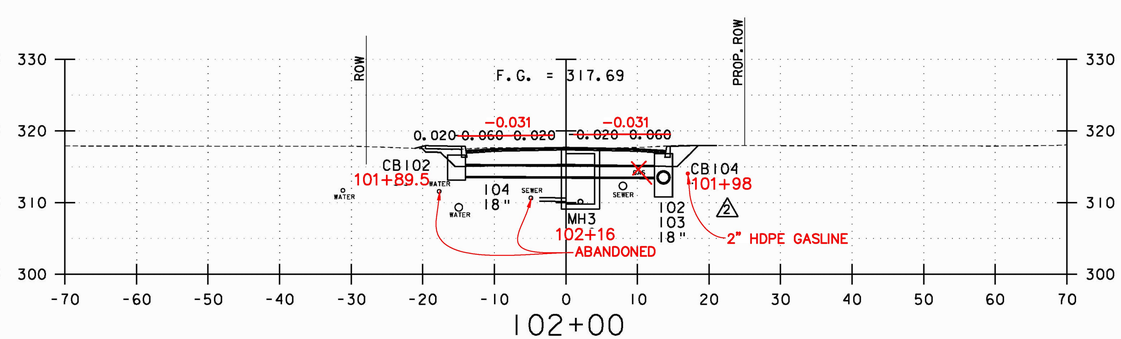

102+00

RECORD DRAWING

DATE: DECEMBER 21, 2012

REVISION	BY	DATE
2 DRAINAGE REV. ADDED WATER LINE	JBL	04/22/11

0 10 20
SCALE

Stantec

PROJECT NAME: COLCHESTER CAMPUS CONNECTOR
PROJECT NUMBER: TCSP TCSE (007)

FILE NAME: ...\plotfiles\132-145_xs.pt f
PROJECT LEADER: JBL
DESIGNED BY: TFD
MAINLINE XS-1

PLOT DATE: 4/22/2011
DRAWN BY: TFD
CHECKED BY: GGG
SHEET 139 OF 153